Roseville Parks and Recreation Renewal Program Rosebrook Park

2590 Fry Street Roseville, Minnesota 55113

2590 Fry Street Roseville, Minnesota 55113

NO SCALE


PROJECT LOCATION MAP

BID SET - JANUARY 21, 2014

SPACES LEGEND

- BUILDING LOCATION - GENERAL AREA - OCCUPANCY TYPE - GROSS SQUARE FEET PER OCCUPANT SPACE GROSS SQUARE FEET - NUMBER OF OCCUPANTS

EGRESS LEGEND

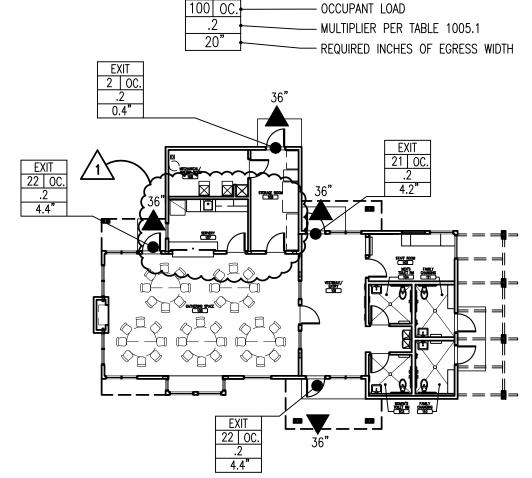

TOTAL OCCUPANTS: 69

PROJECT LOCATION

Little Canada

CODE REVIEW PLAN 1/16" = 1'-0"



BUILDING CODE REVIEW

International Building Code (IBC) - 2006 Edition Minnesota State Building Code - 2007 Edition Minnesota State Accessibility Rules (Chap. 1341) - 2007 Minnesota State Special Fire Protection Systems (Chap. 1306) — 2007 Minnesota State Fire Code - 2007 Edition International Fire Code (IFC) - 2006 Edition International Fuel Gas Code - 2006 Edition National Electrical Code - 2011 Edition Minnesota Commercial Energy Code — Minnesota Rules Chapter 1323 Proposed Project Square Footage Assembly Space(s) 442 GSF Storage/Mechanical/Servery/Staff Room 217 GSF D. Occupancy Classifications (IBC Ch. 3) The proposed building will have the following occupancy types: A3 — Assembly Occupancy E. Building Classifications (IBC Ch.6 and Table 601) F. Allowable Height and Building Area (IBC Table 503) Occupancy Group A3 (Type 5B without automatic sprinkler system - no increases allowed for sprinklering) 6,000 SF allowable per floor, 1-story maximum The proposed building fits within these limits.

H. Construction Requirements (IBC Ch.6, Table 601

Construction type Structural frame Floor Construction Roof Construction

-2 hour construction, if less than 5 feet to property line. 1 hour construction, if than 10 feet to property line, 0 hour if greater than 10' to the property line. No existing walls are less than 10'-0" from the property line.

Building A: 1-Hour Separation with 45 minute fire-rated door at incidental use roor

-Protected less than 10' - not permitted less than 5' to property line. No existing openings are less than 10'-0" from the property line. I. Exit Requirements (IBC Ch. 10, & Tables 1015.1, 1016.1, 1017.1 & 1019.1)

Assembly Occupancies: 2 exits required minimum, if over 49 occupants. Distance between exits -1/2 the diagonal of a non-sprinklered building, as a

Exit configuration complies. Occupancy Load

Total Main Level Occupant Load 69 Total Occupants 927 SF/15 = 62 occupants Assembly Space(s) (1/15 NSF) Ancillary Spaces 659 SF/100 = 7 occupants(Storage/Mechanical/Servery/Staff RM/Toilets) Required Exit Widths (Table 1005.1)

Building has (4) exits with 144" exit width provided

Accessibility (IBC Ch.11 Minnesota State Building Code 2007, Minnesota Rules, Ch. 1341) All spaces shall comply with the IBC and Minnesota Accessibility Code.

Total Exit Width Required = 69 Occupants x . 2 = 13.8 inches

K. Automatic Fire Extinguishing System (IBC Ch.9, Section 903)

For A3 Occupancies, automatic fire protection system is required if floor area is 12,000 SF or has an occupancy of 300 or more per 2006 IBC. Space size and occupancy does not require automatic fire protection system per the

A fire alarm system is not required in A Occupancies with an occupant load less than 300 per 2006 IBC.

The city of Roseville has not adopted MSBC, Minnesota Rules, Chapter 1306 that requires all Assembly (A) Occupancies to be equipped with an automatic fire

Building is not required to have an automatic fire extinguishing system. Plumbing Fixture Requirements (IBC Ch. 29)

Total Occupant Load = 69 Occupants = 34 men and 35 women

Water Closets Required: 1 per 125 occupants. Total required = 1 - (2 provided)Lavatories Required: 1 per 200. Total required = 1 - (2 provided)

Water Closets Required: 1 per 65 occupants. Total required = 1 - (2 provided)Lavatories Required: 1 per 200. Total required = 1 - (2 provided)**Drinking Fountains**

Required: 1 - (2 provided)Service Sinks

Required: 1 - (1 provided)

INDEX TO DRAWINGS

RO-a1.1 Title Sheet and Drawing Index

Civil/Landscape

RO-I1.0 Demolition Plan RO-12.0 Site Plan RO-I3.0 Grading Plan RO-14.0 Planting Plan RO-15.0 Utility Plan

Architectural

RO-a2.1 Floor Plan RO-a2.1i Finishes Floor Plan RO-a2.1fe Furniture and Equipment Floor Plan

RO-a2.2 Roof Plan RO-a3.1 Exterior Elevations

RO-a3.2 Exterior Elevations RO-a4.1 Building Sections

RO-a4.2 Building Sections

RO-a4.3 Wall Sections RO-a4.4 Wall Sections

RO-a7.1 Interior Elevations RO-a7.2 Interior Elevations RO-a9.1 Reflected Ceiling Plan

RO-s1.1 Footing and Foundation Plan RO-s1.2 Roof Framing Plan RO-s2.1 Wall Framing Elevations

RO-s3.1 Sections

Mechanical

RO-m0.1 Mechanical Notes RO-m1.1 HVAC Plan RO-m2.1 Plumbing Plan

RO-m3.1 Mechanical Details, Schedules and Risers

Electrical

RO-e0.1 Electrical Legend and General Notes RO-e1.0 Electrical Site Plan and Details

RO-e2.0 Lighting Plan

RO-e2.1 Power and Aux Plan

RO-e3.0 Electrical Single Line Diagram and Schedules

GENERAL NOTES

1. CONTRACTOR IS RESPONSIBLE FOR ALL WORK NECESSARY TO COMPLETE THE SITE WORK, SITE UTILITIES, DEMOLITION, GENERAL CONSTRUCTION, VENTILATION, PLUMBING, AND ELECTRICAL CONSTRUCTION AS SHOWN ON THESE CONTRACT DOCUMENTS. ITEMS NOT EXPRESSLY SET FORTH BUT WHICH ARE REASONABLY IMPLIED OR NECESSARY FOR THE PROPER PERFORMANCE OF THIS WORK SHALL BE INCLUDED

2. SITE IMPROVEMENTS, INCLUDING EXTENSION OF UTILITIES TO BUILDINGS, ARE TO BE

3. CONTRACTOR IS RESPONSIBLE TO VISIT THE SITE TO VERIFY EXISTING CONDITIONS, REVIEW THE DOCUMENTS AND IDENTIFY ANY DISCREPANCIES. ALL DISCREPANCIES SHALL BE REPORTED TO THE ARCHITECT AT THE TIME OF THE BID.

4. CONTRACTOR IS RESPONSIBLE FOR ALL PERMITS, & APPROVALS NECESSARY FOR COMPLETION OF THE WORK.

5. CONTRACTOR SHALL COORDINATE WITH THE OWNER & ARCHITECT THE LIMITS OF CONSTRUCTION FOR THE BUILDING PRIOR TO BEGINNING THE WORK. AN AREA FOR STAGING OF BUILDING MATERIALS STORAGE, AND EQUIPMENT LOADING/ UNLOADING WILL BE COORDINATED WITH THE OWNER & ARCHITECT. PARKING OF CONSTRUCTION VEHICLES & WORKERS WILL BE RESTRICTED TO DESIGNATED AREAS. VERIFY WITH OWNER.

6. ALL SILT FENCES AND OTHER EROSION CONTROL FEATURES SHALL BE IN PLACE PRIOR TO ANY EXCAVATION / CONSTRUCTION AND BE MAINTAINED UNTIL VIABLE TURF OR GROUND COVER HAS BEEN ESTABLISHED. IT'S EXTREMELY IMPORTANT THAT THE CONTRACTOR BE AWARE OF CURRENT FIELD CONDITIONS WITH RESPECT TO EROSION CONTROL. TEMPORARY PONDING, DIKES, HAY BALES, ETC. REQUIRED BY THE CITY, DNR, COUNTY, ETC. SHALL BE PART OF THIS CONTRACT.



ROSEVILLE PARKS & RECREATION

2660 CIVIC CENTER DRIVE **ROSEVILLE, MINNESOTA 55113**



PERFORMANCE DRIVEN DESIGN.

250 3rd Ave. N, Ste 450 | Minneapolis, MN 55401 | 612.338.2029



HAGEN, CHRISTENSEN & MCILWAIN ARCHITECT \$

4201 CEDAR AVENUE SO. . MINNEAPOLIS, MN 55407 ΓEL. (612)904-1332 • FAX (612)904-7366

I hereby certify that this drawing was prepared by me or under my direct supervision and that I am a duly registered architect under the laws of the State of Minnesota.

Tom Mylmon

TITLE: ARCHITECT DATE: 1/21/14 REG. NO.: 22541

CONSTRUCTION SET 1/21/2014 12/20/2013 90% REVIEW SET 10/07/2013 90% REVIEW SET 9/11/2013 FINAL DESIGN DATE ISSUED FOR

1 07/24/2014

DATE

COPYRIGHT 2014 BY LHB, INC. ALL RIGHTS RESERVED


PROJECT NAME: ROSEVILLE PARKS AND RECREATION RENEWAL PROGRAM

ROSEBROOK PARK 2590 FRY STREET **ROSEVILLE, MINNESOTA 55113**

DRAWING TITLE:

TITLE SHEET AND DRAWING INDEX

FILE: 1353RO-a1.1.dwg DRAWN BY: JRG CHECKED BY: DRL PROJ. NO: 1353 DRAWING NO:

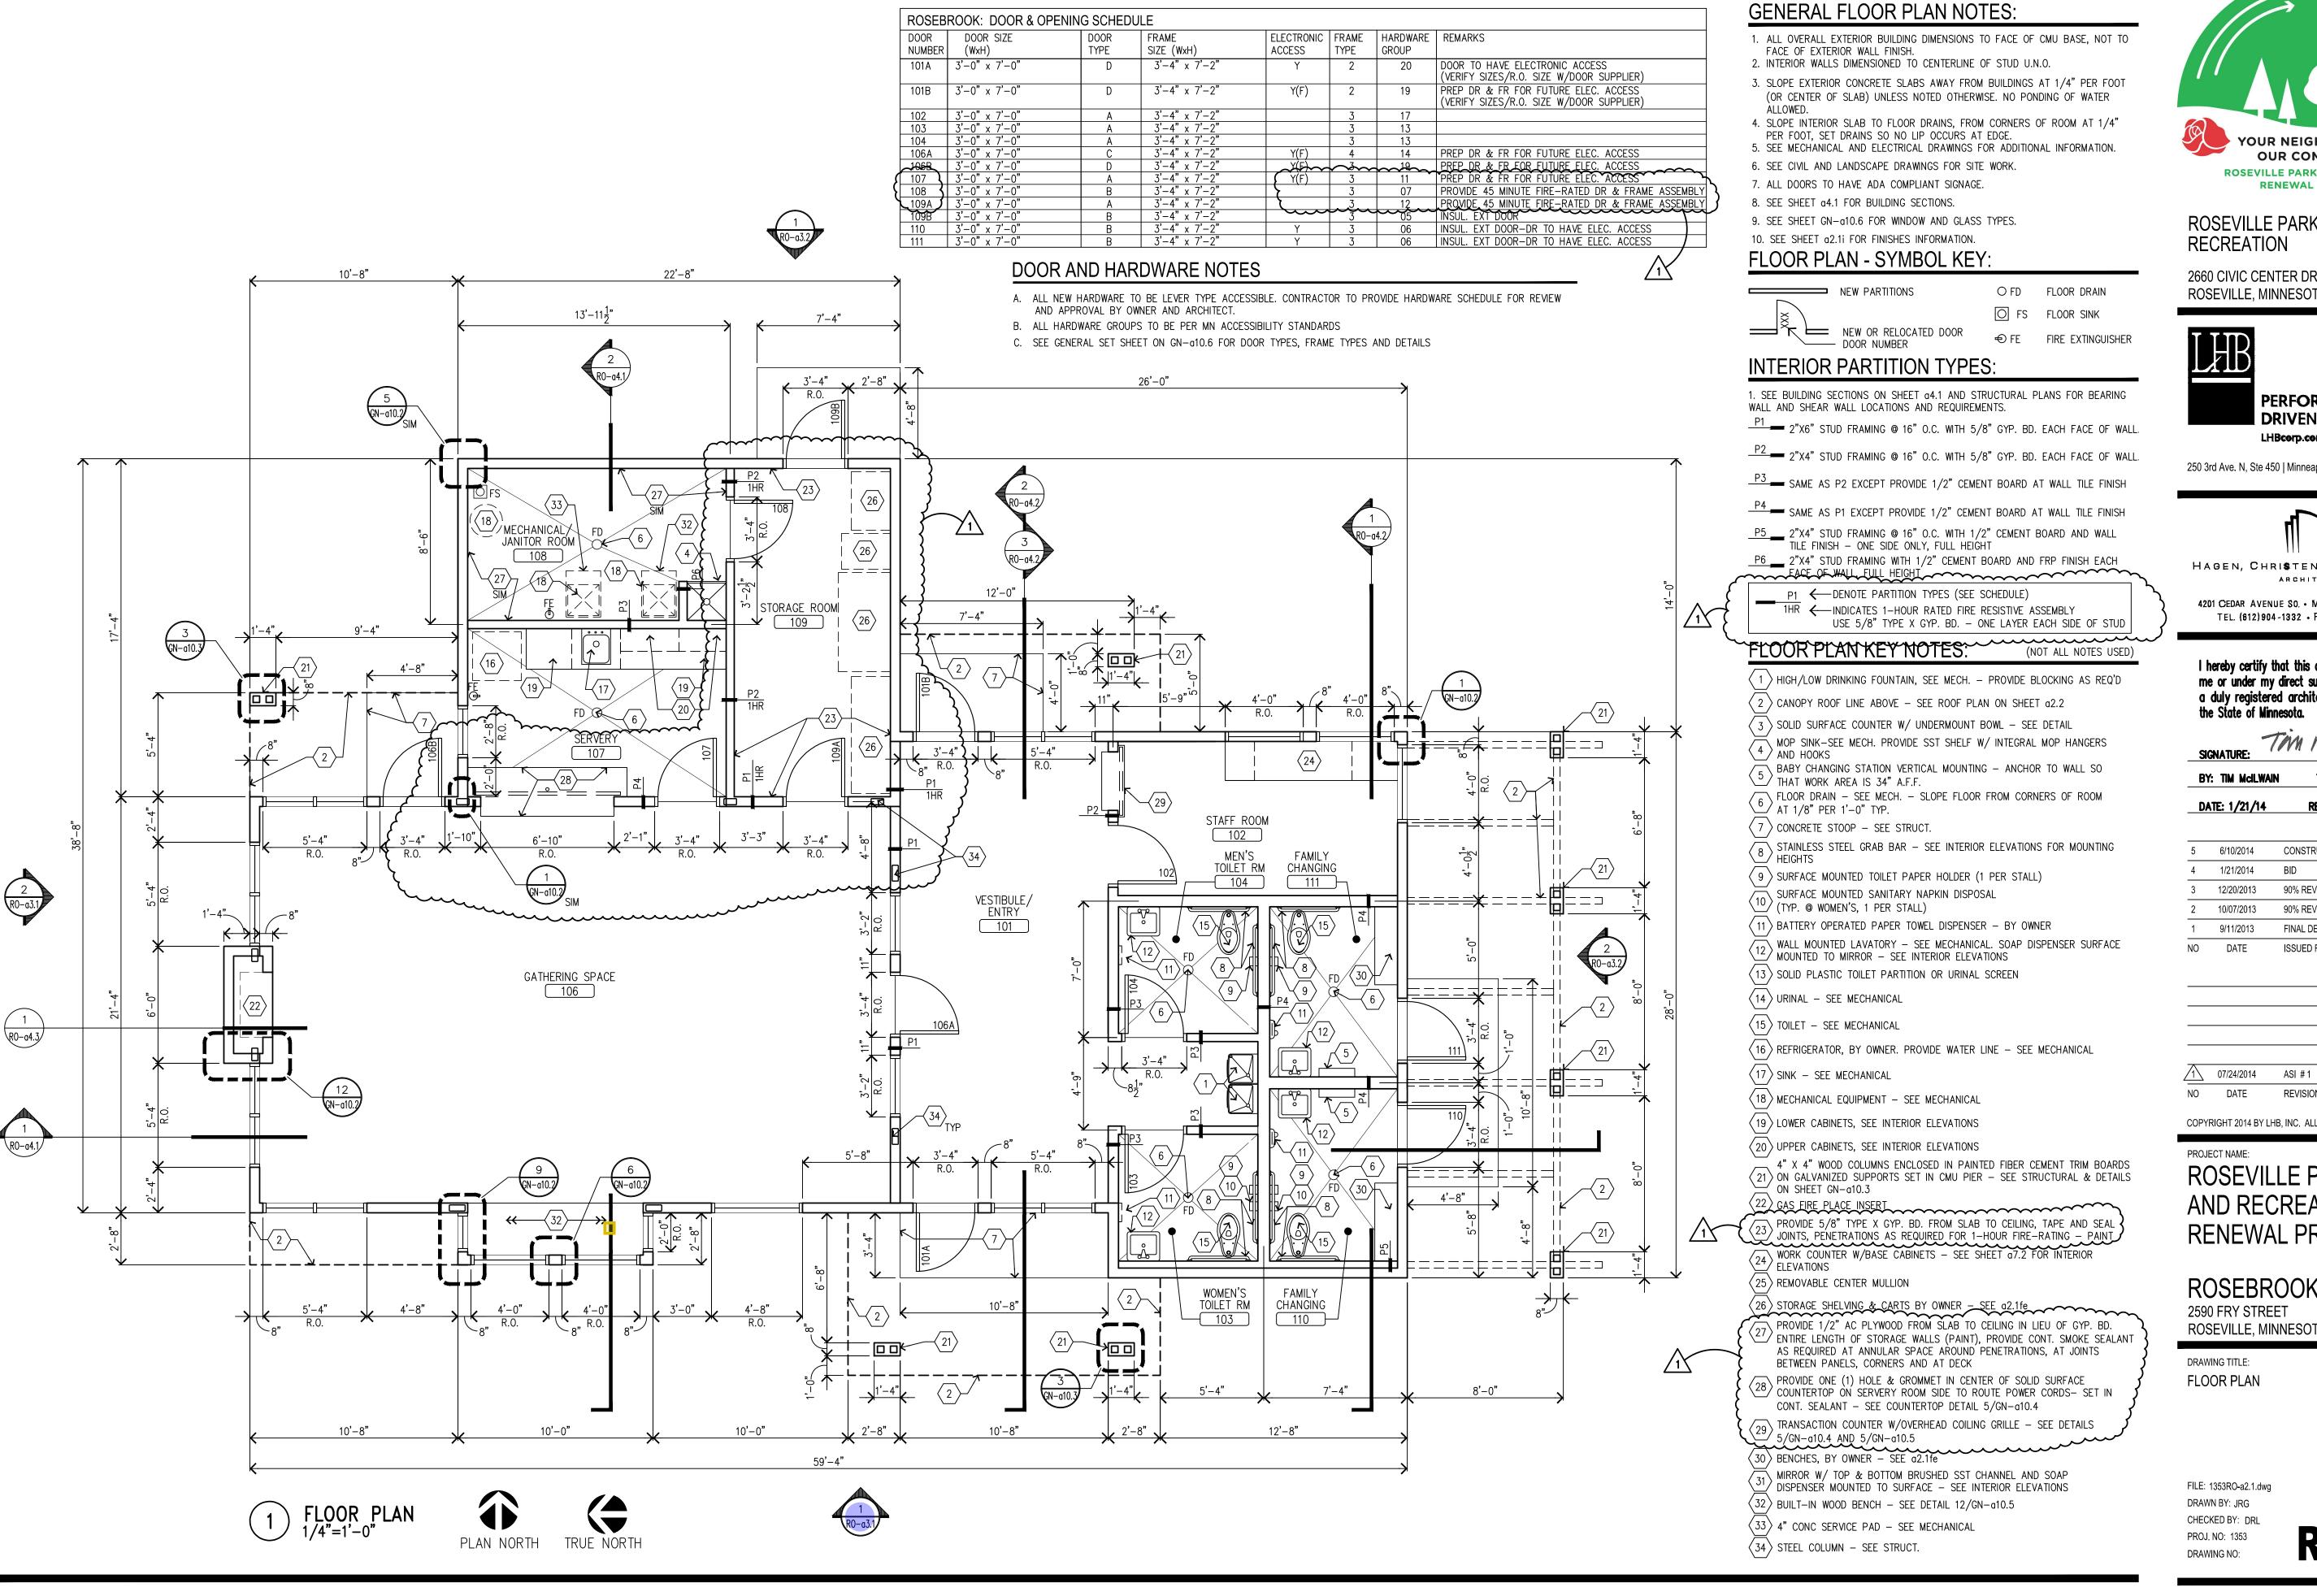





2660 CIVIC CENTER DRIVE ROSEVILLE, MINNESOTA 55113



LHBcerp.cem

250 3rd Ave. N, Ste 450 | Minneapolis, MN 55401 | 612.338.2029



4201 CEDAR AVENUE SO. . MINNEAPOLIS, MN 55407

TEL. (612)904-1332 • FAX (612)904-7366

I hereby certify that this drawing was prepared by me or under my direct supervision and that I am a duly registered architect under the laws of the State of Minnesota.

Tom Mylmon

TITLE: ARCHITECT

DATE: 1/21/14 REG. NO.: 22541

5	6/10/2014	CONSTRUCTION SET	
4	1/21/2014	BID	
3	12/20/2013	90% REVIEW SET	
2	10/07/2013	90% REVIEW SET	

FINAL DESIGN

ISSUED FOR

,			
•			
	_		

9/11/2013

DATE

COPYRIGHT 2014 BY LHB, INC. ALL RIGHTS RESERVED.


REVISION

PROJECT NAME: ROSEVILLE PARKS AND RECREATION RENEWAL PROGRAM

ROSEBROOK PARK 2590 FRY STREET ROSEVILLE, MINNESOTA 55113

DRAWING TITLE: FLOOR PLAN

FILE: 1353RO-a2.1.dwg DRAWN BY: JRG CHECKED BY: DRL PROJ. NO: 1353

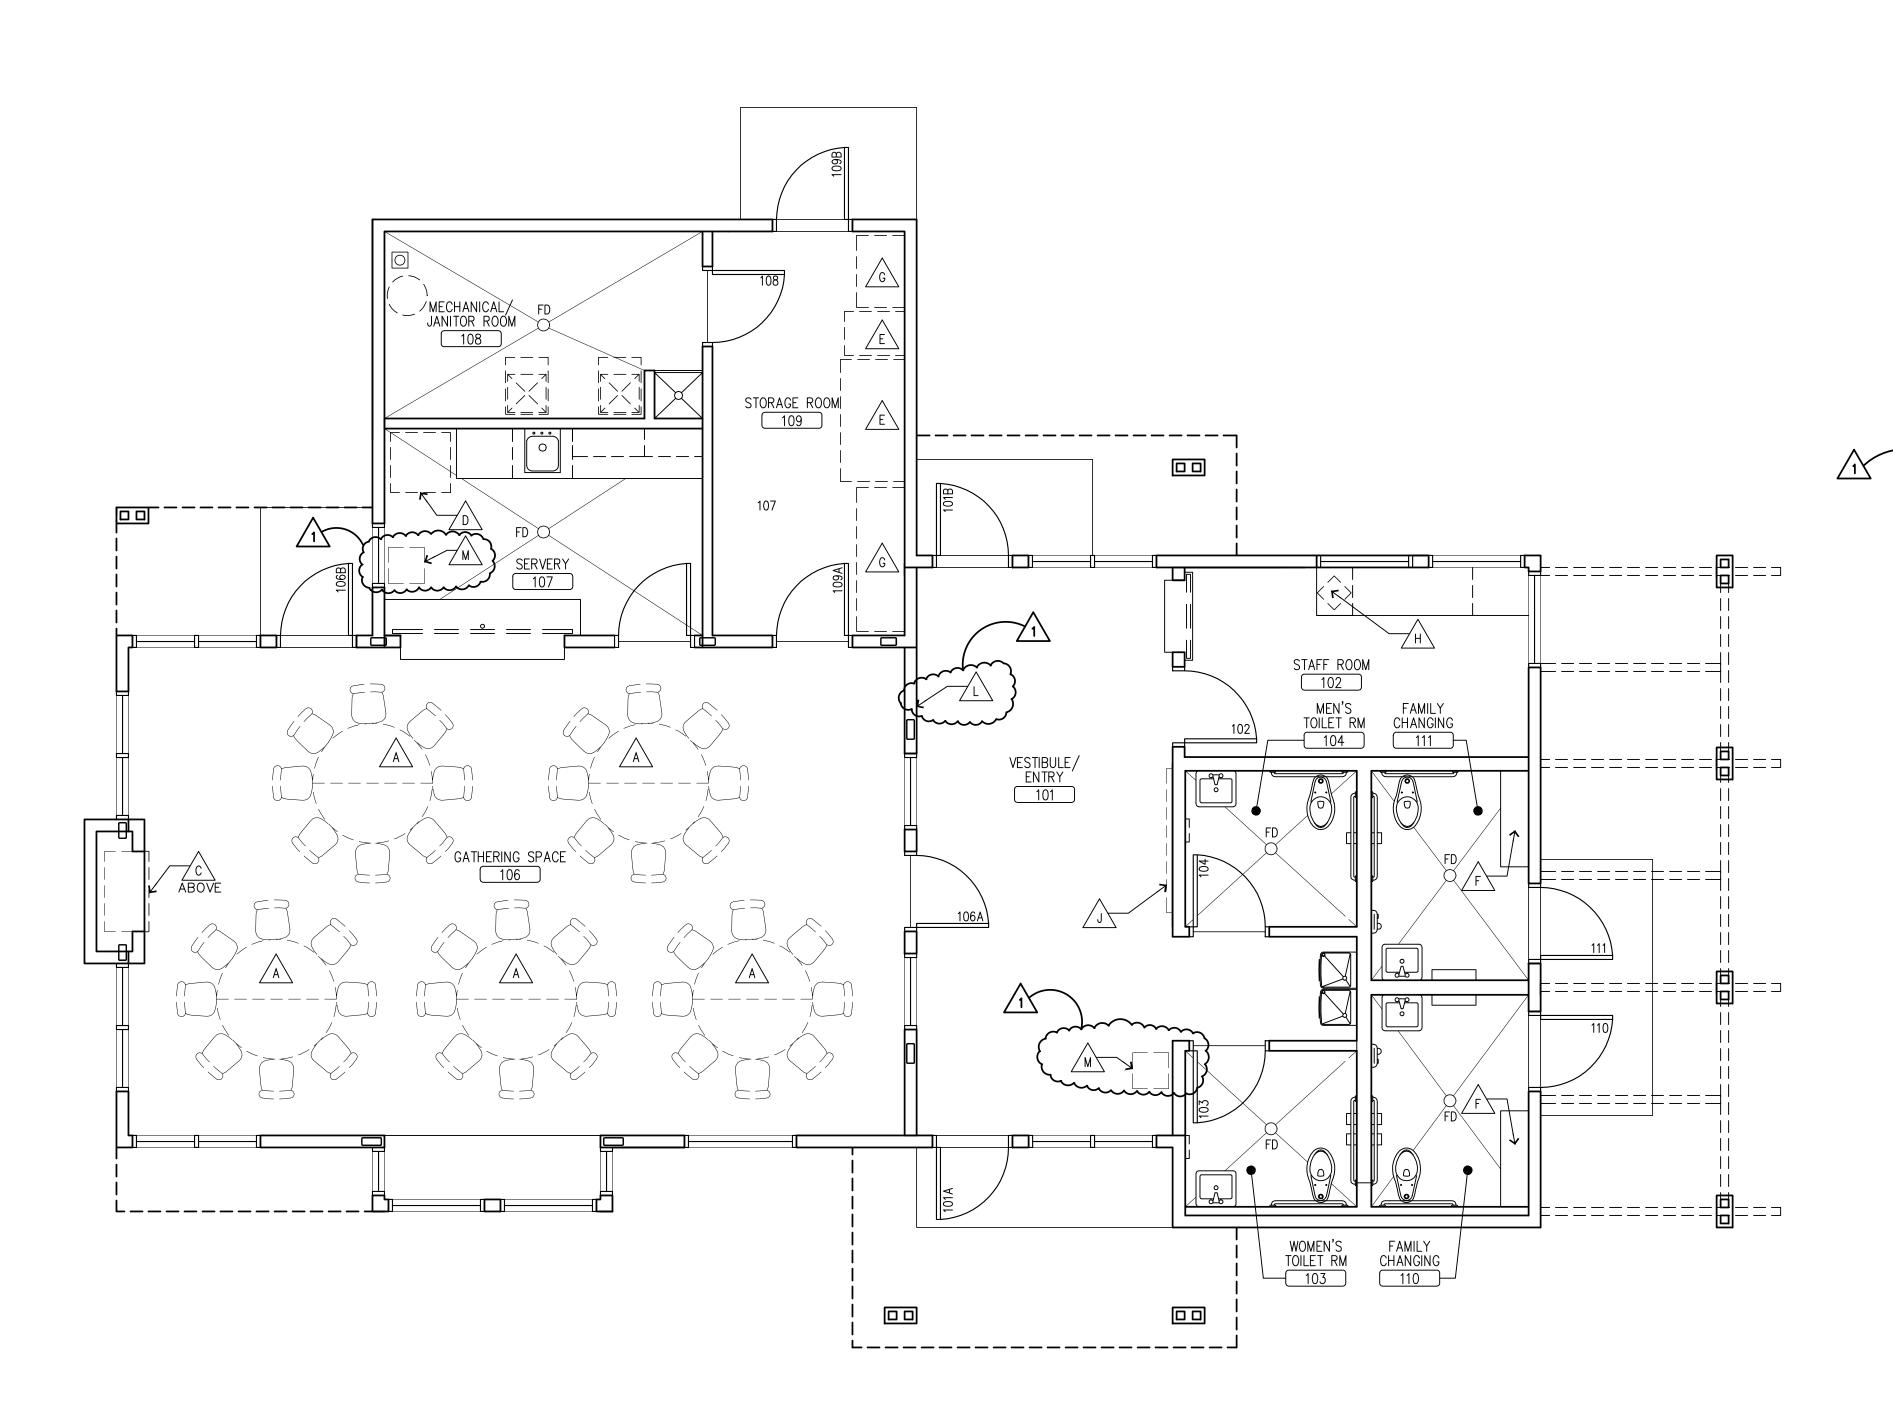

GENERAL FURNITURE NOTES:

- 1. FURNITURE PACKAGE TO BE SUBMITTED SEPARATELY.
- 2. G.C. TO PROVIDE BLOCKING AT LOCATIONS SCHEDULED TO RECEIVE WALL MOUNTED MILLWORK, COUNTERTOPS, SHELVING, ETC.
- 3. REFER TO ELECTRICAL DRAWINGS FOR POWER AND DATA CONNECTIONS.
- 4. REFER TO MILLWORK DETAILS IN GENERAL SET.
- 5. REFER TO SHEET a2.11 FOR FINISH SCHEDULE.

FURNITURE PLAN KEY NOTES: (NOT ALL NOTES USED)

A 60" DIA. 8 PERSON TABLES W/ CHAIRS - PROVIDED BY OWNER

B 48" DIA. 6 PERSON TABLES W/CHAIRS - PROVIDED BY OWNER

FLAT PANEL MONITOR PROVIDED BY OWNER. POWER AND DATA CONDUIT BY CONTRACTOR.

D REFRIGERATOR BY OWNER - POWER AND WATER SUPPLY BY CONTRACTOR

E TABLE AND CHAIR STORAGE CART - PROVIDED BY OWNER

F BENCHES BY OWNER

WALL SHELVING ASSEMBLY BY OWNER - CONTRACTOR TO PROVIDE PLYWOOD WALL PANEL

H COMPUTER BY OWNER

6'-0" X 3'-0" BULLETIN BOARD - SEE INTERIOR ELEVATIONS AND SHEET a2.1i FOR FINISHES - PROVIDED BY OWNER

4'-0" X 3'-0" BULLETIN BOARD - SEE INTERIOR ELEVATIONS AND SHEET a2.1i FOR FINISHES - PROVIDED BY OWNER

L OCCUPANT LOAD SIGNAGE

M RECYCLING SPACE - CONTAINERS PROVIDED BY OWNER



ROSEVILLE PARKS & RECREATION

2660 CIVIC CENTER DRIVE ROSEVILLE, MINNESOTA 55113



DRIVEN DESIGN. LHBcorp.com

250 3rd Ave. N, Ste 450 | Minneapolis, MN 55401 | 612.338.2029



HAGEN, CHRISTENSEN & MCILWAIN ARCHITECT#

4201 CEDAR AVENUE SO. . MINNEAPOLIS, MN 55407 TEL. (612)904-1332 • FAX (612)904-7366

I hereby certify that this drawing was prepared by me or under my direct supervision and that I am a duly registered architect under the laws of the State of Minnesota.

TITLE: ARCHITECT DATE: 1/21/14 REG. NO.: 22541

5 6/10/2014 CONSTRUCTION SET 4 1/21/2014 BID 12/20/2013 90% REVIEW SET 10/07/2013 90% REVIEW SET 9/11/2013 FINAL DESIGN DATE ISSUED FOR

/1\ 07/24/2014 ASI # 1 NO DATE

COPYRIGHT 2014 BY LHB, INC. ALL RIGHTS RESERVED

ROSEVILLE PARKS AND RECREATION RENEWAL PROGRAM

ROSEBROOK PARK 2590 FRY STREET ROSEVILLE, MINNESOTA 55113

DRAWING TITLE: FURNITURE AND EQUIPMENT PLAN


FILE: 1353RO-a2.1fe.dwg DRAWN BY: LMG PROJ. NO: 1353 RO-a2.1fe









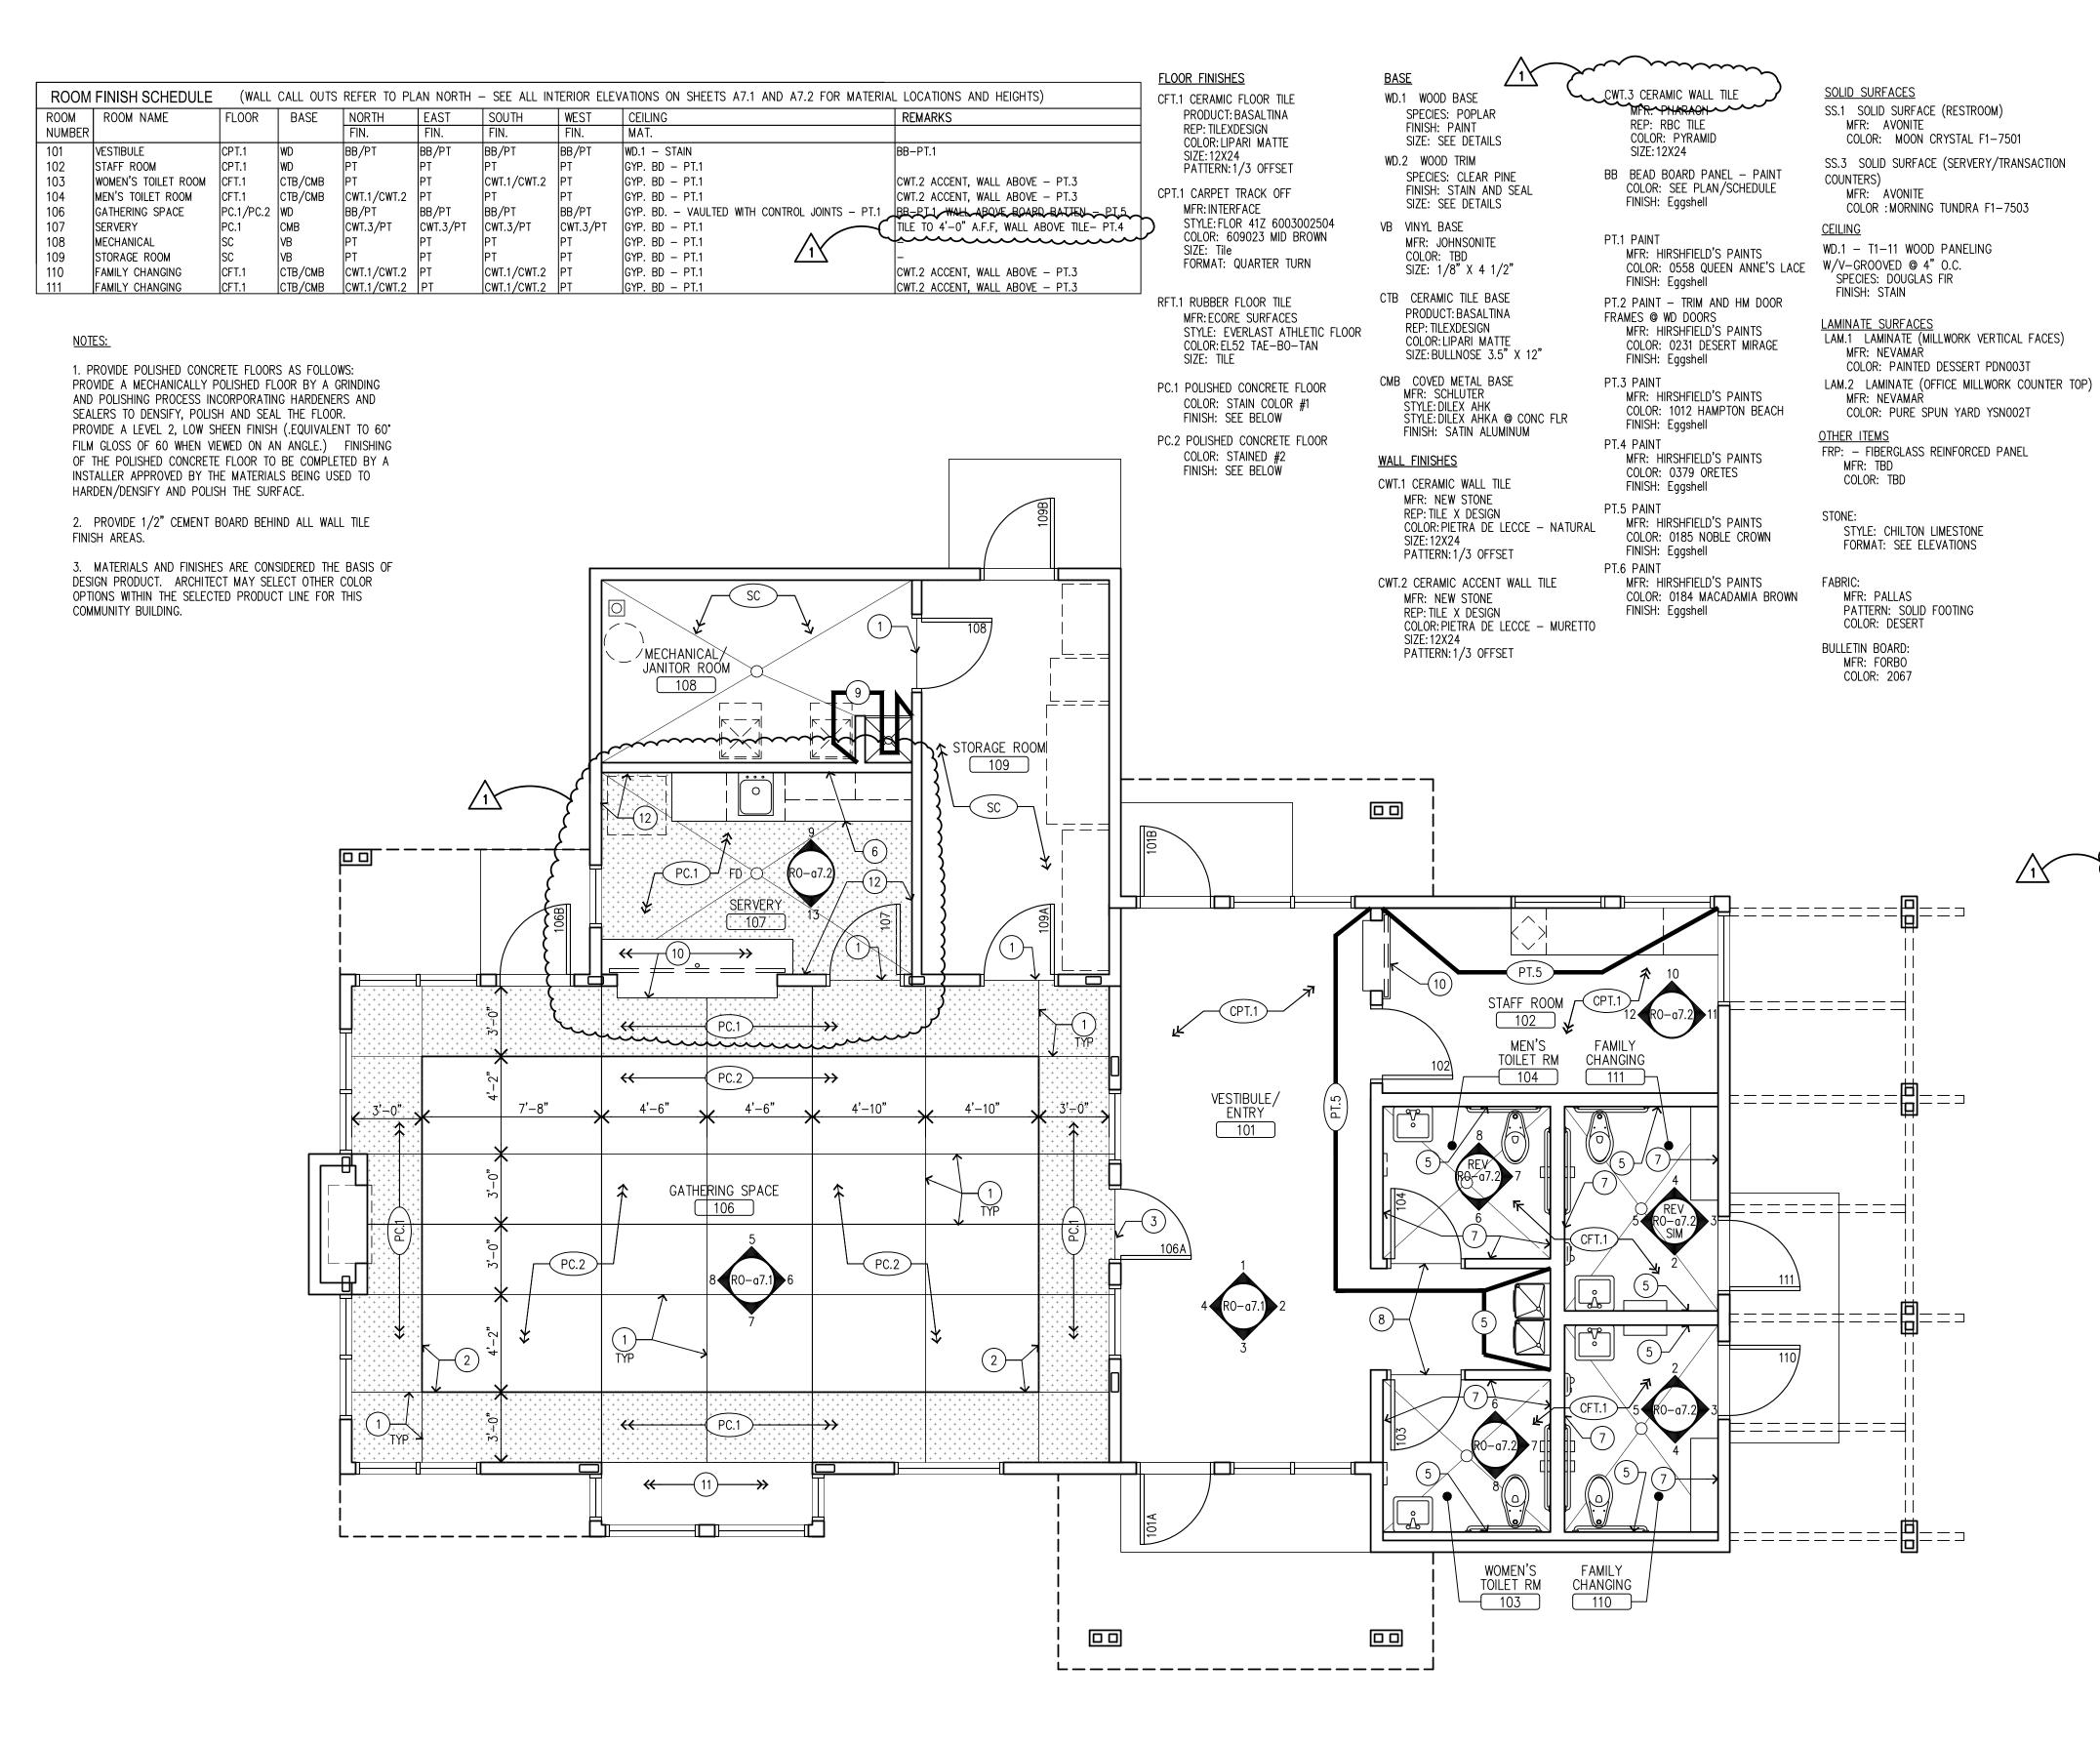

GENERAL ROOM FINISH PLAN NOTES:

- 1. SEE PROJECT MANUAL FOR FINISH SPECIFICATIONS AND INSTALLATION INSTRUCTIONS.
- 2. ALL PAINTED METAL GRILLS, LOUVERS, ETC. TO BE FINISHED TO MATCH
- THE MATERIAL ON WHICH THEY APPEAR. 3. PROVIDE TRANSITION STRIPS/REDUCERS AT ALL FLOORING TRANSITIONS
- AND CHANGE OF FLOOR LOCATIONS, UNLESS OTHERWISE NOTED. 4. CEILING HEIGHTS ARE SHOWN ON REFLECTED CEILING PLANS.
- 5. PAINTING CONTRACTORS APPLICATION OF WALL FINISH CONSTITUTES ACCEPTANCE OF WALL CONDITION AND RESPONSIBILITY FOR IMPERFECTION
- 6. ALL WOOD TRIM TO BE PAINTED UNLESS OTHERWISE NOTED.
- 7. ALL HM FRAMES TO BE PAINTED UNLESS OTHERWISE NOTED.
- 8. ALL WOOD FRAMES AND EXTENSIONS TO BE STAINED.
- 9. ALL WALLS TO BE PAINTED UNLESS OTHERWISE NOTED.
- 10. PROVIDE SCHLUTER TRANSITION EDGES AT ALL OUTSIDE WALL TILE CORNERS, UNLESS OTHERWISE NOTED.

ROOM FINISH PLAN KEY NOTES: (NOT ALL NOTES USED)

- CONTROL JOINT
- SAW CUT AT COLOR TRANSITIONS, 1/2" DEEP WITH COLORED SEALANT
- TAPERED SOLID SURFACE THRESHOLD/TRANSITION @ CONCRETE TRANSITION
- SOLID SURFACE VANITY (SS.1) WITH INTEGRAL SOLID SURFACE (SS.2) BOWL
- WET WALL PROVIDE WALL TILE TO 6'-0" A.F.F. CWT.1 WITH CWT.2 ACCENT AT 6'-0", PROVIDE METAL TOP EDGE AND METAL OUTSIDE CORNER STRIP, PAINT (PT.3) ABOVE TO CEILING — SEE SCHEDULE AND ELEVATIONS ON a7.2
- SOLID SURFACE (SS.3) COUNTERTOP WITH SST SINK DROP IN
- NON WET WALL PROVIDE CERAMIC TILE BASE WITH COVED METAL BASE - GYP. BD. FULL HEIGHT ABOVE, PAINT (PT.1)
- METAL EDGE (SCHLUTER) TRIM @ CARPET TILE/TILE TRANSITION
- FRP FLOOR TO CEILING
- SOLID SURFACE (SS. 3) TRANSACTION TOP
- 11) BUILT-IN WOOD BENCH SEE DETAIL 12/GN-a10.5
- CERAMIC WALL TILE WAINSCOT WITH PAINTED GYP. BD. ABOVE THE PARTY OF THE P



ROSEVILLE PARKS & RECREATION

2660 CIVIC CENTER DRIVE ROSEVILLE, MINNESOTA 55113



PERFORMANCE DRIVEN DESIGN. LHBcerp.cem

250 3rd Ave. N, Ste 450 | Minneapolis, MN 55401 | 612.338.2029



HAGEN, CHRISTENSEN & MCILWAIN

4201 CEDAR AVENUE SO. • MINNEAPOLIS, MN 55407 TEL. (612)904-1332 • FAX (612)904-7366

ARCHITECT \$

I hereby certify that this drawing was prepared by me or under my direct supervision and that I am a duly registered architect under the laws of the State of Minnesota.

BY: TIM MCILWAIN TITLE: ARCHITECT DATE: 1/21/14 **REG. NO.: 22541**

5	6/10/2014	CONSTRUCTION SET
4	1/21/2014	BID
3	12/20/2013	90% REVIEW SET
2	10/07/2013	90% REVIEW SET
1	9/11/2013	FINAL DESIGN
NO	DATE	ISSUED FOR

NO DATE COPYRIGHT 2014 BY LHB, INC. ALL RIGHTS RESERVED

/1\ 07/24/2014 ASI #1

ROSEVILLE PARKS AND RECREATION RENEWAL PROGRAM

ROSEBROOK PARK 2590 FRY STREET ROSEVILLE, MINNESOTA 55113

DRAWING TITLE: FURNITURE AND EQUIPMENT PLAN


FILE: 1353RO-a2.1i.dwg DRAWN BY: LMG CHECKED BY: DRL

RO-a2.1i







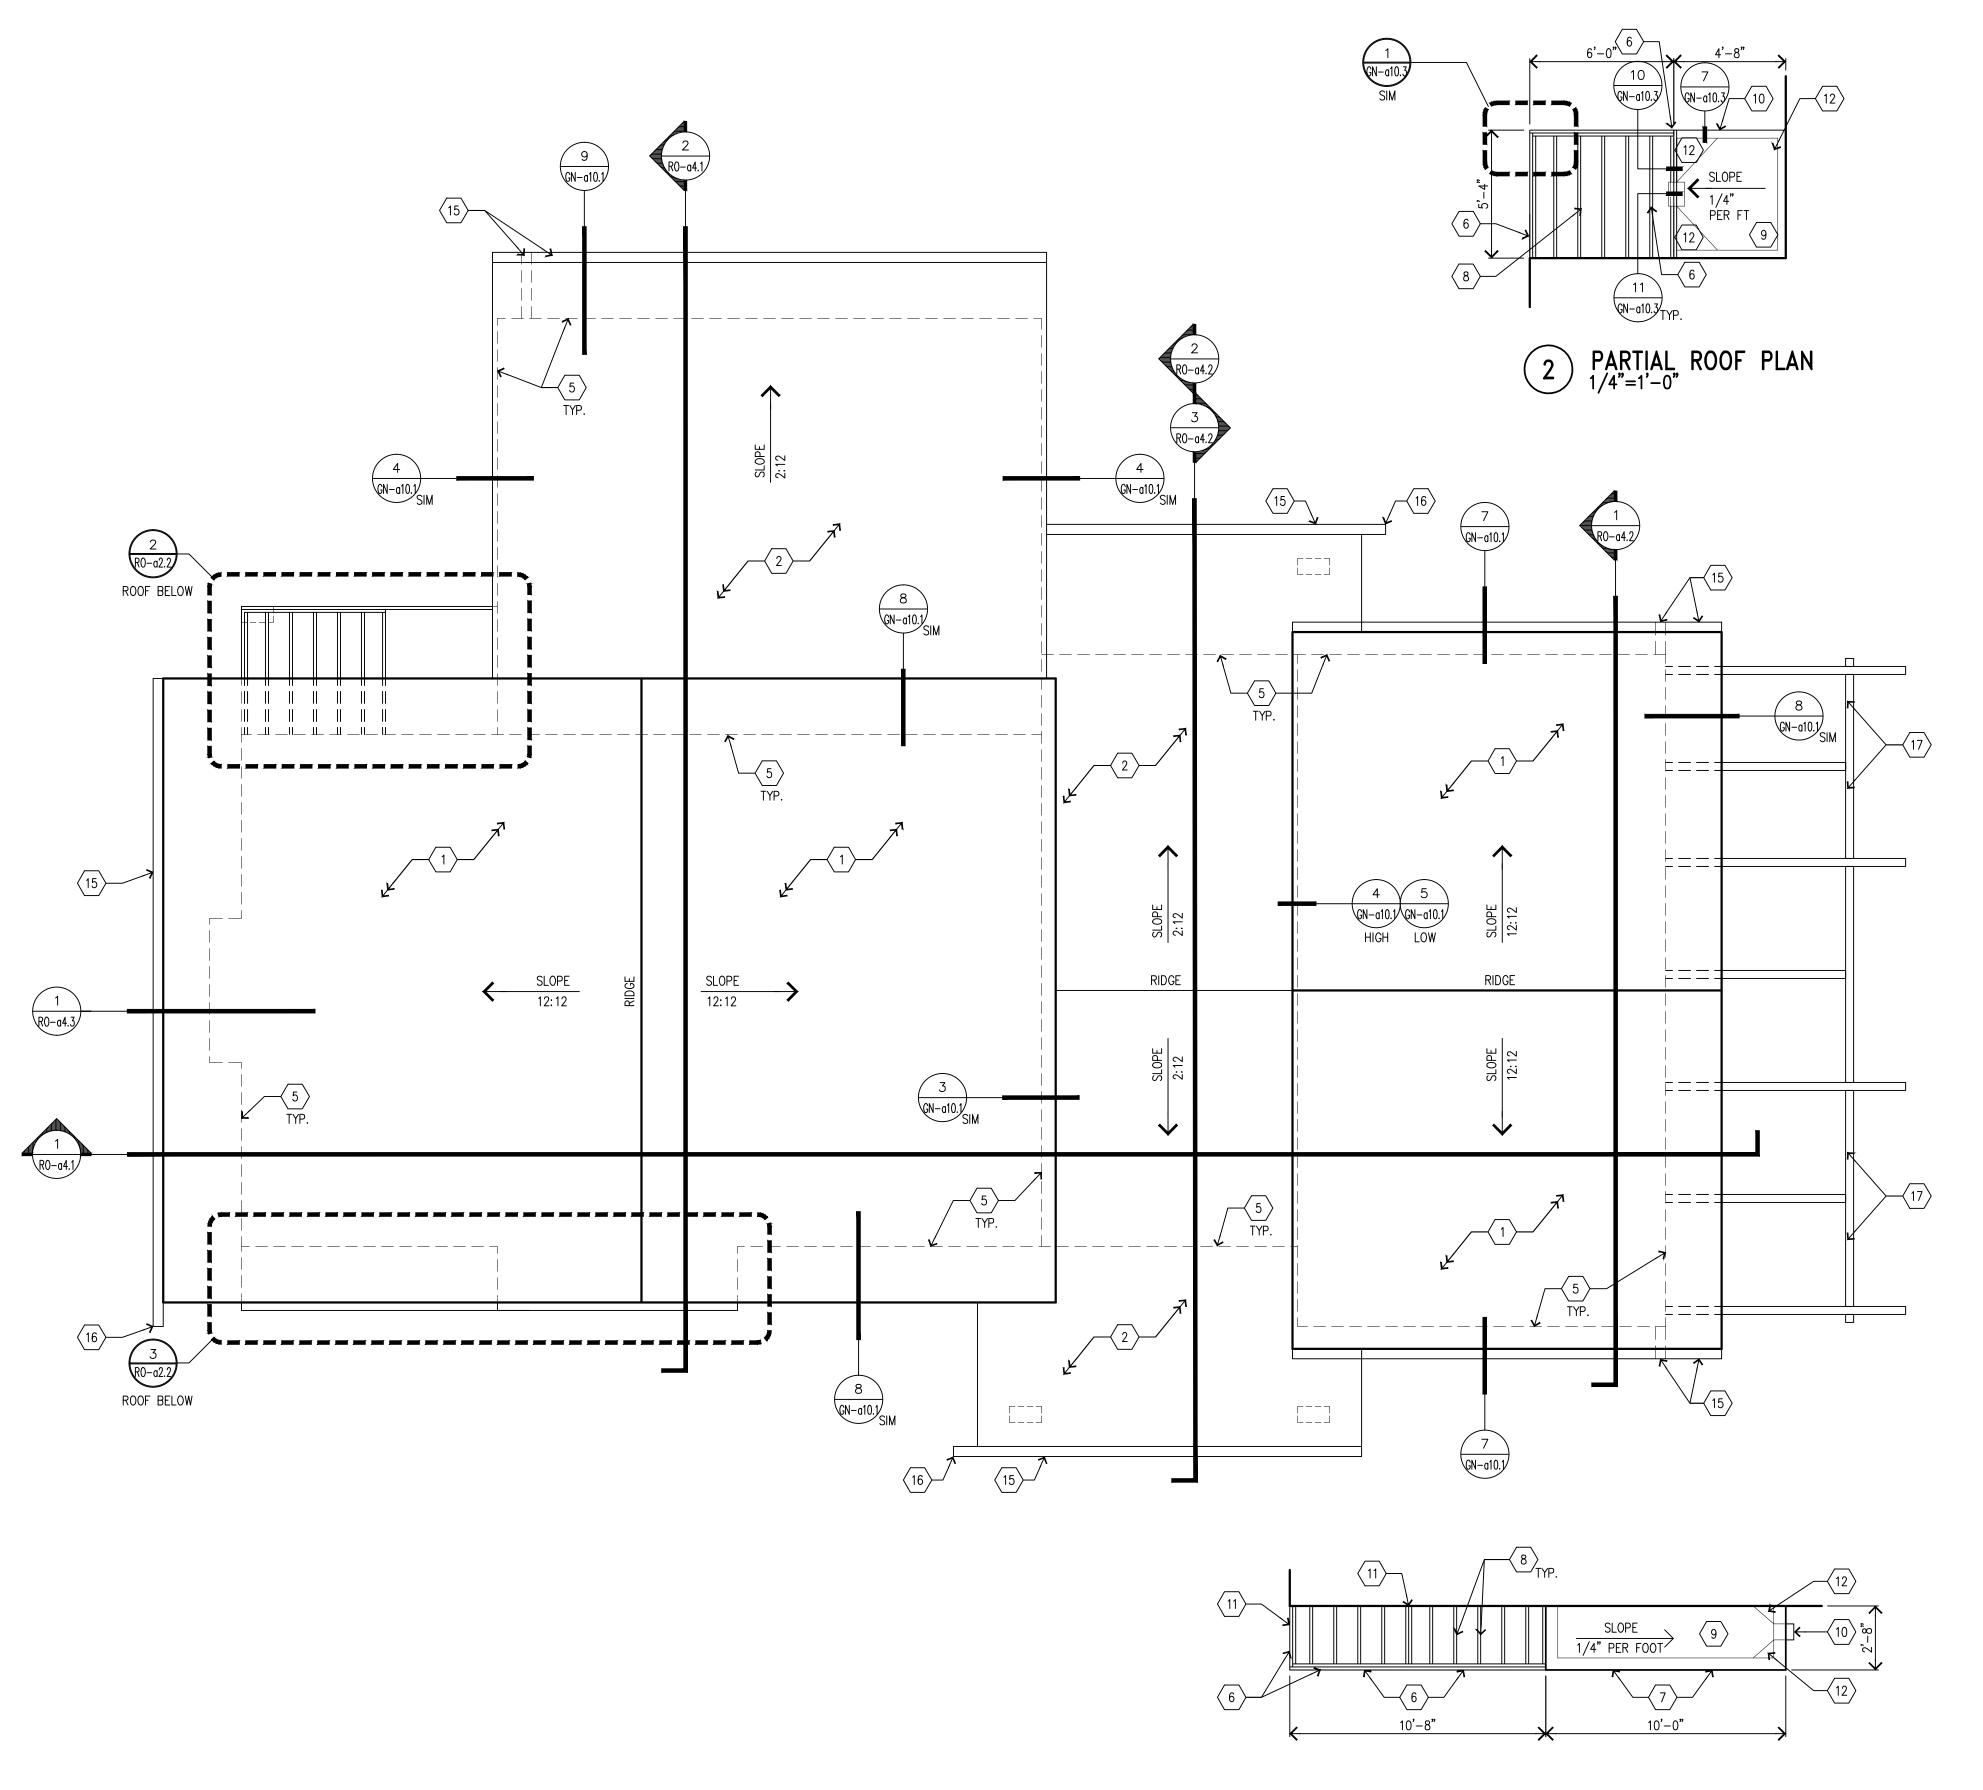

GENERAL ROOF PLAN NOTES:

- 1. SEE MECHANICAL & ELECTRICAL DRAWINGS FOR ADDITIONAL INFORMATION 2. PROVIDE ICE AND WATER SHIELD MEMBRANE FROM ROOF EDGE TO 3'-0"
- (MIN) IN FROM EXTERIOR WALL U.N.O.

ROOF PLAN - SYMBOL KEY:

ROOF PLAN KEY NOTES:

(NOT ALL NOTES USED)

- (1) LAMINATED ASPHALT SHINGLE ROOF ASSEMBLY OVER BUILDING PAPER
- LAMINATED ASPHALT SHINGLE ROOF ASSEMBLY OVER CONT. ICE & WATER SHIELD MEMBRANE ALL 2:12 ROOF SLOPES
- PROVIDE ICE & WAT SIDE OF VALLEY) PROVIDE ICE & WATER SHIELD MEMBRANE AT VALLEY (3'-0" EA
- 4 PREFIN. METAL CHIMNEY CAP ASSEMBLY
- 5 LINE OF WALL BELOW
- 6 PREFIN. METAL CAP FLASHING AND CONT. KEEPER OVER 2x8 CEDAR FRAMING & FIBER CEMENT TRIM BOARD SEE STRUCTURAL
- (7) PREFIN. METAL WALL CAP & FLASHING
- 8 2x8 CEDAR FRAMING @ 12" O. PREFIN METAL CAP FLASHING 2x8 CEDAR FRAMING @ 12" O.C. - SEE STRUCTURAL, PROVIDE
- FULLY ADHERED ROOF MEMBRANE ASSEMBLY SLOPE 1/4" PER FT. SEE DETAILS ON GN-a10.3
- 10 PREFIN. METAL SCUPPER ASSEMBLY SEE DETAILS GN-a10.3
- 2x8 CEDAR FRAMING ANCHOR BOLTED TOGETHER WITH STEEL
 PLATE BRACKET IN BETWEEN COVER WITH PREFIN. METAL CAP FLASHING - SEE STRUCTURAL
- 12 PROVIDE SLOPED CRICKETS
- PROVIDE CONTINUOUS PREFIN SEAMLESS METAL FAIR LASTING LENGTH OF VALLEY EXTEND 3'-0" PAST EDGE OF VALLEY PROVIDE CONTINUOUS PREFIN SEAMLESS METAL PAN FLASHING ENTIRE
- PROVIDE ICE AND WATER SHIELD MEMBRANE AT VALLEY (10'-0" EACH SIDE OF VALLEY)
- 3" X 5" PREFINISHED METAL BOX GUTTER W/ DOWN SPOUT
- (16) OPEN ENDED GUTTER EXTENSION NO DOWNSPOUT
- WOOD ARBOR ASSEMBLY STAIN, WITH SUN SHADE FABRIC PANELS - SEE DETAIL 2/RO-a9.1 AND STRUCTURAL - PROVIDE PREFINISHED METAL CAP FLASHING OVER WOOD POSTS AND 2X CEDAR FRAMING ASSEMBLY



ROSEVILLE PARKS & RECREATION

2660 CIVIC CENTER DRIVE ROSEVILLE, MINNESOTA 55113



PERFORMANCE DRIVEN DESIGN. LHBcorp.com

250 3rd Ave. N, Ste 450 | Minneapolis, MN 55401 | 612.338.2029



ARCHITECT \$

4201 CEDAR AVENUE SO. . MINNEAPOLIS, MN 55407 TEL. (612)904-1332 • FAX (612)904-7366

I hereby certify that this drawing was prepared by me or under my direct supervision and that I am a duly registered architect under the laws of the State of Minnesota.

TOM MALLIAN

TITLE: ARCHITECT DATE: 1/21/14 REG. NO.: 22541

5	6/10/2014	CONSTRUCTION SET	
4	1/21/2014	BID	
3	12/20/2013	90% REVIEW SET	
2	10/07/2013	90% REVIEW SET	
1	9/11/2013	FINAL DESIGN	
NO	DATE	ISSUED FOR	

4	6/04/2014	ADDENDUM #4	
3	2/28/2014	ADDENDUM #3	
2	2/25/2014	ADDENDUM #2	
$\overline{\Lambda}$	2/11/2014	ADDENDUM #1	
NO	DATE	REVISION	

COPYRIGHT 2014 BY LHB, INC. ALL RIGHTS RESERVED

ROSEVILLE PARKS AND RECREATION RENEWAL PROGRAM

ROSEBROOK PARK 2590 FRY STREET ROSEVILLE, MINNESOTA 55113

DRAWING TITLE: **ROOF PLAN**

FILE: 1353RO-a2.2.dwg DRAWN BY: JRG CHECKED BY: DRL

RO-a2.2











3 PARTIAL ROOF PLAN

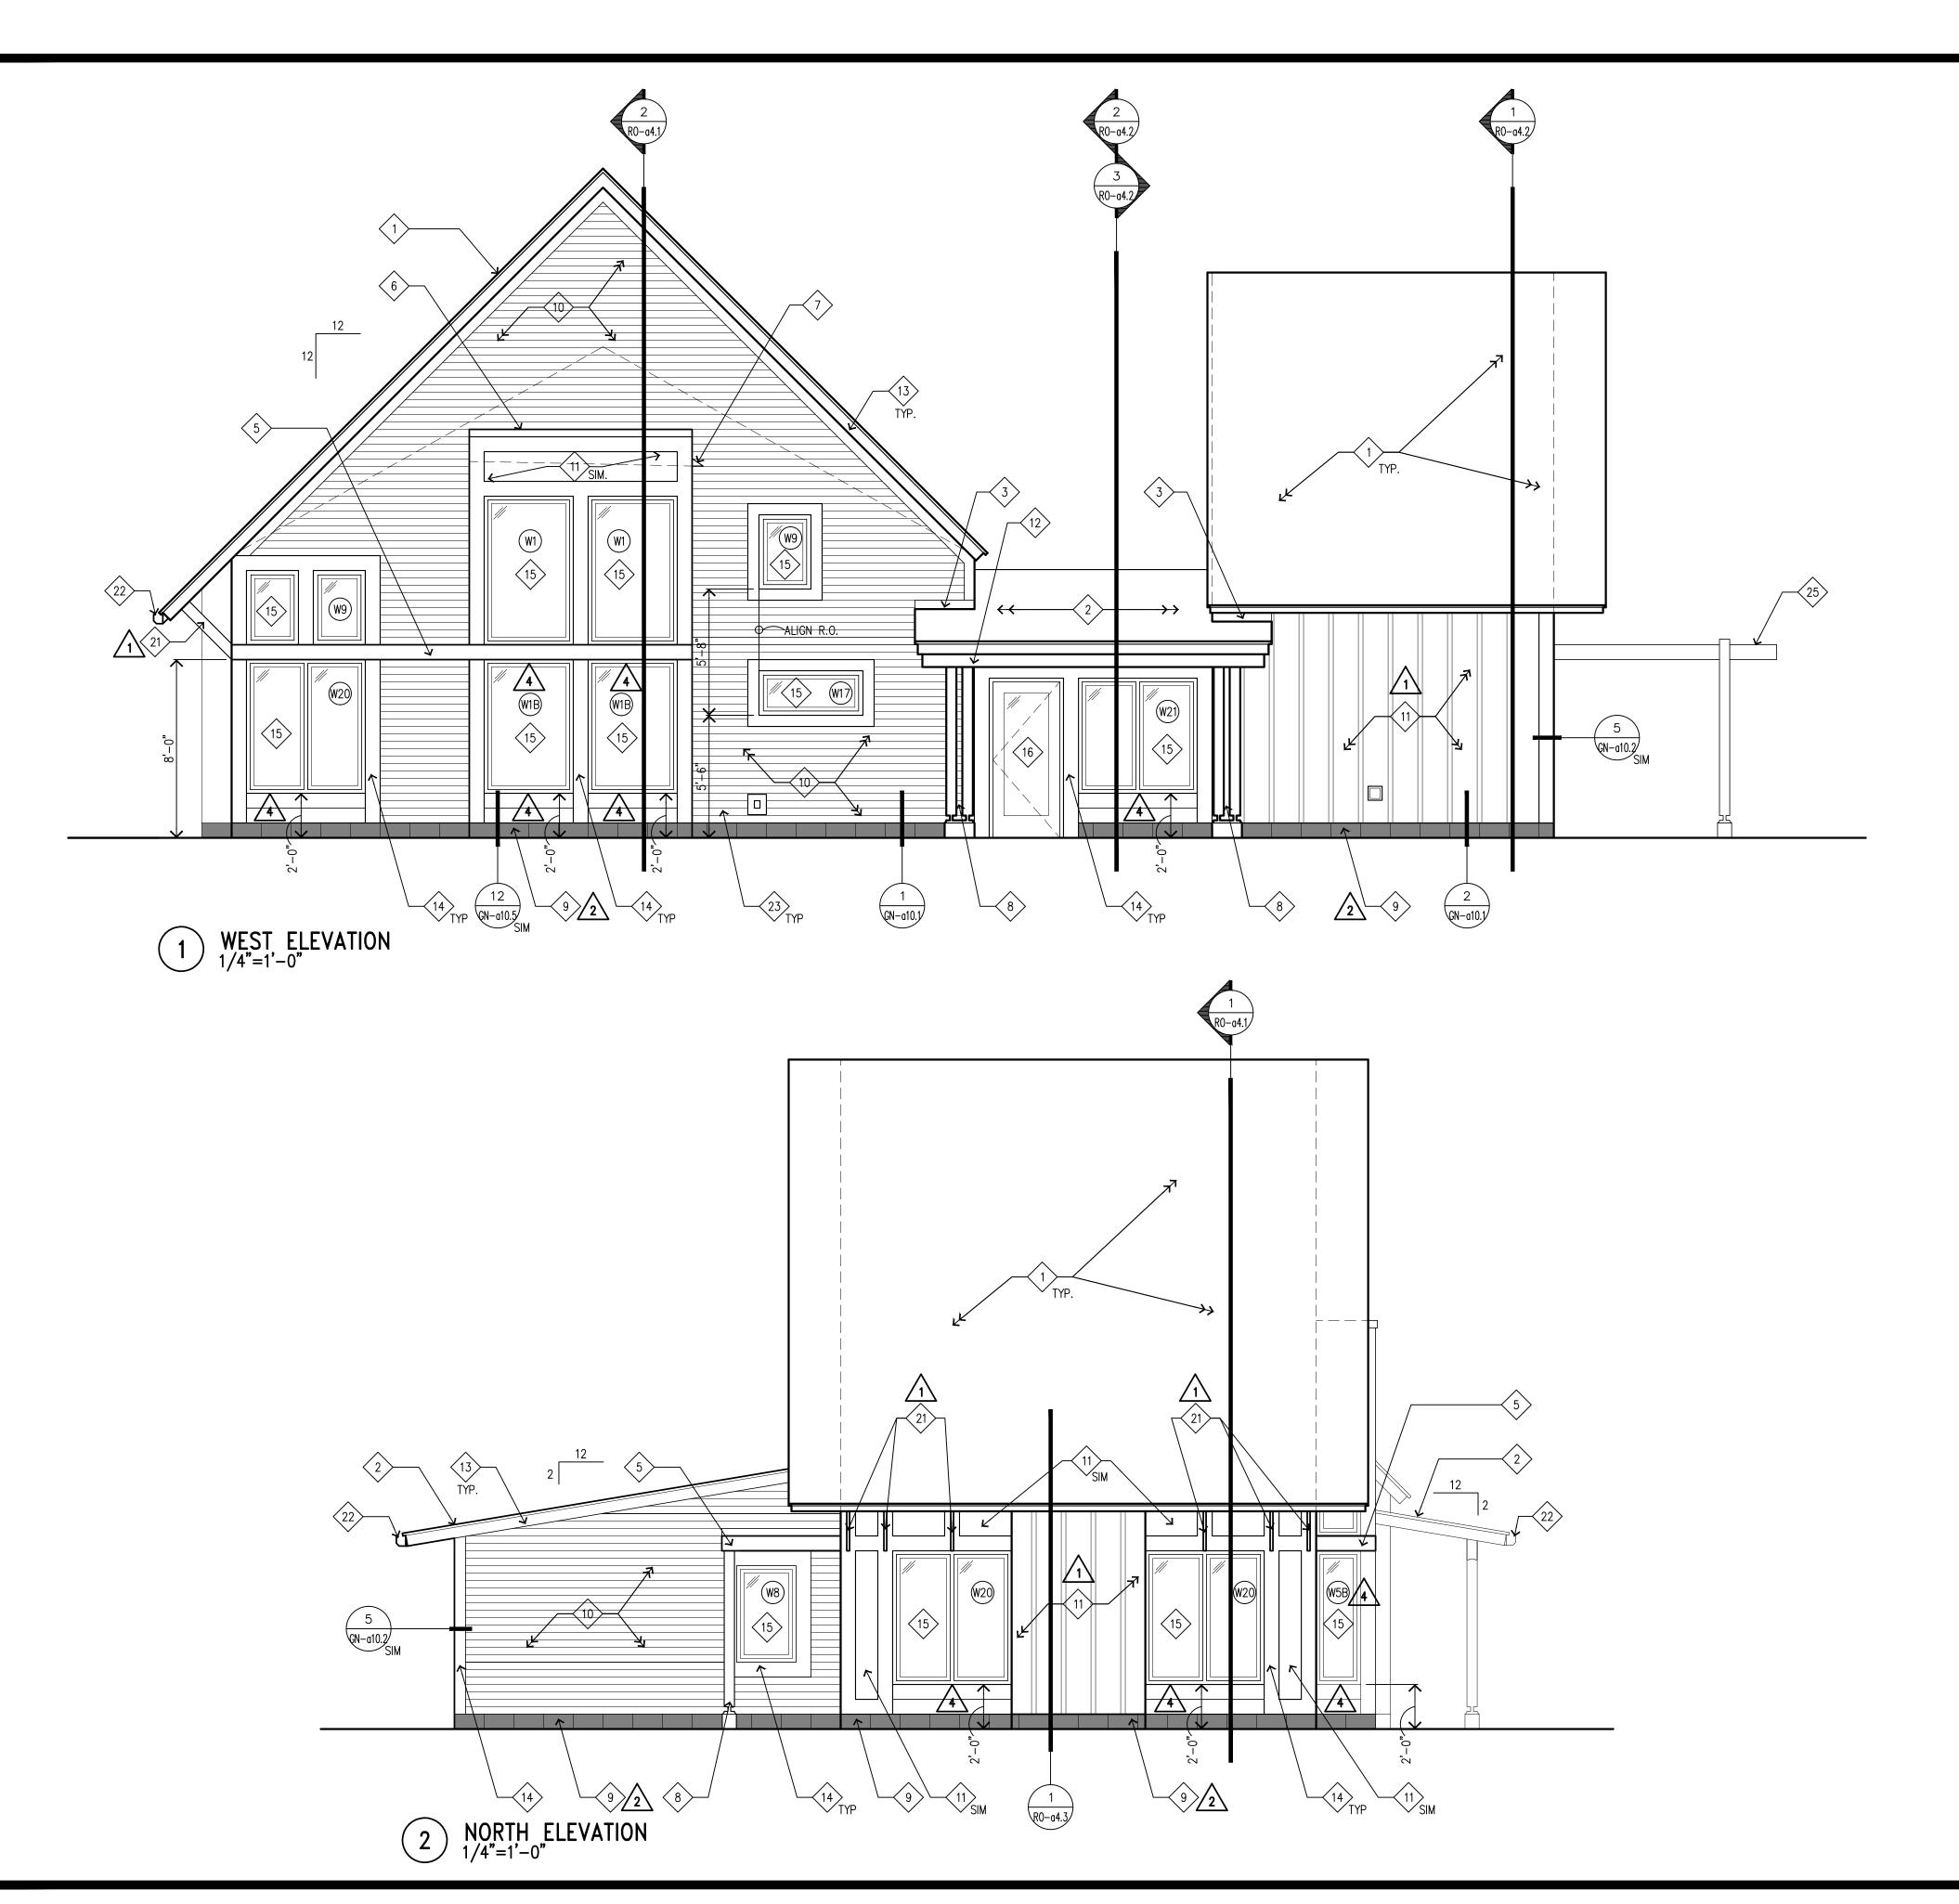

EXTERIOR ELEVATION KEY NOTES: (NOT ALL NOTES USED)

- (1) LAMINATED ASPHALT SHINGLE ROOF ASSEMBLY OVER BUILDING PAPER
- 2 LAMINATED ASPHALT SHINGLE ROOF ASSEMBLY OVER CONT. ICE & WATER SHIELD MEMBRANE ALL 2:12 ROOF SLOPES
- CONTINUOUS FLASHING @ JOINT BETWEEN LOW ROOF AND WALL SEE DETAILS ON SHEET GN-a10.3
- 4 > PREFIN. METAL CHIMNEY CAP ASSEMBLY
- SUN SHADE ASSEMBLY 2x8 CEDAR FRAMING W/FIBER CEMENT TRIM 5 BOARD @ FACE - PROVIDE PREFIN METAL CAP FLASHING - SEE WALL SECTIONS AND DETAILS ON SHEET GN-a10.3
- 6 PREFIN. METAL WALL CAP & FLASHING
- PREFIN. METAL SCUPPER ASSEMBLY
- 4" X 4" WOOD COLUMNS ENCLOSED IN PAINTED FIBER CEMENT TRIM 8 BOARDS ON GALVANIZED SUPPORTS SET IN CMU PIER - SEE STRUCTURAL & DETAILS ON SHEET GN-a10.3
- (2) 6" BURNISHED CMU BASE COURSE : GROUT CORES SOLID AT ANCHOR BOLT LOCATIONS DEP STRUCTURAL SETTING. ANCHOR BOLT LOCATIONS PER STRUCTURAL DETAIL 8/GN-s1.1 AND PROVIDE CORE FILL INSULATION AT ALL OTHER LOCATIONS - SEE WALL SECTIONS AND DETAILS ON SHEET GN-a10.1
 - (10) PRE-PRIMED FIBER CEMENT LAP SIDING 4" EXPOSURE PAINT

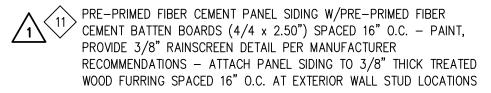

- TREATED 2x WOOD BEAM FRAMING ENCLOSED IN CEMENT FIBER TRIM TREATED 2x WOOD BEAM FRAMING ENCLOSED IN CEMENT FIBER TRIM
 BOARDS PRE-PRIMED FOR PAINT - SEE STRUC & DETAILS ON SHEET
- FASCIA ASSEMBLY PAINT, WITH PREFINISHED METAL ROOF EAVE FLASHING, MATCH ROOF COLOR SEE DETAILS ON SHEET GN-a10.1
- (14) CONT. 5/4 FIBER CEMENT TRIM BOARD PRE-PRIMED FOR PAINT
- <15> CLAD WOOD WINDOWS. SEE WINDOW TYPES ON SHEET GN-a10.6
- CLAD WOOD DOOR & FRAME W/GLAZING SEE SHEET GNa10.6 FOR DOOR TYPES
- (17) H.M. DOOR & FRAME SEE SHEET GN-a10.6 FOR DOOR TYPES
- LOUVER SEE MECHANICAL PREPRIMED FOR PAINT, PROVIDE FIBER CEMENT TRIM BOARDS AT PERIMETER

19 NOT USED

- CLAD WOOD WINDOW W/TRANSLUCENT GLAZING SEE WINDOW TYPES ON SHEET GN-a10.6
- 1X CEDAR BRACKET ASSEMBLY, STAIN W/GALV. STEEL T-SHAPED MOUNTING PLATES AT SOFFIT & WALL SEE DETAILS ON SHEET GN-a10.2
 - 3"x5" PREFIN METAL BOX GUTTER SEE ROOF PLAN FOR DOWNSPOUT LOCATION
- 23 ELECTRICAL RECEPTACLE SEE ELEC PROVIDE FIBER CEMENT TRIM BOARDS @ PERIMETER
- 24 HORIZONTAL TRIM AT FIBER CEMENT VERTICAL PANEL SIDING JOINT

WOOD ARBOR ASSEMBLY - STAIN, WITH SUN SHADE FABRIC PANELS - SEE DETAIL 2/RO-α9.1 AND STRUCTURAL - PROVIDE PREFINISHED METAL CAP FLASHING OVER WOOD POSTS AND 2X CEDAR FRAMING ASSEMBLY



ROSEVILLE PARKS & RECREATION

2660 CIVIC CENTER DRIVE ROSEVILLE, MINNESOTA 55113



PERFORMANCE DRIVEN DESIGN. LHBcorp.com

250 3rd Ave. N, Ste 450 | Minneapolis, MN 55401 | 612.338.2029



HAGEN, CHRISTENSEN & MCILWAIN ARCHITECT #

4201 CEDAR AVENUE SO. . MINNEAPOLIS, MN 55407 TEL. (612)904-1332 • FAX (612)904-7366

I hereby certify that this drawing was prepared by me or under my direct supervision and that I am a duly registered architect under the laws of the State of Minnesota.

TAM MALMON

BY: TIM MCILWAIN	TITLE: ARCHITECT
DATE: 1/21/14	REG. NO.: 22541

5	6/10/2014	CONSTRUCTION SET
4	1/21/2014	BID
3	12/20/2013	90% REVIEW SET
2	10/07/2013	90% REVIEW SET
1	9/11/2013	FINAL DESIGN
NO	DATE	ISSUED FOR

4	6/04/2014	ADDENDUM #4	
$\sqrt{3}$	2/28/2014	ADDENDUM #3	
2	2/25/2014	ADDENDUM #2	
Λ	2/11/2014	ADDENDUM #1	
NO	DATE	DEVISION	•

COPYRIGHT 2014 BY LHB, INC. ALL RIGHTS RESERVED


ROSEVILLE PARKS AND RECREATION RENEWAL PROGRAM

ROSEBROOK PARK 2590 FRY STREET ROSEVILLE, MINNESOTA 55113

DRAWING TITLE: EXTERIOR ELEVATIONS

FILE: 1353RO-a3.1a3.2.dwg DRAWN BY: JRG CHECKED BY: DRL PROJ. NO: 1353 DRAWING NO:

RO-a3.1

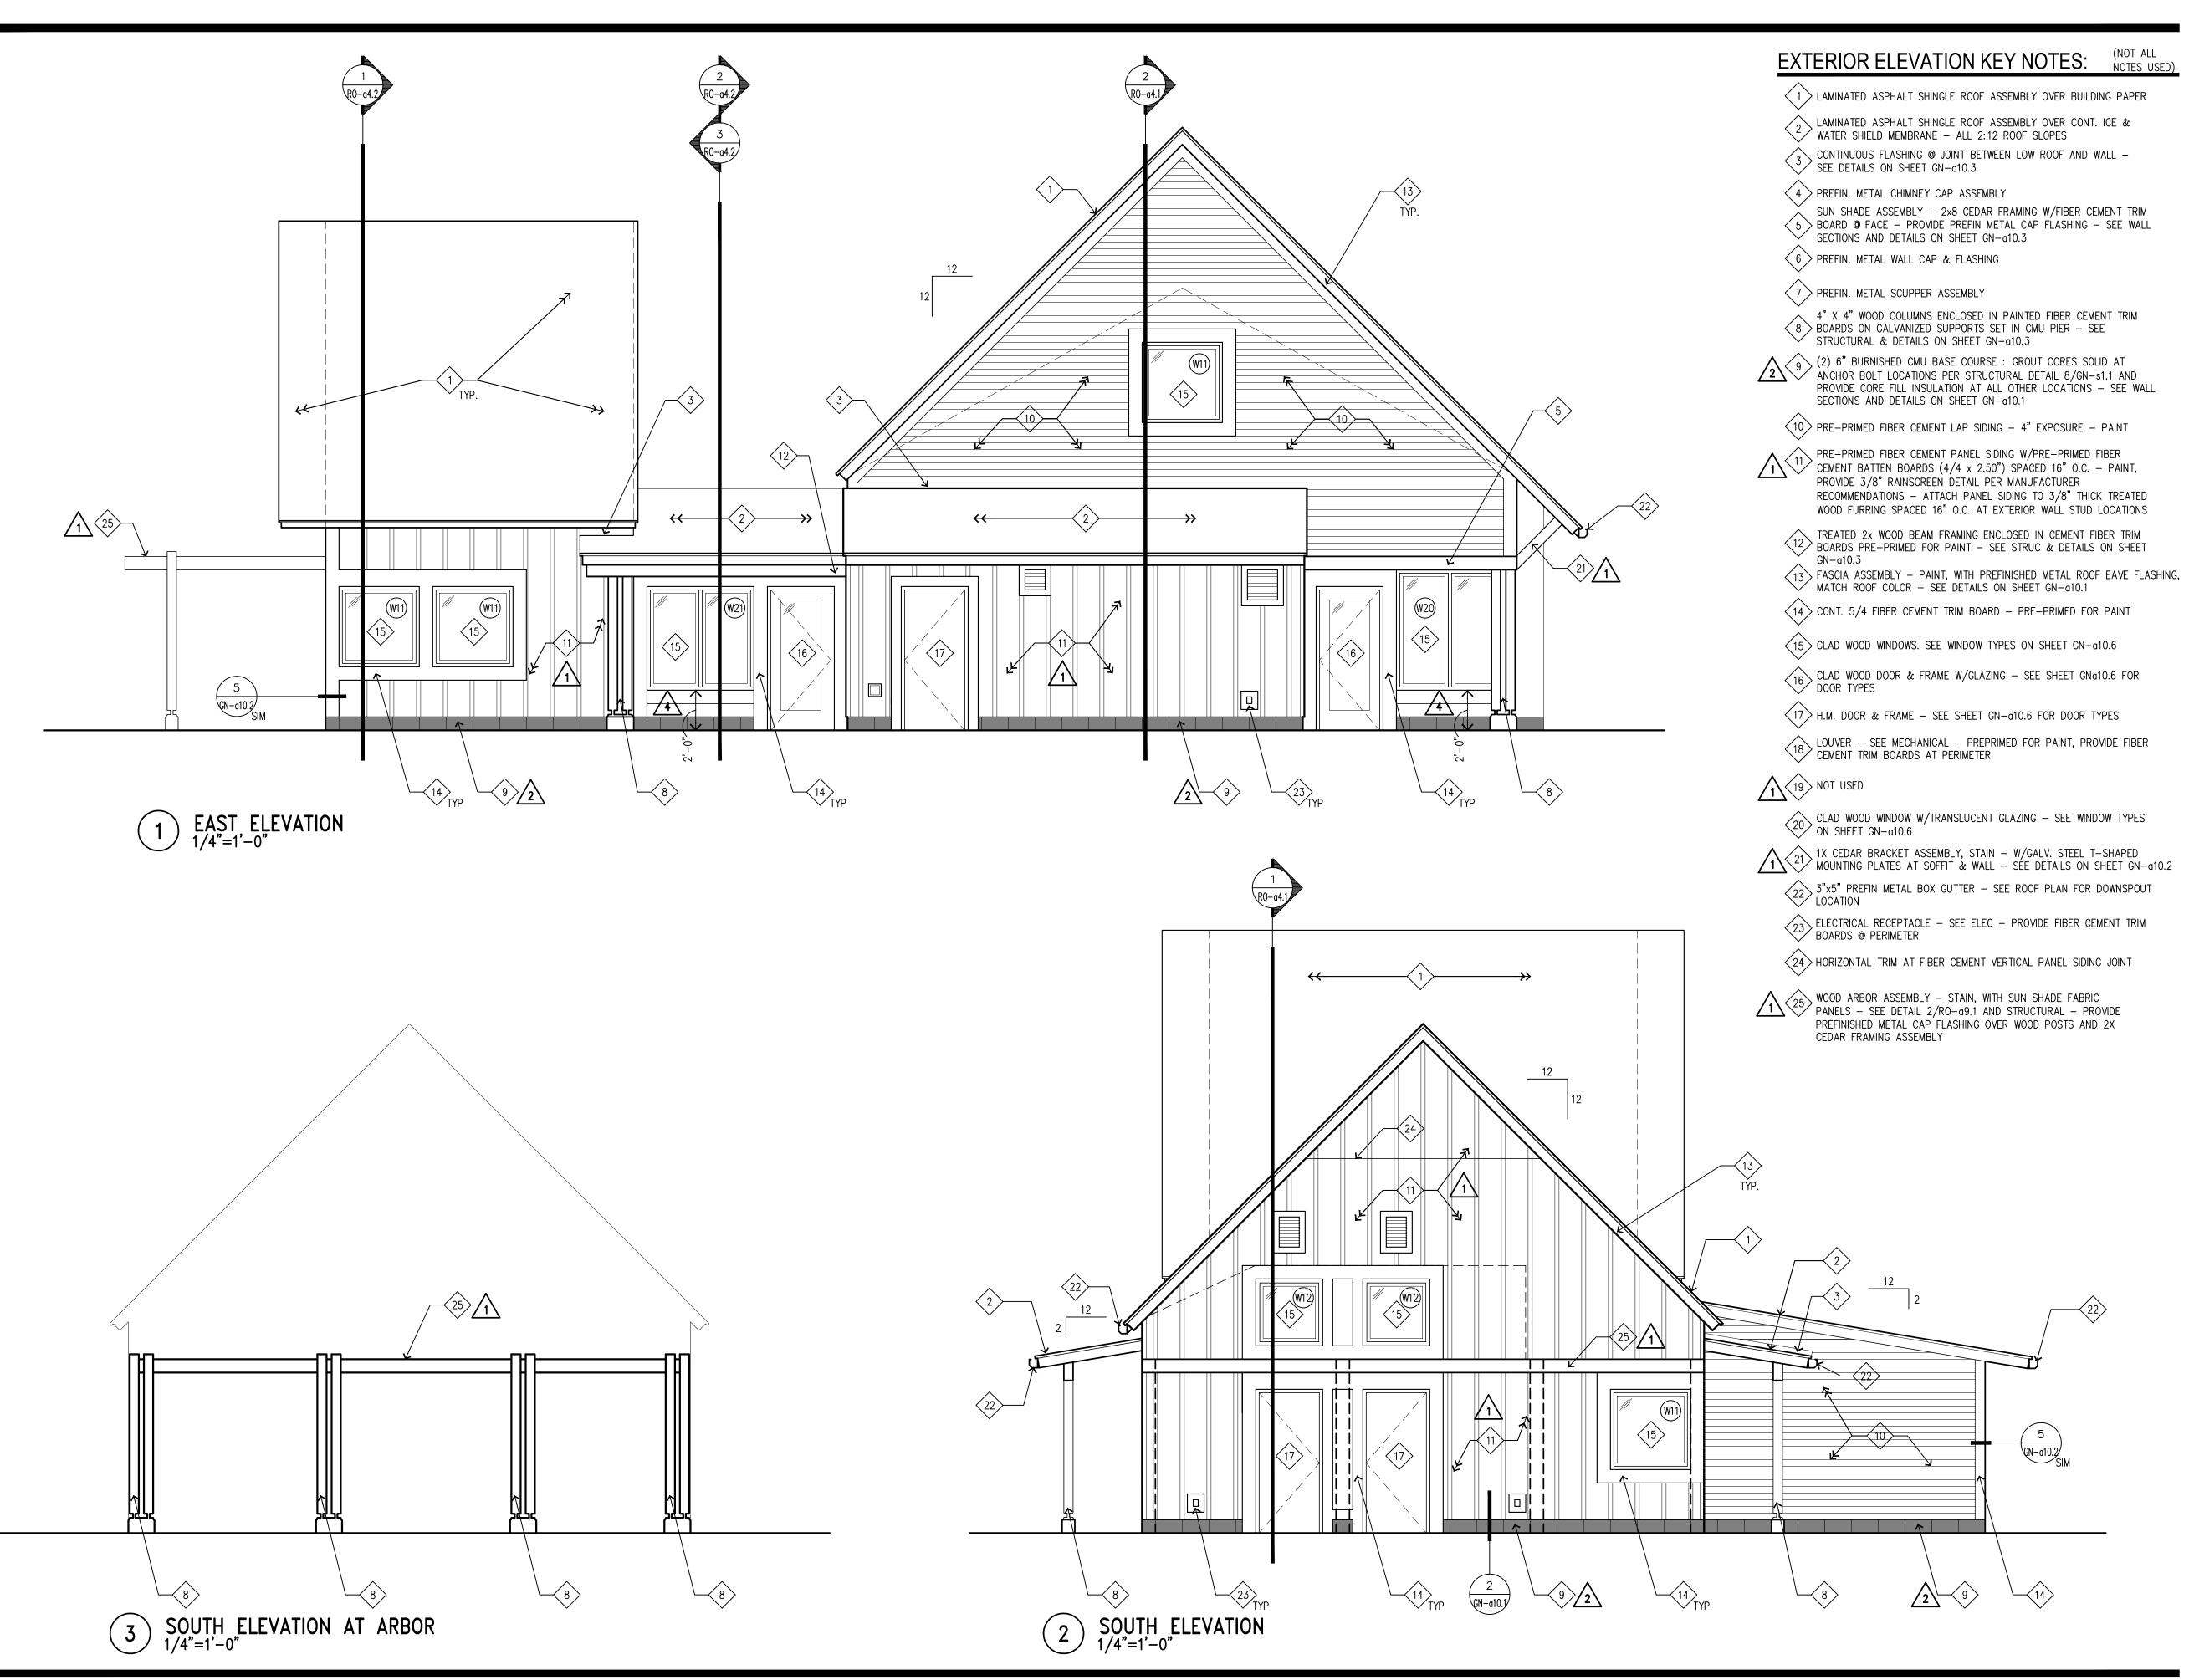



2660 CIVIC CENTER DRIVE ROSEVILLE, MINNESOTA 55113



PERFORMANCE DRIVEN DESIGN.

250 3rd Ave. N, Ste 450 | Minneapolis, MN 55401 | 612.338.2029

LHBcorp.com



HAGEN, CHRISTENSEN & MCILWAIN

4201 CEDAR AVENUE SO. • MINNEAPOLIS, MN 55407 TEL. (612) 904 - 1332 • FAX (612) 904 - 7366

ARCHITECT#

I hereby certify that this drawing was prepared by me or under my direct supervision and that I am a duly registered architect under the laws of the State of Minnesota.

MATILIPE TOM MALWAM

BY: TIM McILWAIN		N TITLE: ARCHITECT
DA [*]	TE: 1/21/14	REG. NO.: 22541
5	6/10/2014	CONSTRUCTION SET
4	1/21/2014	BID
3	12/20/2013	90% REVIEW SET

10/07/2013 90% REVIEW SET

FINAL DESIGN

ISSUED FOR

9/11/2013

DATE

4	6/04/2014	ADDENDUM #4	
3	2/28/2014	ADDENDUM #3	
2	2/25/2014	ADDENDUM #2	
$\overline{\Lambda}$	2/11/2014	ADDENDUM #1	
	D. 4 T. T.	DE: ((0) 0) 1	

COPYRIGHT 2014 BY LHB, INC. ALL RIGHTS RESERVED

ROSEVILLE PARKS AND RECREATION RENEWAL PROGRAM


ROSEBROOK PARK 2590 FRY STREET ROSEVILLE, MINNESOTA 55113

DRAWING TITLE:

EXTERIOR ELEVATIONS

FILE: 1353RO-a3.1a3.2.dwg DRAWN BY: JRG CHECKED BY: DRL PROJ. NO: 1353 DRAWING NO:

RO-a3.2

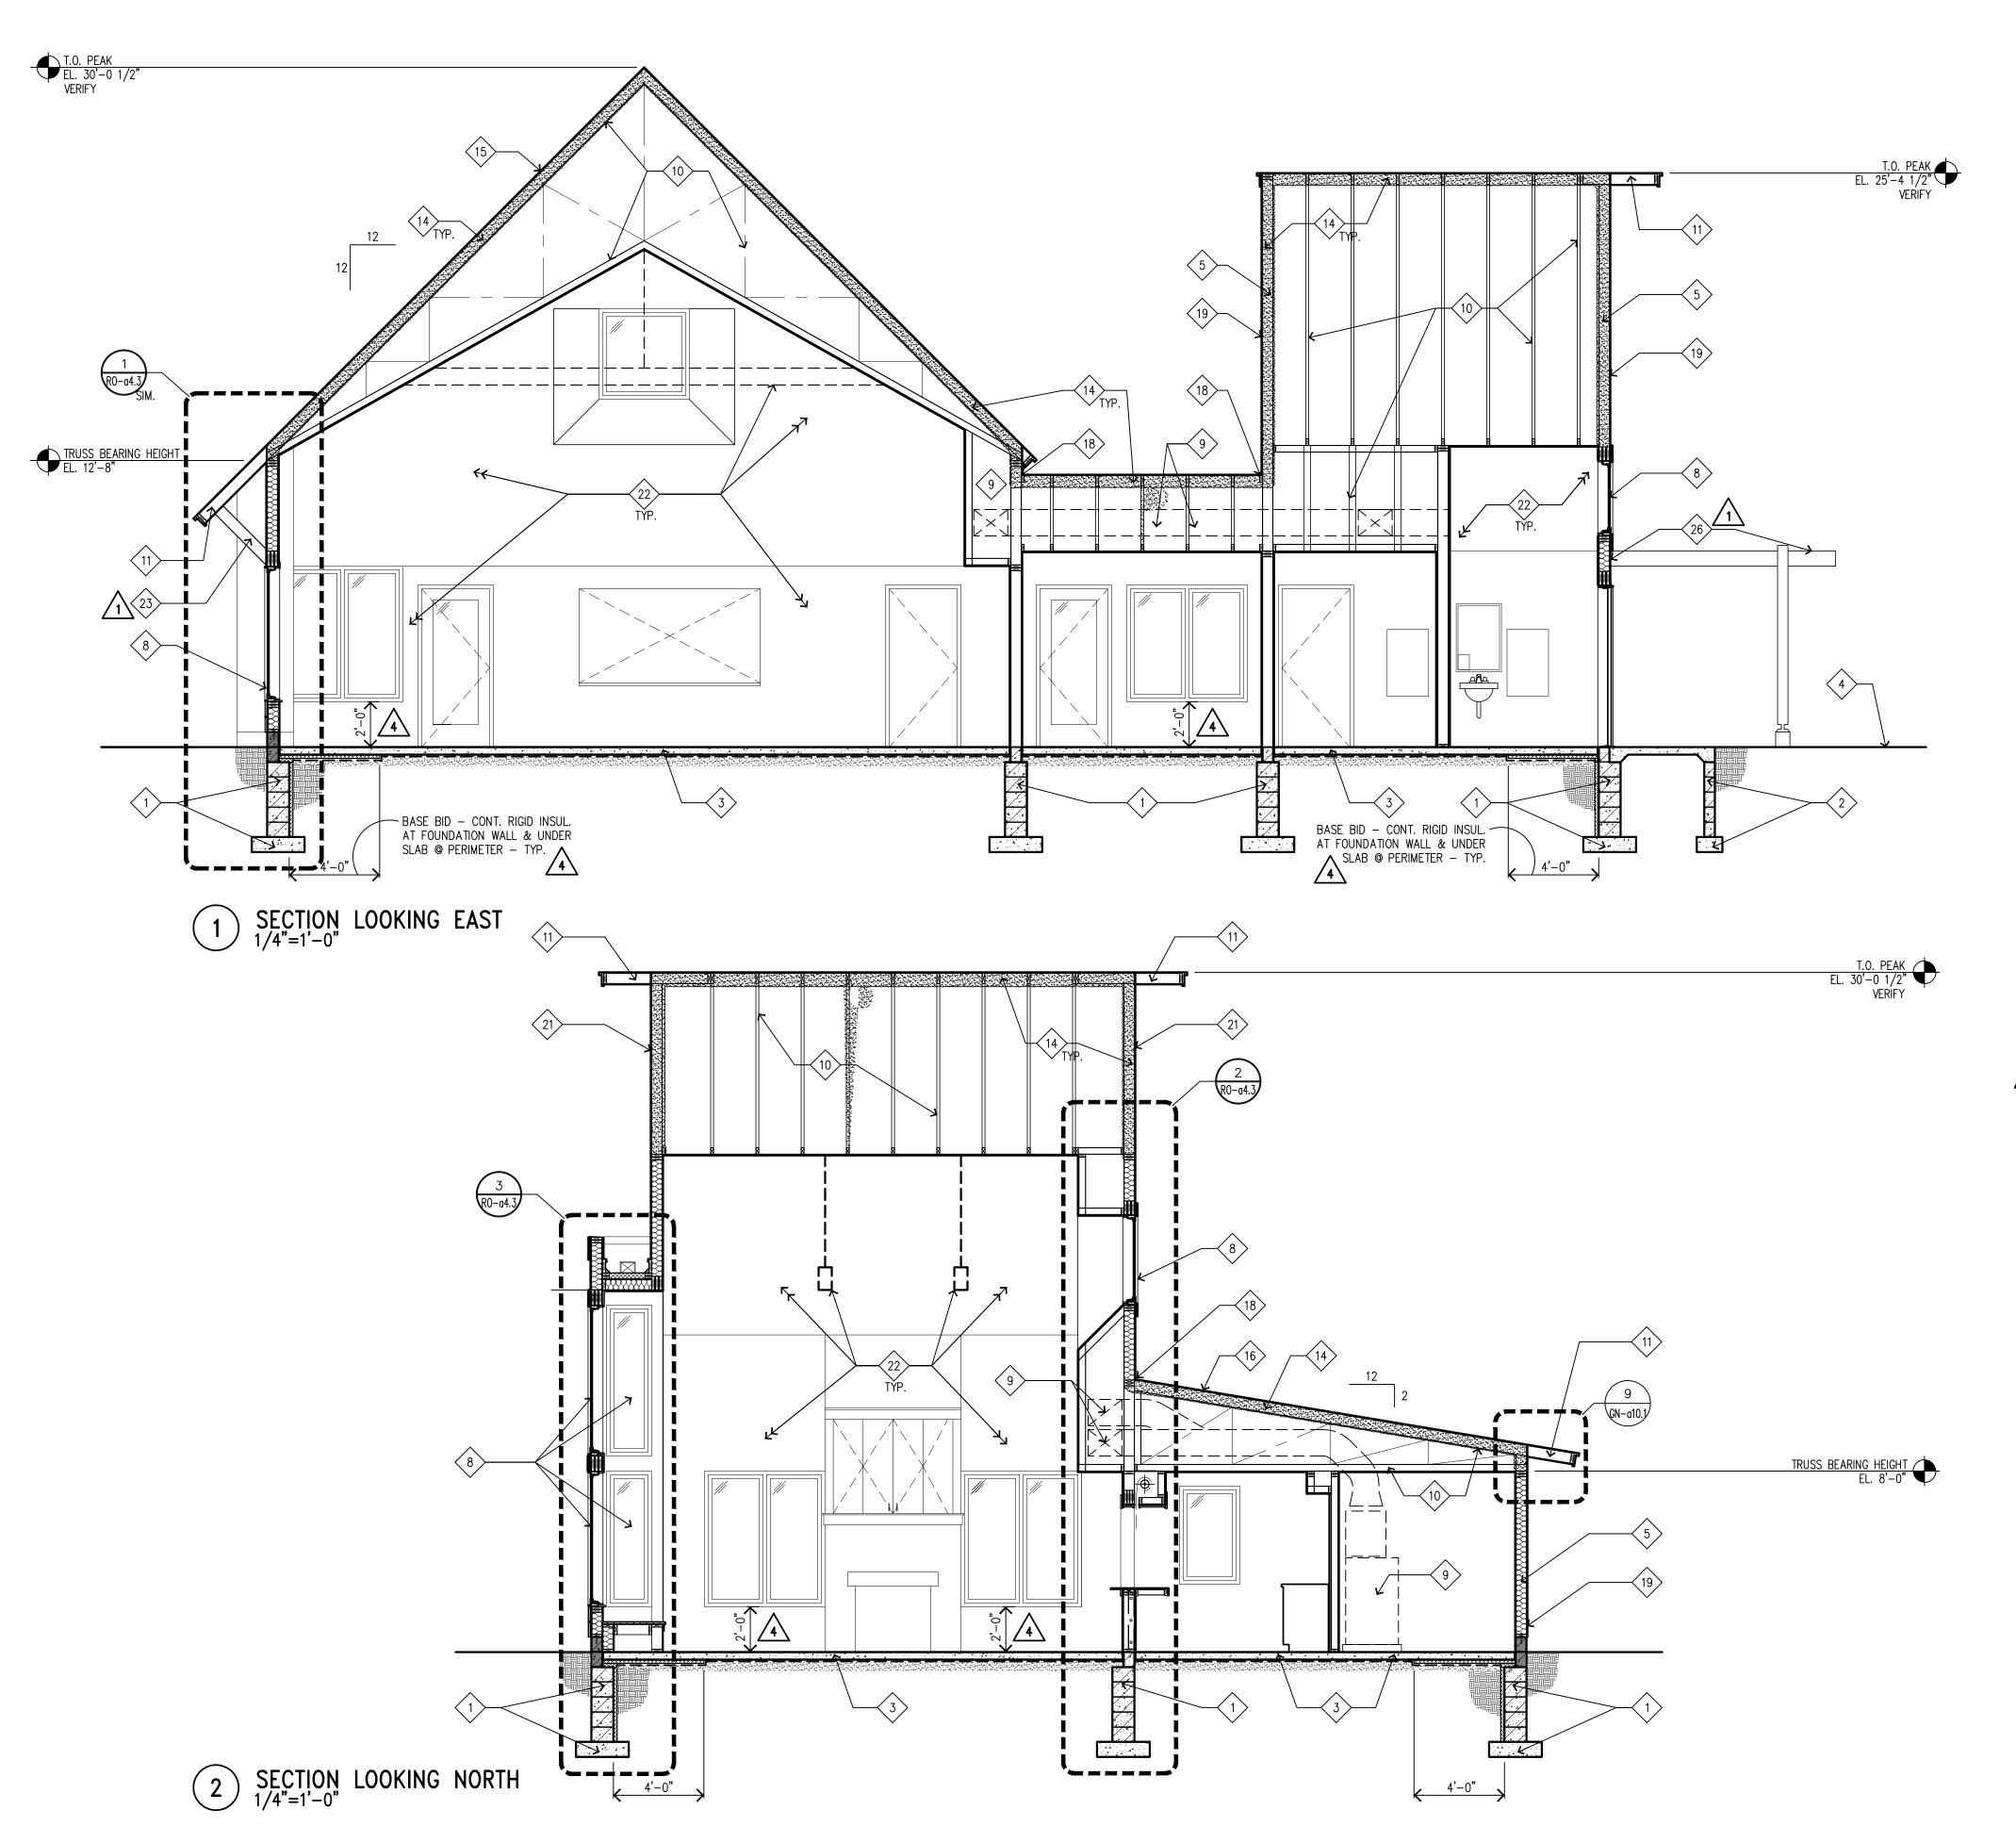

BUILDING SECTION KEY NOTES: (NOT ALL NOTES USED)

- (1) FOOTINGS & FOUNDATION WALLS SEE STRUCTURAL
- 2 CONCRETE STOOP SEE STRUCTURAL

4" CONC. SLAB OVER VAPOR BARRIER ON COMPACTED FILL — SEE STRUCTURAL.

- 4 EXTERIOR CONCRETE PAVING AND SITE WORK BY OTHERS
- 2 x 6 WOOD STUD WALL, INSULATE WALL CAVITIES, OVER BURNISHED CMU BASE COURSE SEE WALL SECTIONS ON SHEET a4.3
- 4" X 4" WOOD COLUMNS ENCLOSED IN PAINTED FIBER CEMENT TRIM BOARDS ON GALVANIZED SUPPORTS SET IN CMU PIER SEE STRUCTURAL & DETAILS ON SHEET GN—a10.3
- CLAD WOOD DOOR & FRAME W/GLAZING SEE SHEET GN—a10.6 FOR DOOR TYPES
- 8 CLAD WOOD WINDOWS SEE SHEET GN—a10.6 FOR WINDOW SIZES
- MECHANICAL DUCT WORK AND EQUIPMENT SEE MECHANICAL
- PRE-ENGINEERED WOOD TRUSSES SEE STRUCTURAL
- 2 x 6 TRUSS RAFTER TAIL EXTENSIONS @ ALL ROOF OVERHANGS, TYPICAL SEE WALL SECTIONS & DETAILS ON SHEET GN—a10.1
- 2 x 6 TRUSS RAFTER TAIL EXTENSIONS @ FRONT ENTRY CANOPY SEE WALL SECTIONS AND DETAILS ON SHEET GN—a10.3
- TREATED 2 x WOOD BEAM FRAMING ENCLOSED IN FIBER CEMENT TRIM BOARDS PRE-PRIMED FOR PAINT SEE STRUC AND DETAILS ON SHEET GN—a10.3
- SPRAY FOAM INSULATION @ ALL ROOF SHEATHING, ROOF TRUSS AND END WALL CONDITIONS SEE DETAILS ON SHEET GN—a10.1
- LAMINATED ASPHALT SHINGLE ROOF ASSEMBLY OVER BUILDING PAPER
- LAMINATED ASPHALT SHINGLE ROOF ASSEMBLY OVER CONT. ICE &
- WATER SHIELD MEMBRANE ALL 2:12 ROOF SLOPES
- PROVIDE ICE & WATER SHIELD MEMBRANE AT VALLEY (3'-0" EA SIDE OF VALLEY)
- CONTINUOUS FLASHING @ JOINT BETWEEN LOW ROOF AND WALL SEE DETAIL 5/GN-a10.1
- PRE-PRIMED FIBER CEMENT PANEL SIDING W/PRE-PRIMED FIBER CEMENT BATTEN BOARDS SPACED 16" O.C. PAINT
- SUN SHADE ASSEMBLY 2x8 CEDAR FRAMING W/PREFIN METAL CAP FLASHING, ANCHOR TO WALL W/ 2x8 CEDAR LEDGER BOARD AND STEEL PLATE BRACKET SEE STRUCTURAL
- PRE-PRIMED FIBER CEMENT LAP SIDING PAINT
- FOR INTERIOR ELEVATIONS, SEE a7.1 AND a7.2
- 1X CEDAR BRACKET ASSEMBLY, STAIN W/GALV. STEEL T-SHAPED MOUNTING PLATES AT SOFFIT & WALL SEE DETAILS ON SHEET GN-a10.2
- PROVIDE CONTINUOUS BREAK METAL PAN FLASHING ENTIRE LENGTH OF VALLEY LAP ICE AND WATER SHIELD MEMBRANE OVER FLASHING AND EXTEND UP 10-0" EACH SIDE OF VALLEY
- 25 WRAP CONTINUOUS ICE AND WATER SHEILD UP 6'-0"
- \(\sqrt{26} \) WOOD SEE DI

WOOD ARBOR ASSEMBLY-STAIN, W/ SUN SHADE FABRIC PANELS. SEE DETAIL 2/RO-a9.1 & STRUCTURAL, PROVIDE PREFINISHED METAL CAP FLASHING OVER WOOD POSTS & 2x CEDAR FRAMING ASSEMBLY.



ROSEVILLE PARKS & RECREATION

2660 CIVIC CENTER DRIVE ROSEVILLE, MINNESOTA 55113



PERFORMANCE DRIVEN DESIGN.

250 3rd Ave. N, Ste 450 | Minneapolis, MN 55401 | 612.338.2029



ARCHITECT \$
4201 CEDAR AVENUE SO. • MINNEAPOLIS, MN 55407

TEL. (612)904-1332 • FAX (612)904-7366

I hereby certify that this drawing was prepared by me or under my direct supervision and that I am a duly registered architect under the laws of the State of Minnesota.

NATURE:

TITLE: ARCHITECT

BY: TIM MCILWAIN

D	ATE: 1/21/14	REG. NO.: 22541	
5	6/10/2014	CONSTRUCTION SET	
4	1/21/2014	BID	
3	12/20/2013	90% REVIEW SET	
2	10/07/2013	90% REVIEW SET	
1	9/11/2013	FINAL DESIGN	
NO	DATE	ISSUED FOR	

4	6/04/2014	ADDENDUM #4	
$\sqrt{3}$	2/28/2014	ADDENDUM #3	
2	2/25/2014	ADDENDUM #2	
Λ	2/11/2014	ADDENDUM #1	
NO	DATE	DEVICION	

COPYRIGHT 2014 BY LHB, INC. ALL RIGHTS RESERVED

ROSEVILLE PARKS AND RECREATION RENEWAL PROGRAM


ROSEBROOK PARK 2590 FRY STREET ROSEVILLE, MINNESOTA 55113

DRAWING TITLE:

EXTERIOR ELEVATIONS

FILE: 1353RO-a4.1a4.2.dwg DRAWN BY: JRG CHECKED BY: DRL PROJ. NO: 1353 DRAWING NO:

RO-a4.1

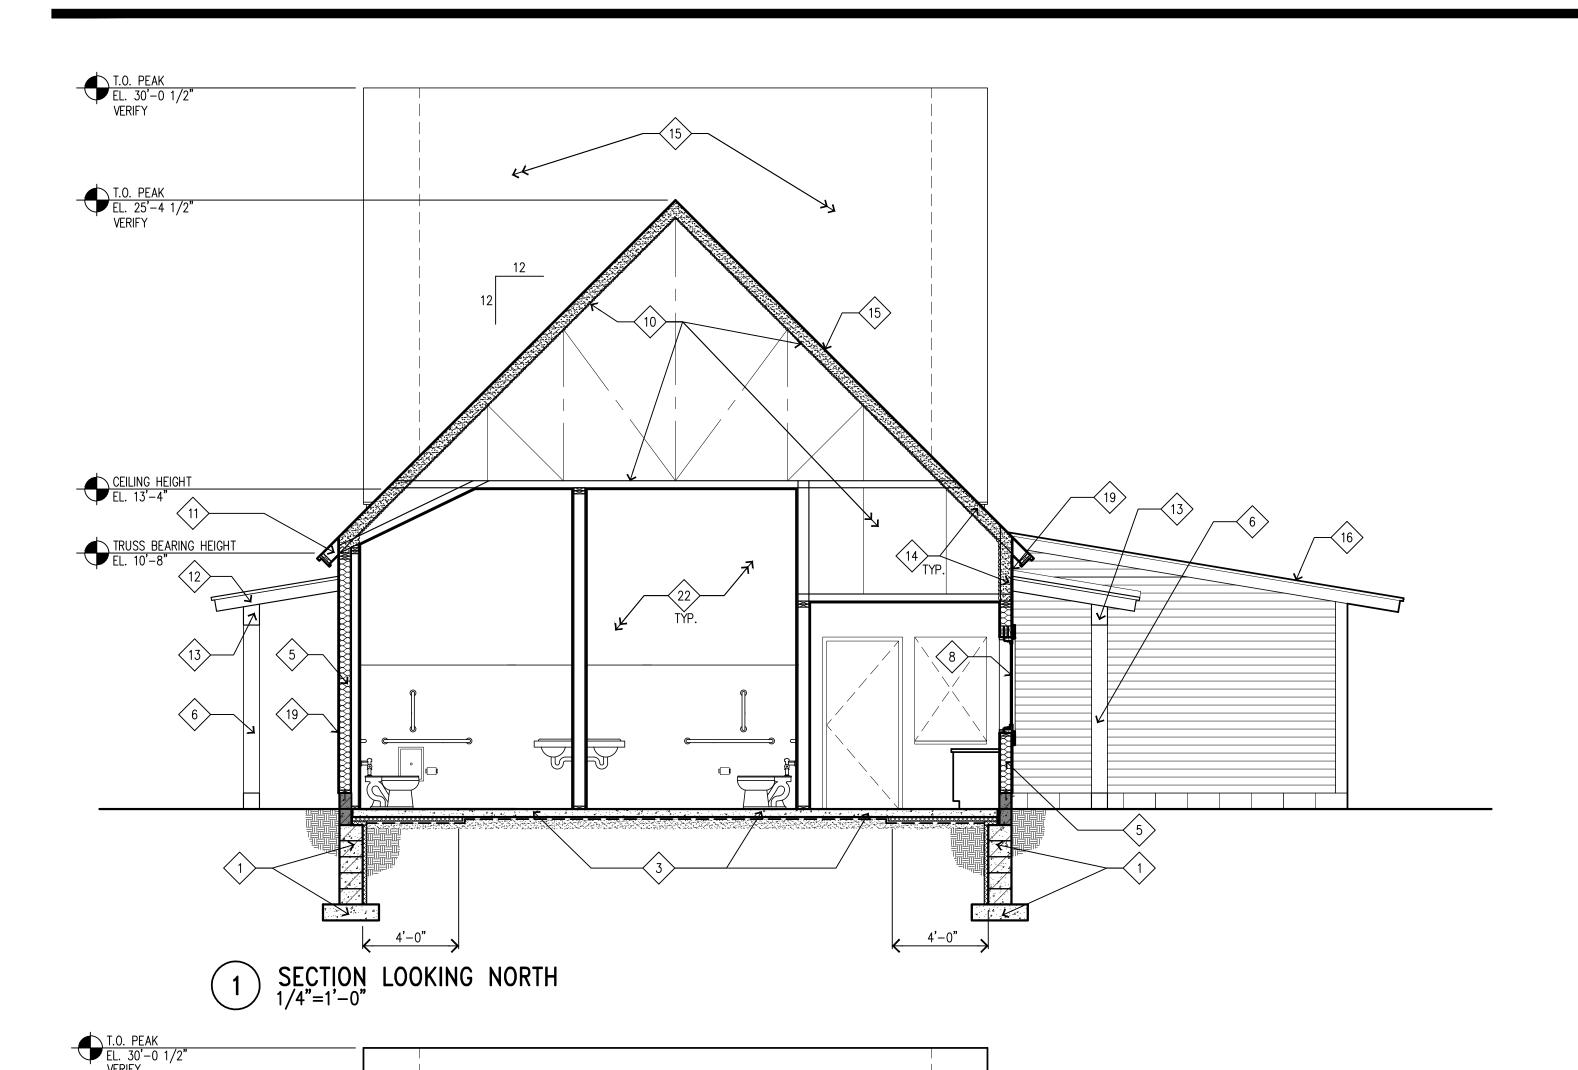

4

2 SECTION LOOKING WEST

BUILDING SECTION KEY NOTES: (NOT ALL NOTES USED)

- 1 FOOTINGS & FOUNDATION WALLS SEE STRUCTURAL
- 2 CONCRETE STOOP SEE STRUCTURAL
- 4" CONC. SLAB OVER VAPOR BARRIER ON COMPACTED FILL SEE
- 4 EXTERIOR CONCRETE PAVING AND SITE WORK BY OTHERS
- 2 x 6 WOOD STUD WALL, INSULATE WALL CAVITIES, OVER BURNISHED CMU BASE COURSE SEE WALL SECTIONS ON SHEET a4.3
- 4" X 4" WOOD COLUMNS ENCLOSED IN PAINTED FIBER CEMENT TRIM BOARDS ON GALVANIZED SUPPORTS SET IN CMU PIER SEE STRUCTURAL & DETAILS ON SHEET GN—a10.3
- CLAD WOOD DOOR & FRAME W/GLAZING SEE SHEET GN-a10.6 FOR DOOR TYPES
- 8 CLAD WOOD WINDOWS SEE SHEET GN-a10.6 FOR WINDOW SIZES
- 9 MECHANICAL DUCT WORK AND EQUIPMENT SEE MECHANICAL
- O PRE-ENGINEERED WOOD TRUSSES SEE STRUCTURAL
- 2 x 6 TRUSS RAFTER TAIL EXTENSIONS @ ALL ROOF OVERHANGS, TYPICAL SEE WALL SECTIONS & DETAILS ON SHEET GN—a10.1
- 2 x 6 TRUSS RAFTER TAIL EXTENSIONS @ FRONT ENTRY CANOPY SEE WALL SECTIONS AND DETAILS ON SHEET GN-a10.3
- TREATED 2 x WOOD BEAM FRAMING ENCLOSED IN FIBER CEMENT TRIM BOARDS PRE-PRIMED FOR PAINT SEE STRUC AND DETAILS ON SHEET GN-a10.3
- SPRAY FOAM INSULATION @ ALL ROOF SHEATHING, ROOF TRUSS AND END WALL CONDITIONS SEE DETAILS ON SHEET GN—a10.1

- 15 LAMINATED ASPHALT SHINGLE ROOF ASSEMBLY OVER BUILDING PAPER
- LAMINATED ASPHALT SHINGLE ROOF ASSEMBLY OVER CONT. ICE & WATER SHIELD MEMBRANE ALL 2:12 ROOF SLOPES
- PROVIDE ICE & WATER SHIELD MEMBRANE AT VALLEY (3'-0" EA SIDE OF VALLEY)
- CONTINUOUS FLASHING @ JOINT BETWEEN LOW ROOF AND WALL SEE DETAIL 5/GN-a10.1
- PRE—PRIMED FIBER CEMENT PANEL SIDING W/PRE—PRIMED FIBER CEMENT BATTEN BOARDS SPACED 16" O.C. PAINT
- SUN SHADE ASSEMBLY 2x8 CEDAR FRAMING W/PREFIN METAL CAP FLASHING, ANCHOR TO WALL W/ 2x8 CEDAR LEDGER BOARD AND STEEL PLATE BRACKET SEE STRUCTURAL
 - > PRE-PRIMED FIBER CEMENT LAP SIDING PAINT
 - FOR INTERIOR ELEVATIONS, SEE a7.1 AND a7.2
- 1X CEDAR BRACKET ASSEMBLY, STAIN W/GALV. STEEL T-SHAPED MOUNTING PLATES AT SOFFIT & WALL SEE DETAILS ON SHEET GN-a10.2
 - PROVIDE CONTINUOUS BREAK METAL PAN FLASHING ENTIRE LENGTH OF VALLEY LAP ICE AND WATER SHIELD MEMBRANE OVER FLASHING AND EXTEND UP 10-0" EACH SIDE OF VALLEY
- 25 WRAP CONTINUOUS ICE AND WATER SHEILD UP 6'-0"



WOOD ARBOR ASSEMBLY-STAIN, W/ SUN SHADE FABRIC PANELS. SEE DETAIL 2/RO-a9.1 & STRUCTURAL, PROVIDE PREFINISHED METAL CAP FLASHING OVER WOOD POSTS & 2x CEDAR FRAMING ASSEMBLY.



ROSEVILLE PARKS & RECREATION

2660 CIVIC CENTER DRIVE ROSEVILLE, MINNESOTA 55113



PERFORMANCE DRIVEN DESIGN. LHBcorp.com

250 3rd Ave. N, Ste 450 | Minneapolis, MN 55401 | 612.338.2029



ARCHITECT \$

4201 OEDAR AVENUE SO. • MINNEAPOLIS, MN 55407 TEL. (612) 904 - 1332 • FAX (612) 904 - 7366

I hereby certify that this drawing was prepared by me or under my direct supervision and that I am a duly registered architect under the laws of the State of Minnesota.

CONTINE TAM MALLOW

5	6/10/2014	CONSTRUCTION SET
4	1/21/2014	BID
3	12/20/2013	90% REVIEW SET
2	10/07/2013	90% REVIEW SET
1	9/11/2013	FINAL DESIGN
NO	DATE	ISSUED FOR

4	6/04/2014	ADDENDUM #4	
$\sqrt{3}$	2/28/2014	ADDENDUM #3	
$\overline{2}$	2/25/2014	ADDENDUM #2	
$\overline{\Lambda}$	2/11/2014	ADDENDUM #1	

COPYRIGHT 2014 BY LHB, INC. ALL RIGHTS RESERVED

ROSEVILLE PARKS
AND RECREATION
RENEWAL PROGRAM


ROSEBROOK PARK 2590 FRY STREET ROSEVILLE, MINNESOTA 55113


DRAWING TITLE:

EXTERIOR ELEVATIONS

FILE:
DRAWN BY:
CHECKED BY:
PROJ. NO: 1353
DRAWING NO:

RO-a4.2

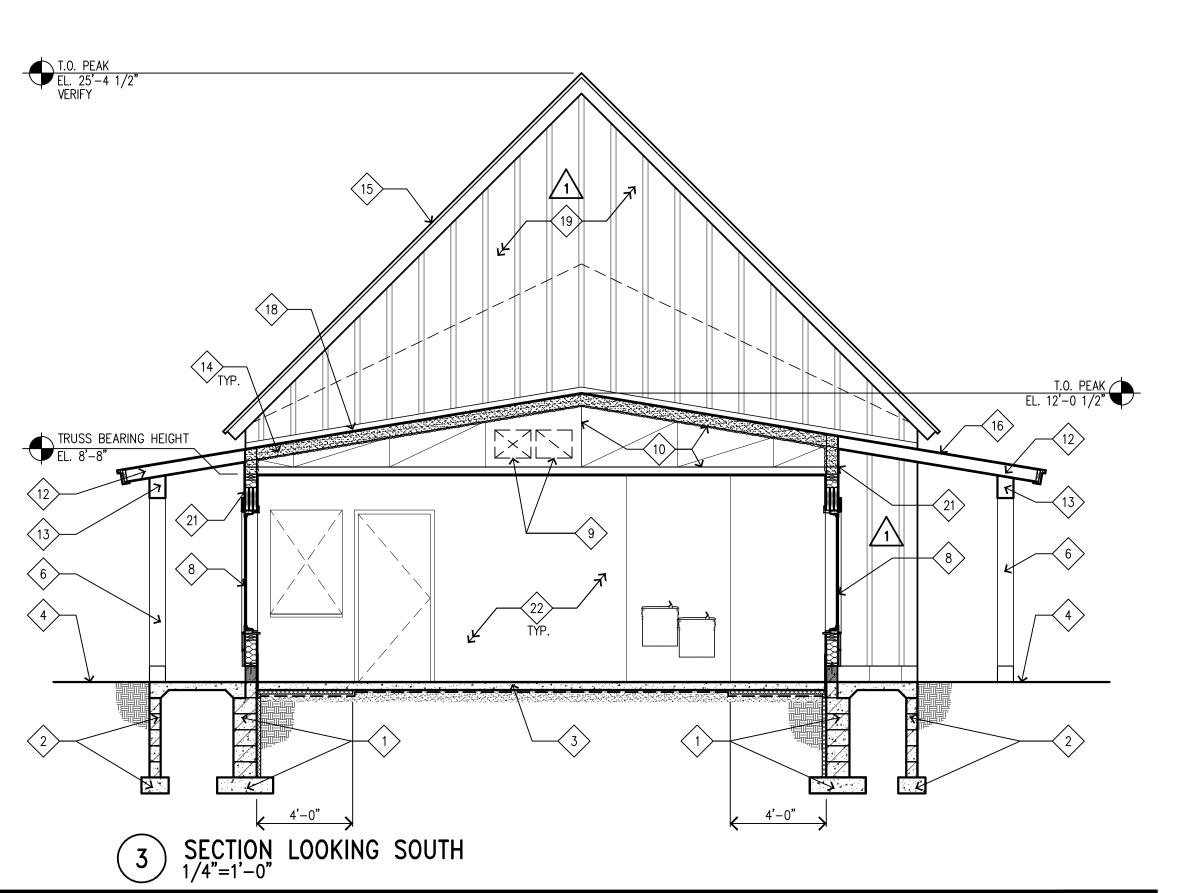

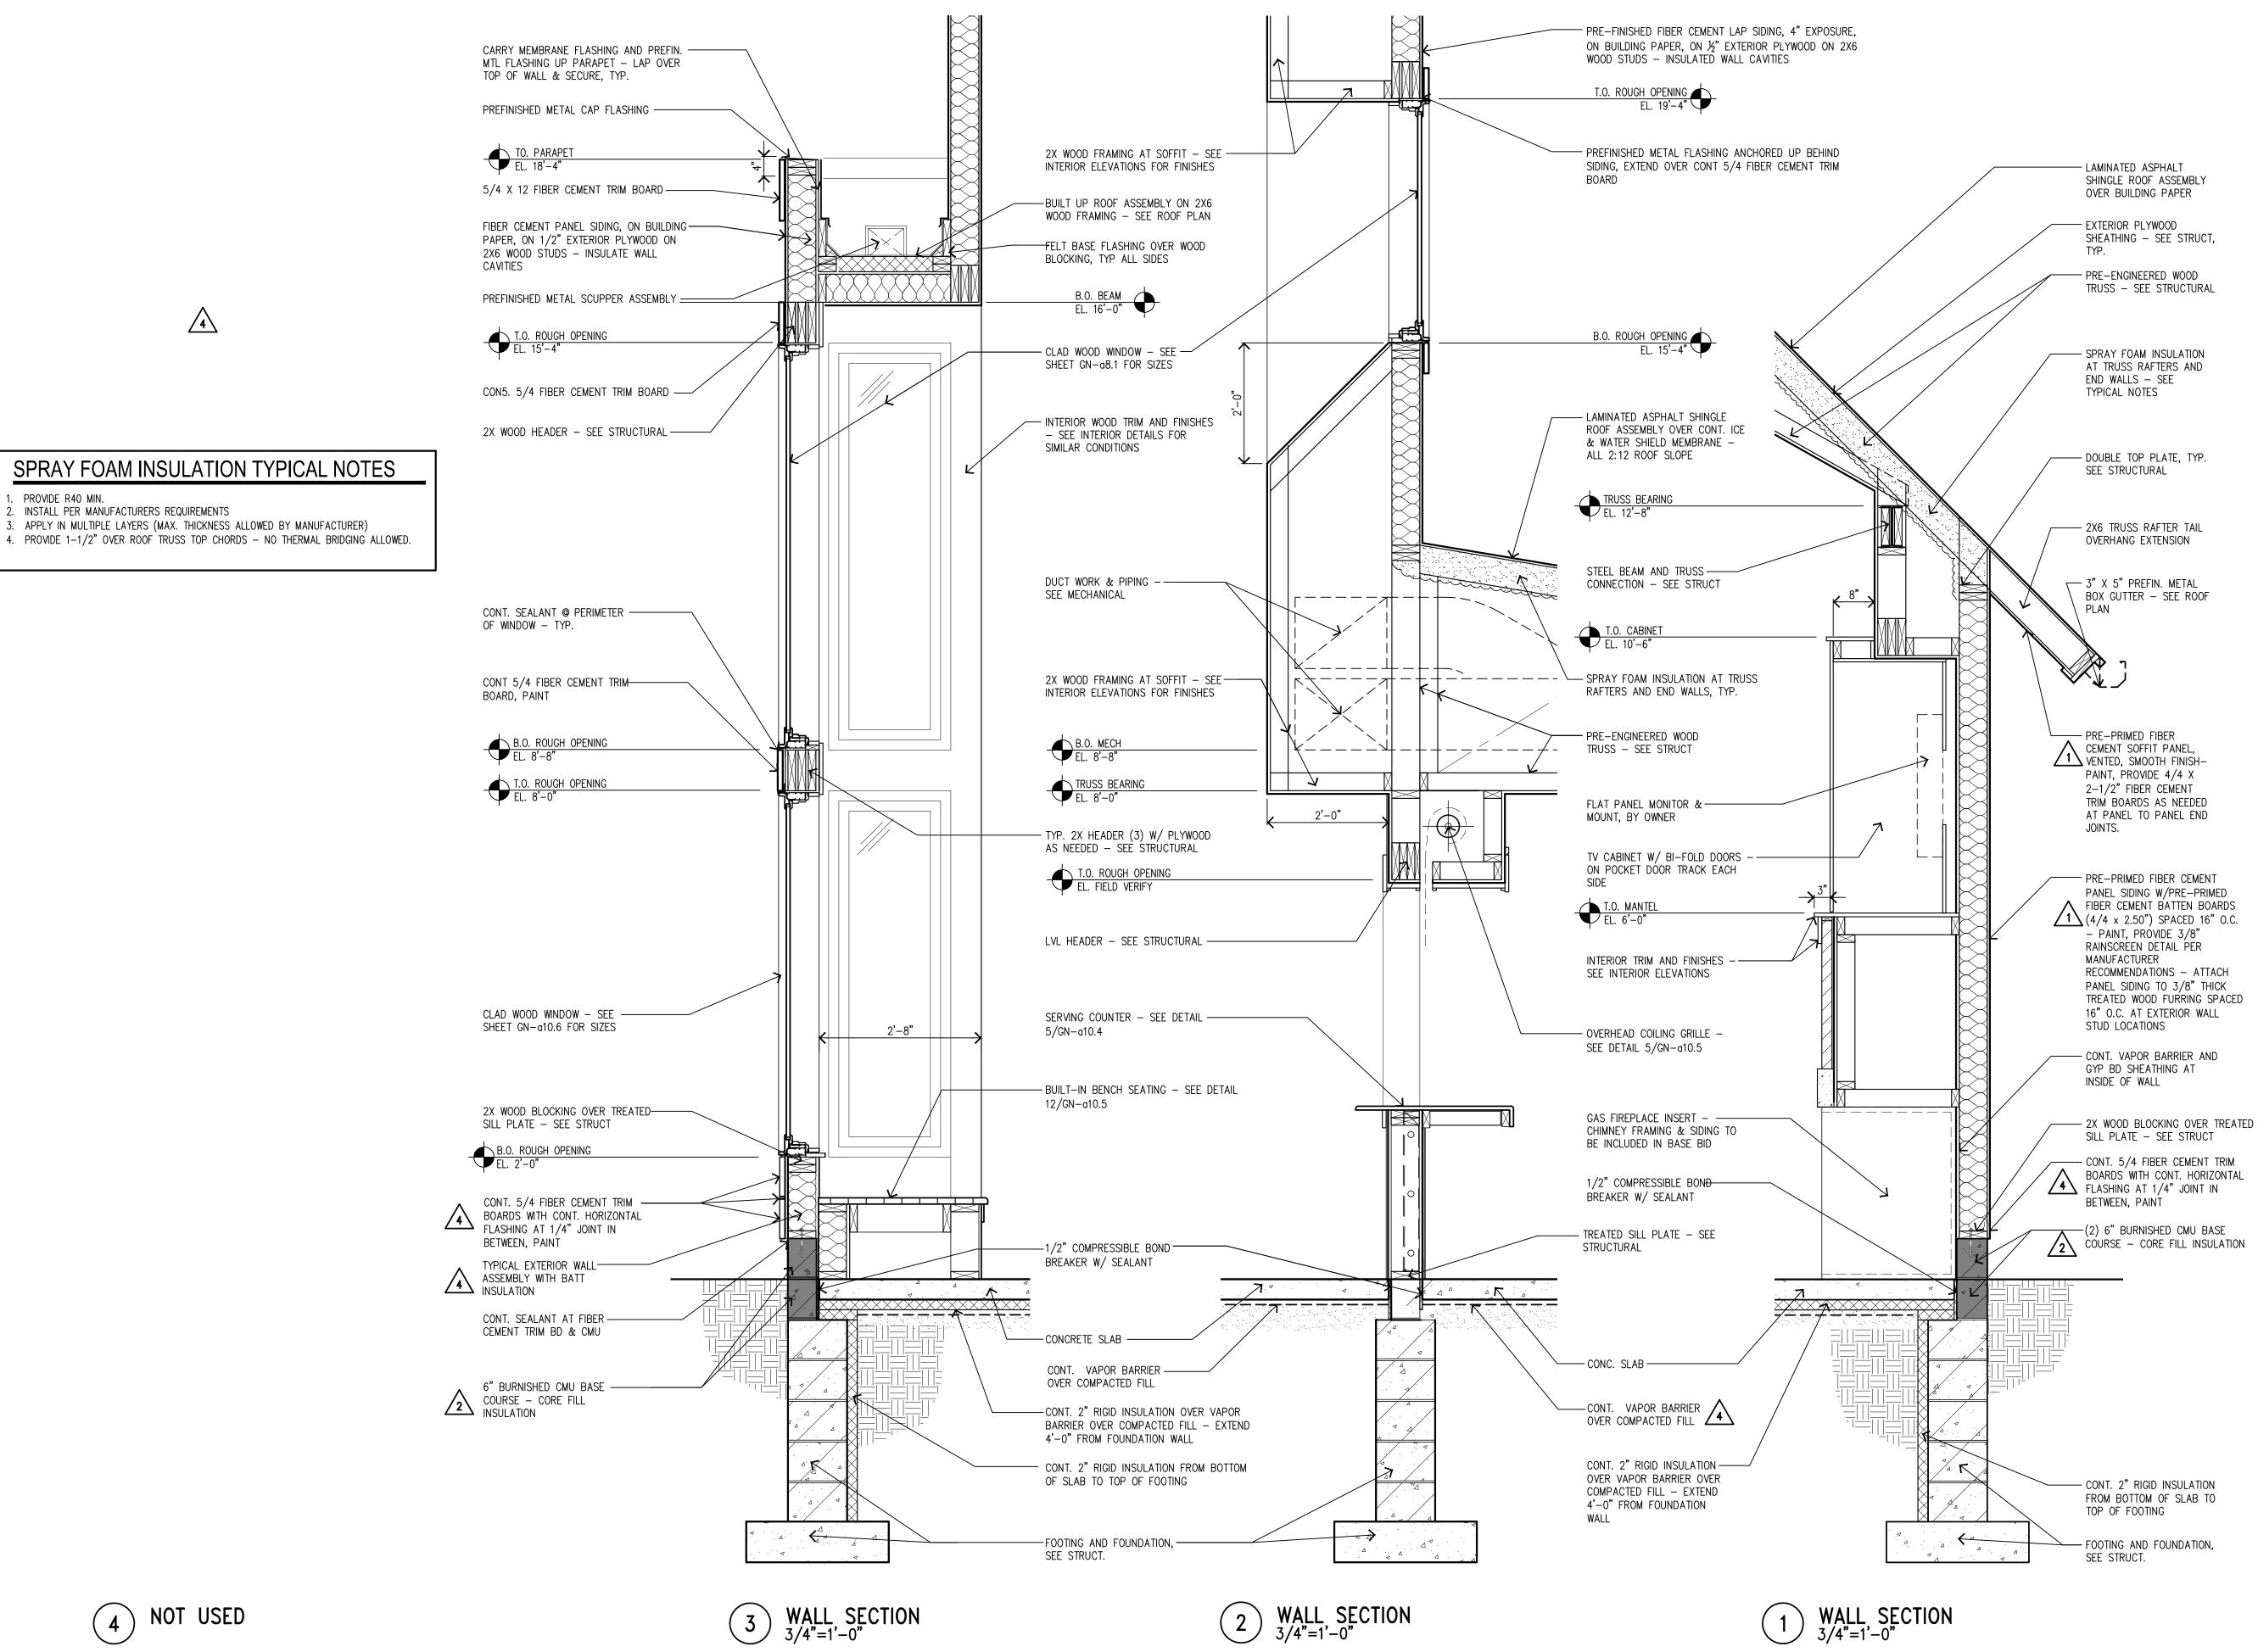



2660 CIVIC CENTER DRIVE ROSEVILLE, MINNESOTA 55113



PERFORMANCE DRIVEN DESIGN.

250 3rd Ave. N, Ste 450 | Minneapolis, MN 55401 | 612.338.2029

LHBcorp.com



4201 CEDAR AVENUE SO. • MINNEAPOLIS, MN 55407

4201 CEDAR AVENUE SO. • MINNEAPOLIS, MN 55407 TEL. (612) 904 - 1332 • FAX (612) 904 - 7366

I hereby certify that this drawing was prepared by me or under my direct supervision and that I am a duly registered architect under the laws of the State of Minnesota.

SICHATURE THE MALMAN

B	Y: TIM MCILWAIN	I TITLE: ARCHITECT
D	ATE: 1/21/14	REG. NO.: 22541
5	6/10/2014	CONSTRUCTION SET
4	1/21/2014	BID
3	12/20/2013	90% REVIEW SET
2	10/07/2013	90% REVIEW SET

9/11/2013 FINAL DESIGN

DATE

4	6/04/2014	ADDENDUM #4	
$\sqrt{3}$	2/28/2014	ADDENDUM #3	
2	2/25/2014	ADDENDUM #2	
$\overline{\Lambda}$	2/11/2014	ADDENDUM #1	
NO	DATE	REVISION	

ISSUED FOR

COPYRIGHT 2014 BY LHB, INC. ALL RIGHTS RESERVED.

ROSEVILLE PARKS
AND RECREATION
RENEWAL PROGRAM


ROSEBROOK PARK 2590 FRY STREET ROSEVILLE, MINNESOTA 55113

DRAWING TITLE:

EXTERIOR ELEVATIONS

FILE: 1353RO-a4.3.dwg DRAWN BY: JRG CHECKED BY: DRL PROJ. NO: 1353 DRAWING NO:


RO-a4.3

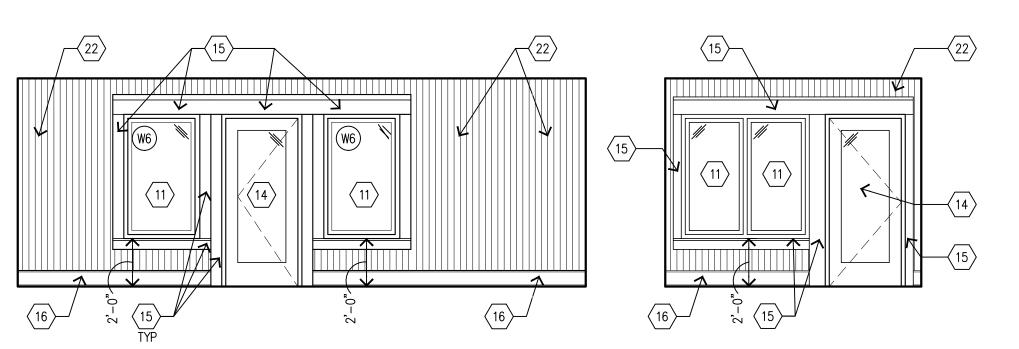


4 VESTIBULE WEST ELEVATION

1/4"=1'-0"


3 VESTIBULE SOUTH ELEVATION

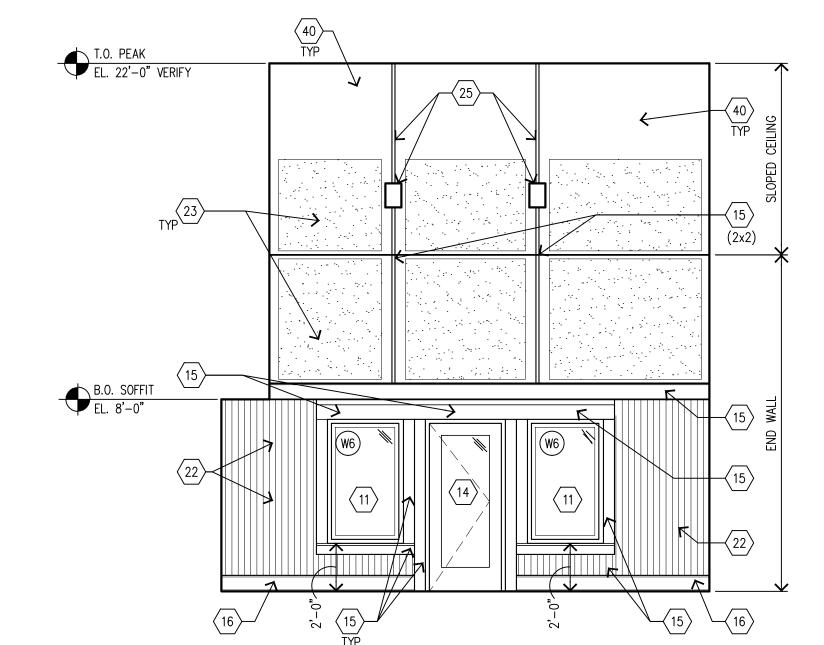

6 GATHERING SPACE EAST ELEVATION

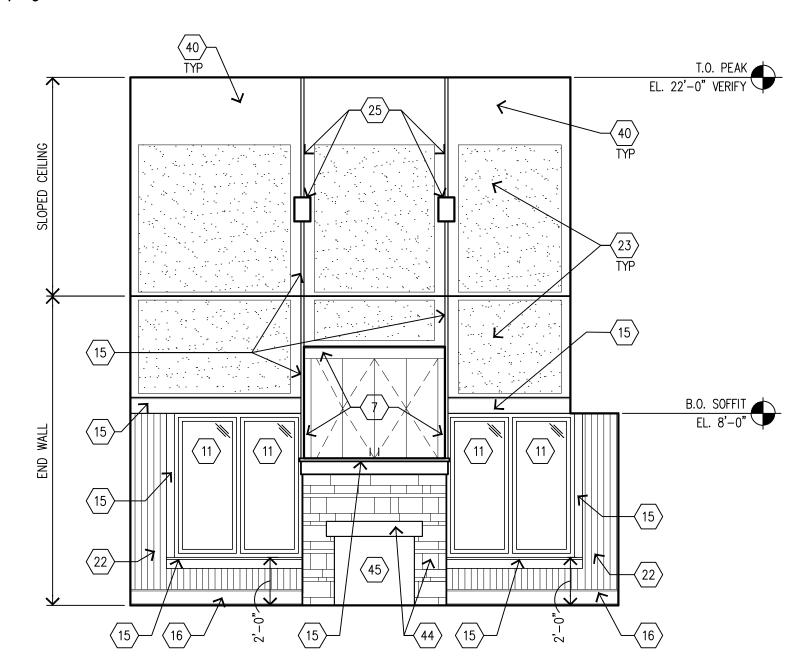


8 GATHERING SPACE WEST ELEVATION 1/4"=1'-0"

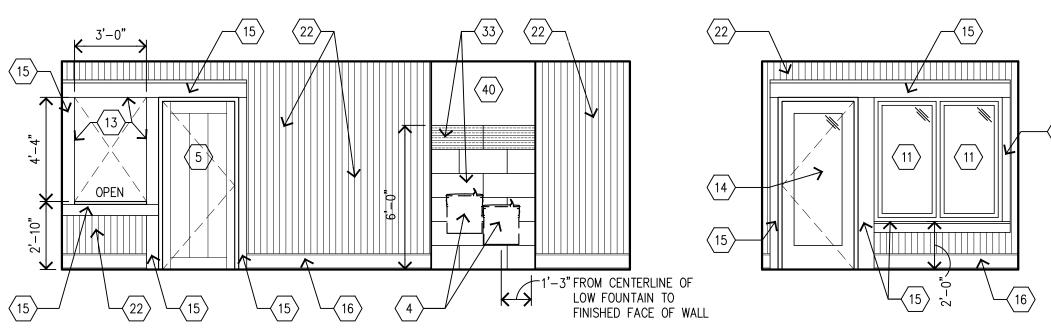


2 VESTIBULE EAST ELEVATION
1/4"=1'-0"

1 VESTIBULE NORTH ELEVATION (1)

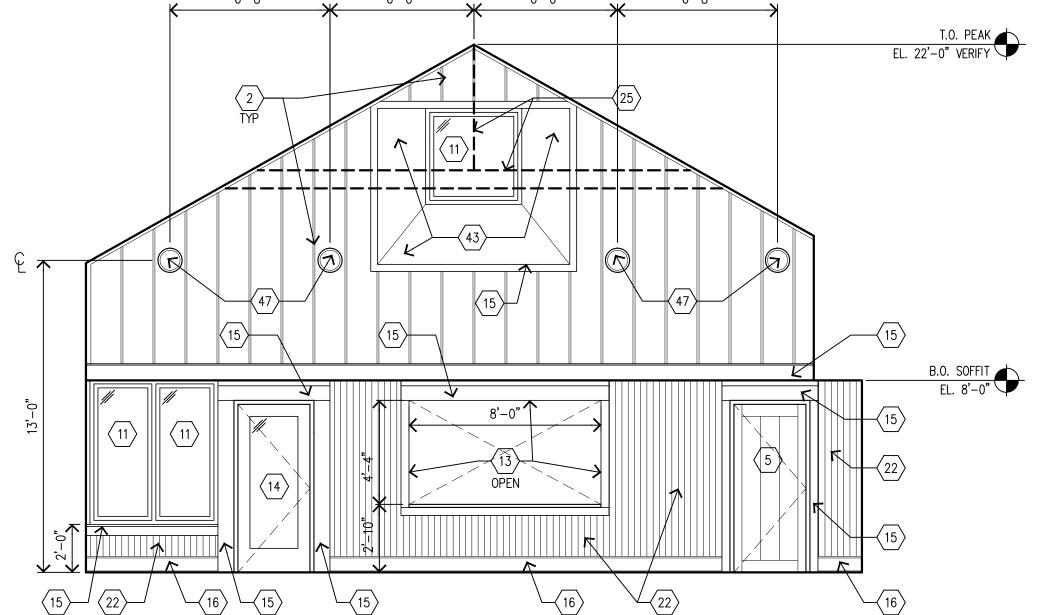

5 GATHERING SPACE NORTH ELEVATION

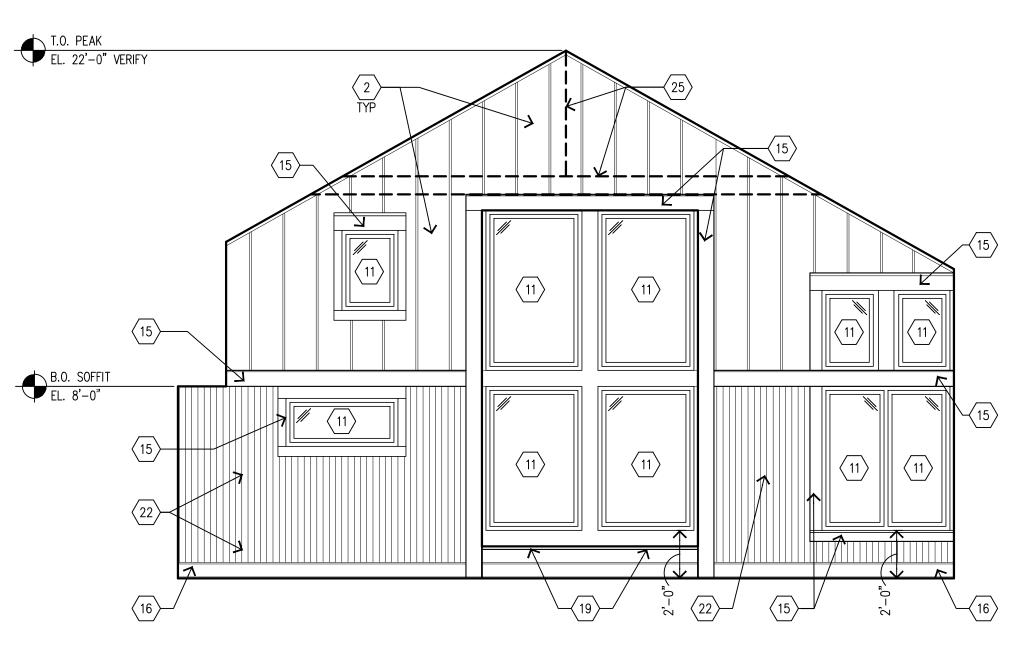

7 GATHERING SPACE SOUTH ELEVATION

INTERIOR ELEVATION GENERAL NOTES:

- SEE PROJECT MANUAL FOR FINISH SPECIFICATIONS AND INSTALLATION INSTRUCTIONS.
 ALL PAINTED METAL GRILLS, LOUVERS, DIFFUSERS ETC. TO BE FINISHED TO MATCH THE
- MATERIAL ON WHICH THEY APPEAR.
- 3. CEILING HEIGHTS ARE SHOWN ON REFLECTED CEILING PLANS.
- 4. SEE REFLECTED CEILING PLAN SHEET a9.1 FOR CEILING FINISH INFORMATION.5. REFER TO THE INTERIOR FINISH SCHEDULE FOR ALL FINISHES IN THE TOILET ROOMS.
- REFER TO THE DIVISION 10 SPECIFICATIONS FOR ALL TOILET ROOM ACCESSORY PRODUCT INFORMATION.
- 7. TRASH RECEPTACLE PROVIDED BY OWNER N.I.C.
- 8. ALL TOILETS TO BE MOUNTED WITH RIM 15" A.F.F., 18" A.F.F. @ ACCESSIBLE STALL.
- 9. URINALS TO BE MOUNTED WITH LIP 17" A.F.F. @ ACCESSIBLE URINALS.
- 10. REFER TO SHEETS a2.1 FOR PARTITION TYPE KEY.
- 11. ALL WOOD TRIM TO BE PAINTED UNLESS OTHERWISE NOTED.
- 12. REFER TO DETAILS IN GENERAL SET FOR TYPICAL WINDOW AND DOOR TRIM DETAILS

INTERIOR ELEVATION KEY NOTES: (NOT ALL NOTES USED)

- 1 SST HOOKS
- 2 > 2x2 WOOD BATTEN BOARDS SPACED 16" O.C. OVER GYP BD PAINT
- 3 BENCHES, BY OWNER
- 4 HIGH/LOW DRINKING FOUNTAIN SEE MECH.
- $\langle 5 \rangle$ WOOD DOOR AND H.M. FRAME SEE a2.1 FOR DOOR SCHEDULE
- REFRIGERATOR, BY OWNER
- 7 > TV CABINET
- BASE CABINET WITH P.LAM EXTERIOR, MELAMINE INTERIOR, SOLID SURFACE COUNTERTOP/BACKSPLASH, & 4" SST. HANDLE SEE DETAILS ON GN—a10.4
- 9 UPPER CABINET WITH P.LAM EXTERIOR, MELAMINE INTERIOR, & 4" SST
- HANDLE SEE DETAILS ON GN—a10.4

 SINK SEE MECHANICAL INSULATE ALL HOT WATER AND WASTE PIPING PER A.D.A. STANDARDS, TYP.
- (11) CLAD WOOD WINDOWS. SEE WINDOW TYPES ON SHEET GN-a10.6 STAIN
- PROVIDE FINISHED ENDS ON EXPOSED MILLWORK ENDS, TYP. AT BASE CABINETS
- AND PROVIDE CONT. P.LAM CLEAT AT BACK AND END WALLS AT WORK COUNTER

 13 PROVIDE FINISHED WOOD FACE AT INTERIOR OPENING PAINT
- (14) CLAD WOOD DOOR AND FRAME W/GLAZING, SEE a2.1 FOR DOOR SCHEDULE
- 14
- (15) INTERIOR WOOD TRIM PAINT, SEE DETAILS ON GN—a10.5
- $\langle 16 \rangle$ WOOD BASE ASSEMBLY, SEE DETAILS ON GN-a10.5
- 17 MICROWAVE, BY OWNER
- (18) VINYL BASE SEE a2.1i FOR FINISHES
- $\langle 19 \rangle$ WINDOW BENCH SEATING SEE DETAIL 12/GN-a10.5
- SCHLUTER COVE BASE W/TILE BASE OR WALL TILE ABOVE SEE a2.1i
- 21 SCHLUTER TOP EDGE SEE a2.1i
- BEAD BOARD PANELING W/ SHIP LAP JT. PAINT
- FABRIC WRAPPED ACOUSTIC PANELS SEE a2.11 AND a9.1
- CLAD WOOD WINDOW W/TRANSLUCENT/ PRIVACY GLAZING SEE WINDOW TYPES ON SHEET GN-a10.6
- $\langle 25 \rangle$ BEAM ASSEMBLY AND STL ROD SEE DETAILS ON GN-a10.5
- (26) MECH DIFFUSER SEE MECHANICAL
- BATTERY OPERATED PAPER TOWEL DISPENSER BY OWNER
- 28 STAINLESS STEEL GRAB BAR
- SURFACE MOUNTED TOILET TISSUE DISPENSER (1 PER STALL)
- SURFACE MOUNTED SOAP DISPENSER MOUNT TO MIRROR AS SHOWN. VERIFY WITH OWNER
- 31 SOLID PLASTIC TOILET PARTITION OR URINAL SCREEN
- $\langle 32 \rangle$ SURFACE MOUNTED SANITARY NAPKIN DISPENSER (1 PER STALL @ WOMEN'S)
- 33 CERAMIC WALL TILE SEE a2.11 FOR INTERIOR FINISHES
- SOLID SURFACE COUNTERTOP w/INTEGRAL BOWL(S). INSULATE ALL HOT WATER AND WASTE PIPING PER A.D.A. STANDARDS, TYP.
- MIRROR $(3'-0"h \times 2'-0"w)$ w/ TOP AND BOTTOM BRUSHED ALUM. CHANNEL. PROVIDE REQUIRED BLKG.
- 36 URINAL SEE MECHANICAL
- (37) TOILET SEE MECHANICAL
- BABY CHANGING STATION VERTICAL MOUNTING ANCHOR TO WALL SO THAT WORK
- AREA IS 34" A.F.F.
- (39) OVERHEAD COILING GRILLE ENCLOSURE SEE DETAILS ON GN-a10.5
- $\langle 40 \rangle$ GYP BD PAINT
- (41) SERVING COUNTER SEE a2.1i AND DETAILS ON GN—a10.4
- TRANSACTION COUNTER SEE a2.11 AND DETAILS ON GN-a10.4
- 43 FLARED GYP BD OPENING @ THICKENED WALL PAINT
- PRECAST CONC. MANTEL. WITH CHILTON LIMESTONE SEE TYP. COURSING ON
- PREFAB. GAS FIREPLACE INSERT, PROVIDE R.O. PER MFGR. REQ'MTS.
- 46 CORK BULLETIN BOARD BY OWNER PROVIDE REQUIRED BLKG.
- SUPPLY NOZZLE SEE MECHANICAL
- 48 GYP. BD. SOFFIT FLAT



ROSEVILLE PARKS & RECREATION

2660 CIVIC CENTER DRIVE ROSEVILLE, MINNESOTA 55113



PERFORMANCE DRIVEN DESIGN.
LHBcorp.com

250 3rd Ave. N, Ste 450 | Minneapolis, MN 55401 | 612.338.2029



ARCHITECT #

4201 CEDAR AVENUE SO. • MINNEAPOLIS, MN 55407 TEL. (612)904-1332 • FAX (612)904-7366

I hereby certify that this drawing was prepared by me or under my direct supervision and that I am a duly registered architect under the laws of the State of Minnesota.

SIGNATURE: TAM MALMEN

BY: TIM McILWAIN TITLE: ARCHITECT

REG. NO.: 22541

DATE: 1/21/14

NO DATE

5	6/10/2014	CONSTRUCTION SET
4	1/21/2014	BID
3	12/20/2013	90% REVIEW SET
2	10/07/2013	90% REVIEW SET
1	9/11/2013	FINAL DESIGN

ISSUED FOR

07/24/2014 ASI #1			
07/24/2014 ASI # 1			
	07/24/2014	ASI #1	

COPYRIGHT 2014 BY LHB, INC. ALL RIGHTS RESERVED.


ROSEVILLE PARKS
AND RECREATION
RENEWAL PROGRAM

ROSEBROOK PARK 2590 FRY STREET ROSEVILLE, MINNESOTA 55113


DRAWING TITLE:
INTERIOR ELEVATIONS

FILE: 1353RO-a7.1a7.2.dwg DRAWN BY: JRG CHECKED BY: DRL PROJ. NO: 1353 DRAWING NO:


RO-a7.1

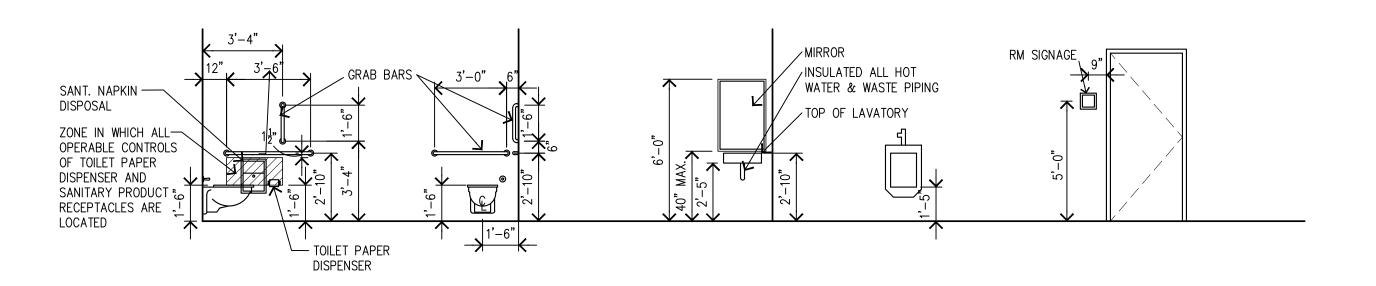


TYPICAL ACCESSIBLE MOUNTING HEIGHTS (PER MN CODE)

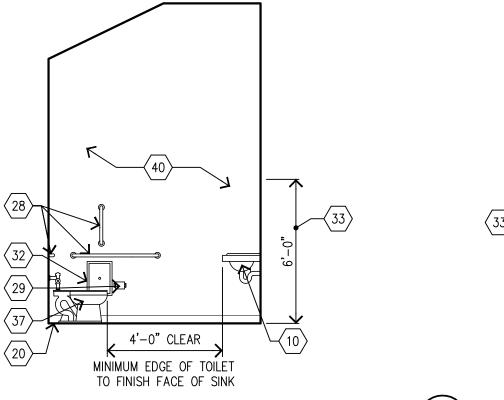




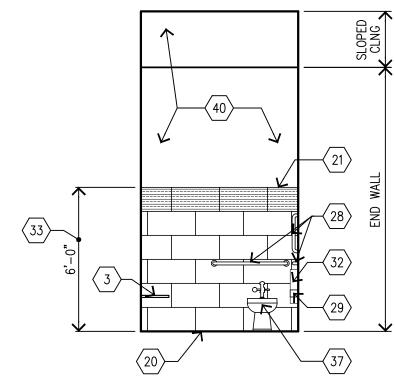


FAMILY CHANGING ROOM ELEVATION 1/4"=1'-0"

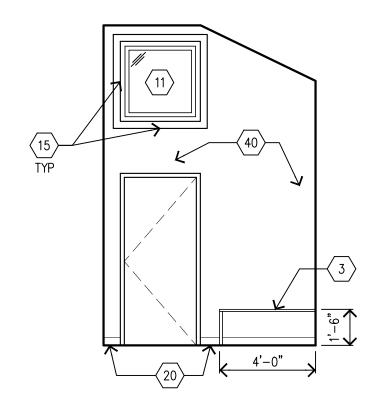


FAMILY CHANGING ROOM ELEVATION 1/4"=1'-0"

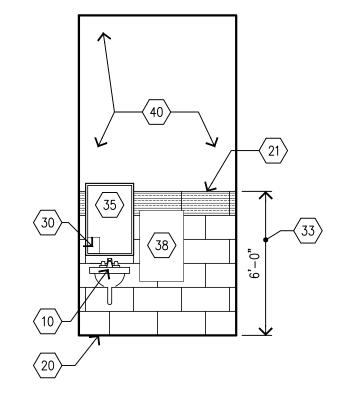


FAMILY CHANGING ROOM ELEVATION 1/4"=1'-0"

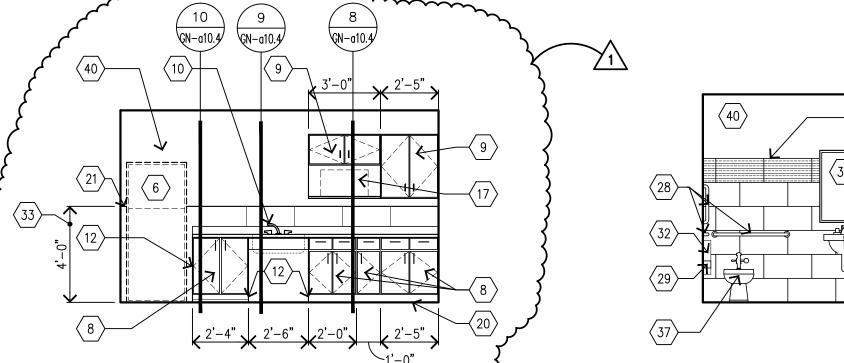


9 SERVERY NORTH ELEVATION

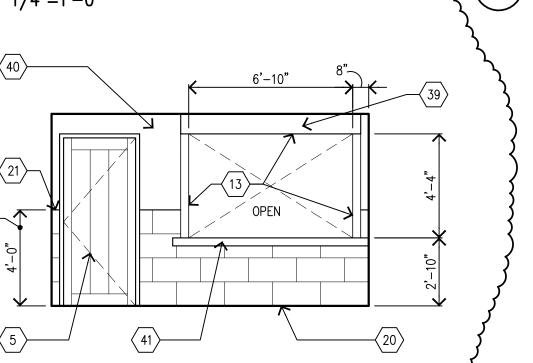

SERVERY SOUTH ELEVATION 1/4"=1'-0"

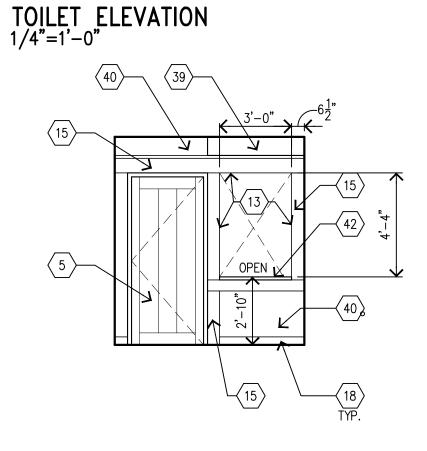



12 STAFF ROOM WEST ELEVATION

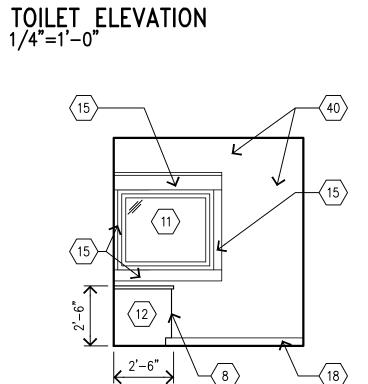

MINIMUM EDGE OF TOILET TO FINISH FACE OF WALL

11 STAFF ROOM EAST ELEVATION

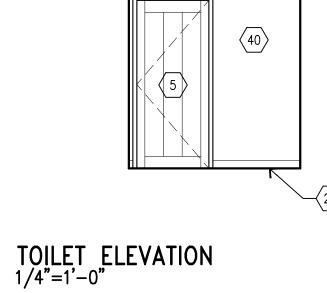

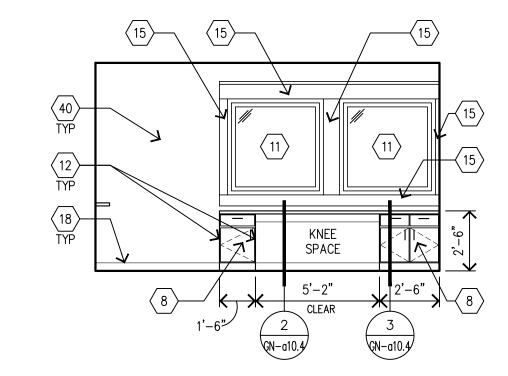

10 STAFF ROOM NORTH ELEVATION

INTERIOR ELEVATION GENERAL NOTES:

- 1. SEE PROJECT MANUAL FOR FINISH SPECIFICATIONS AND INSTALLATION INSTRUCTIONS. 2. ALL PAINTED METAL GRILLS, LOUVERS, DIFFUSERS ETC. TO BE FINISHED TO MATCH THE
- MATERIAL ON WHICH THEY APPEAR. 3. CEILING HEIGHTS ARE SHOWN ON REFLECTED CEILING PLANS.
- 4. SEE REFLECTED CEILING PLAN SHEET a9.1 FOR CEILING FINISH INFORMATION.
- 5. REFER TO THE INTERIOR FINISH SCHEDULE FOR ALL FINISHES IN THE TOILET ROOMS.
- 6. REFER TO THE DIVISION 10 SPECIFICATIONS FOR ALL TOILET ROOM ACCESSORY PRODUCT INFORMATION.
- 7. TRASH RECEPTACLE PROVIDED BY OWNER N.I.C.
- 8. ALL TOILETS TO BE MOUNTED WITH RIM 15" A.F.F., 18" A.F.F. @ ACCESSIBLE STALL.
- 9. URINALS TO BE MOUNTED WITH LIP 17" A.F.F. @ ACCESSIBLE URINALS.
- 10. REFER TO SHEETS a2.1 FOR PARTITION TYPE KEY.
- 11. ALL WOOD TRIM TO BE PAINTED UNLESS OTHERWISE NOTED.
- 12. REFER TO DETAILS IN GENERAL SET FOR TYPICAL WINDOW AND DOOR TRIM DETAILS

INTERIOR ELEVATION KEY NOTES: (NOT ALL NOTES USED)

- 1 SST HOOKS
 - 2x2 WOOD BATTEN BOARDS SPACED 16" O.C. OVER GYP BD PAINT
- (3) BENCHES, BY OWNER
- 4 HIGH/LOW DRINKING FOUNTAIN SEE MECH.
- (5) WOOD DOOR AND H.M. FRAME SEE a2.1 FOR DOOR SCHEDULE
- REFRIGERATOR, BY OWNER
- BASE CABINET WITH P.LAM EXTERIOR, MELAMINE INTERIOR, SOLID SURFACE
- COUNTERTOP/BACKSPLASH, & 4" SST. HANDLE SEE DETAILS ON GN-a10.4 UPPER CABINET WITH P.LAM EXTERIOR, MELAMINE INTERIOR, & 4" SST
- HANDLE SEE DETAILS ON GN-a10.4 SINK - SEE MECHANICAL - INSULATE ALL HOT WATER AND WASTE PIPING PER
- A.D.A. STANDARDS, TYP.
- (11) CLAD WOOD WINDOWS. SEE WINDOW TYPES ON SHEET GN-a10.6 STAIN
- PROVIDE FINISHED ENDS ON EXPOSED MILLWORK ENDS, TYP. AT BASE CABINETS AND PROVIDE CONT. P.LAM CLEAT AT BACK AND END WALLS AT WORK COUNTER
- PROVIDE FINISHED WOOD FACE AT INTERIOR OPENING PAINT
- CLAD WOOD DOOR AND FRAME W/GLAZING, SEE a2.1 FOR DOOR SCHEDULE
- INTERIOR WOOD TRIM PAINT, SEE DETAILS ON GN-a10.5
- WOOD BASE ASSEMBLY, SEE DETAILS ON GN-a10.5
- MICROWAVE, BY OWNER
- VINYL BASE SEE a2.1i FOR FINISHES
- WINDOW BENCH SEATING SEE DETAIL 12/GN-a10.5
- SCHLUTER COVE BASE W/TILE BASE OR WALL TILE ABOVE SEE a2.1i
- SCHLUTER TOP EDGE SEE a2.1i
- BEAD BOARD PANELING W/ SHIP LAP JT. PAINT
- FABRIC WRAPPED ACOUSTIC PANELS SEE a2.1i AND a9.1
- CLAD WOOD WINDOW W/TRANSLUCENT/ PRIVACY GLAZING SEE WINDOW TYPES ON SHEET GN-a10.6
- $\langle 25 \rangle$ BEAM ASSEMBLY AND STL ROD SEE DETAILS ON GN-a10.5
- (26) MECH DIFFUSER SEE MECHANICAL
- BATTERY OPERATED PAPER TOWEL DISPENSER BY OWNER
- (28) STAINLESS STEEL GRAB BAR
- SURFACE MOUNTED TOILET TISSUE DISPENSER (1 PER STALL)
- SURFACE MOUNTED SOAP DISPENSER MOUNT TO MIRROR AS SHOWN. VERIFY WITH OWNER
- 31 SOLID PLASTIC TOILET PARTITION OR URINAL SCREEN
- 32 SURFACE MOUNTED SANITARY NAPKIN DISPENSER (1 PER STALL @ WOMEN'S)
- 33 CERAMIC WALL TILE SEE a2.11 FOR INTERIOR FINISHES
- SOLID SURFACE COUNTERTOP w/ INTEGRAL BOWL(S). INSULATE ALL HOT WATER AND WASTE PIPING PER A.D.A. STANDARDS, TYP.
- MIRROR $(3'-0"h \times 2'-0"w) w/$ TOP AND BOTTOM BRUSHED ALUM. CHANNEL. PROVIDE REQUIRED BLKG.
- 36 URINAL SEE MECHANICAL
- TOILET SEE MECHANICAL
- BABY CHANGING STATION VERTICAL MOUNTING ANCHOR TO WALL SO THAT WORK
- AREA IS 34" A.F.F.
- (39) OVERHEAD COILING GRILLE ENCLOSURE SEE DETAILS ON GN—a10.5
- 40 GYP BD PAINT
- (41) SERVING COUNTER SEE a2.1i AND DETAILS ON GN-a10.4
- $\langle 42 \rangle$ TRANSACTION COUNTER SEE a2.1i AND DETAILS ON GN—a10.4
- 43 FLARED GYP BD OPENING @ THICKENED WALL PAINT
- PRECAST CONC. MANTEL. WITH CHILTON LIMESTONE SEE TYP. COURSING ON ELEVATIONS.
- PREFAB. GAS FIREPLACE INSERT, PROVIDE R.O. PER MFGR. REQ'MTS.
- 46 CORK BULLETIN BOARD BY OWNER PROVIDE REQUIRED BLKG.
- 47 SUPPLY NOZZLE SEE MECHANICAL
- 48 GYP. BD. SOFFIT FLAT



ROSEVILLE PARKS & RECREATION

2660 CIVIC CENTER DRIVE ROSEVILLE, MINNESOTA 55113



DRIVEN DESIGN. LHBcerp.com

250 3rd Ave. N, Ste 450 | Minneapolis, MN 55401 | 612.338.2029



HAGEN, CHRISTENSEN & MCILWAIN ARCHITECT#

4201 CEDAR AVENUE SO. . MINNEAPOLIS, MN 55407 TEL. (612)904-1332 • FAX (612)904-7366

I hereby certify that this drawing was prepared by me or under my direct supervision and that I am a duly registered architect under the laws of the State of Minnesota.

BY: TIM MCILWAIN	TITLE: ARCHITECT
DATE: 1/21/14	REG. NO.: 22541

5	6/10/2014	CONSTRUCTION SET	
4	1/21/2014	BID	
3	12/20/2013	90% REVIEW SET	
2	10/07/2013	90% REVIEW SET	
1	9/11/2013	FINAL DESIGN	
NO.	DATE	IOOUED FOR	

COPYRIGHT 2014 BY LHB, INC. ALL RIGHTS RESERVED

NO DATE REVISION


ROSEVILLE PARKS AND RECREATION RENEWAL PROGRAM

ROSEBROOK PARK 2590 FRY STREET **ROSEVILLE, MINNESOTA 55113**

DRAWING TITLE: INTERIOR ELEVATIONS

FILE: 1353RO-a7.1a7.2.dwg DRAWN BY: JRG CHECKED BY: DRL DRAWING NO:

RO-a7.2

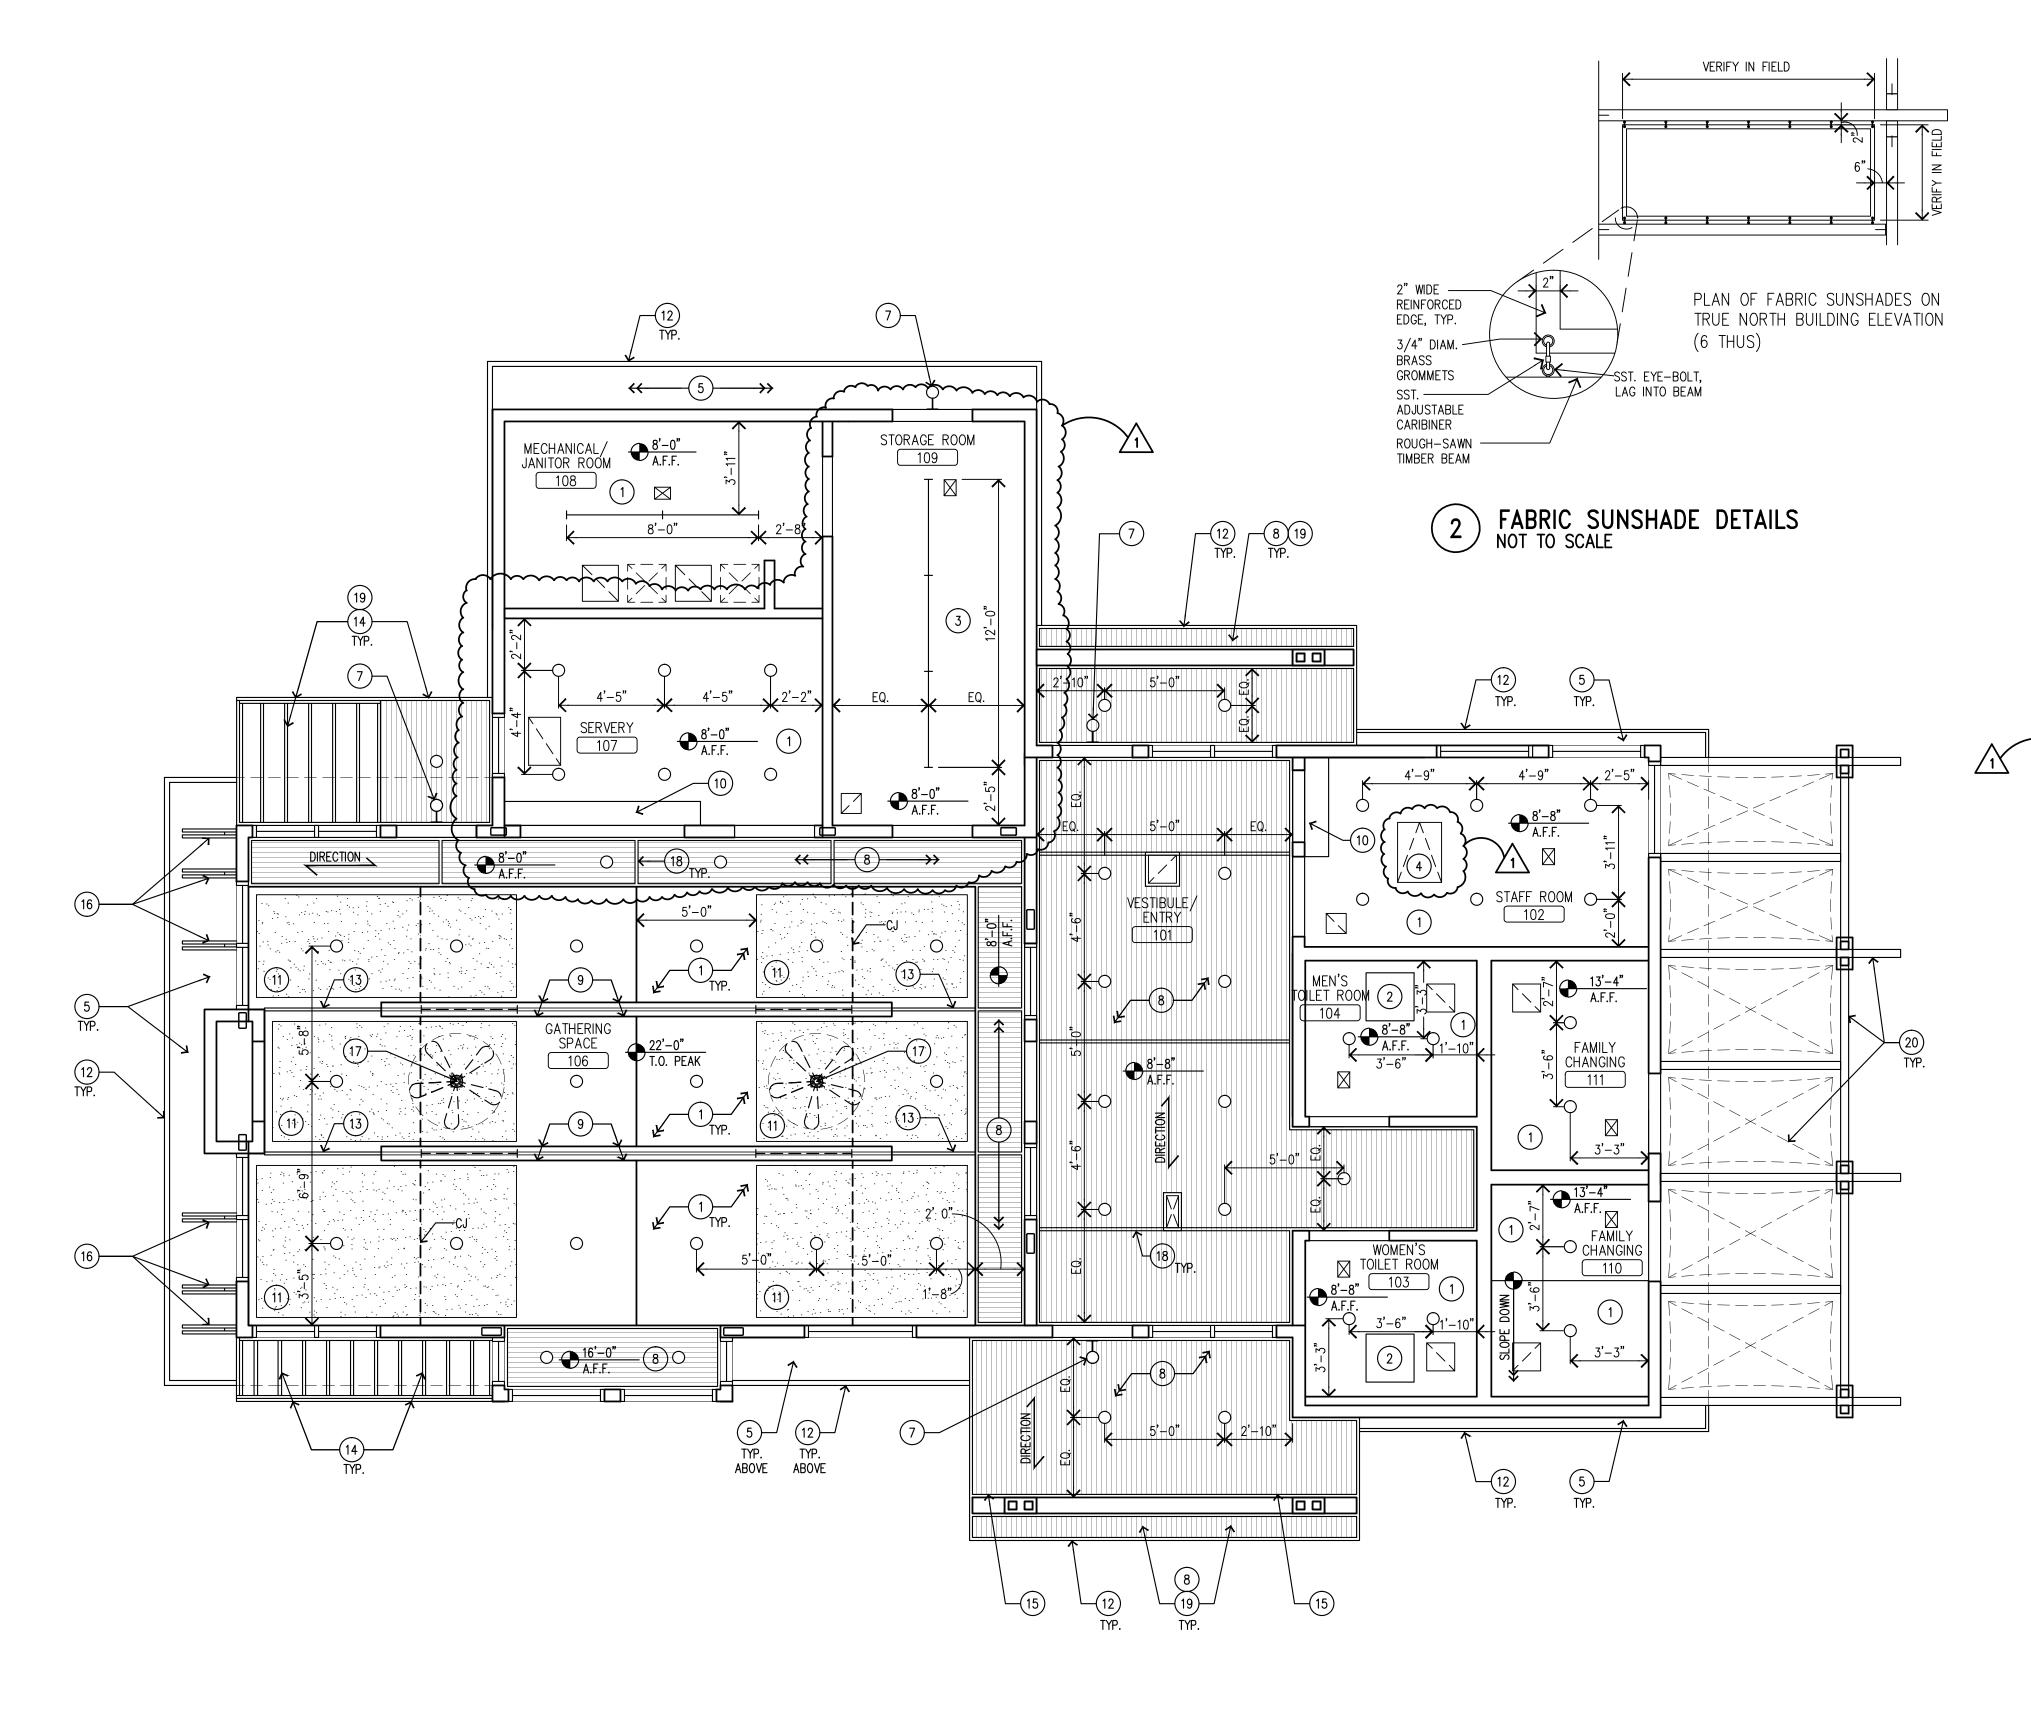

GENERAL REFLECTED CEILING PLAN NOTES:

- 1. SEE MECHANICAL AND ELECTRICAL DRAWINGS FOR FIXTURE TYPES & QUANTITIES.
- 2. SEE ELECTRICAL DWGS FOR EMERGENCY EXIT LIGHT & SIGNAGE.
- 3. ALL GYP. BOARD CEILINGS/SOFFITS TO BE PAINTED.
- 4. ELECTRICAL AND GENERAL CONTRACTOR SHALL COORDINATE THE LOCATION OF ALL LIGHTS BETWEEN JOIST SPACES.
- 5. ACOUSTICAL PANEL TO BE CUT AROUND CAN LIGHTS, CENTER SEAMS AT CAN LIGHTS.

REFLECTED CEILING PLAN - SYMBOL KEY:

NEW PARTITIONS TO BE CONSTRUCTED NEW HEADER IN NEW OR EXISTING WALL

EXISTING PARTITIONS TO REMAIN

SURFACE MOUNTED STRIP FIXTURE

DOWN LIGHT

EXTERIOR FIXTURE

CEILING ELEVATION ABOVE FINISH FLOOR

REFLECTED CEILING PLAN KEY NOTES:

DIFFUSERS/RETURNS - SEE MECHANICAL

- 1) GYP. BD. CEILING/SOFFIT ASSEMBLY PAINT
- RADIANT CEILING PANEL SEE MECH 1-HOUR FIRE-RATED CEILING ASSEMBLY, 2 LAYERS OF 5/8" TYPE X GYP. BD., TAPE AND SEAL JOINTS AND FILL ANNULAR SPACE AROUND ALL PENETRATIONS AS REQUIRED FOR 1-HOUR FIRE-RATING - PAINT
- 22" X 30"' ACCESS PANEL (PAINT) FOR ATTIC ACCESS LOCATE WITH ARCHITECT IN FIELD
- PRE-PRIMED FIBER CEMENT SOFFIT PANEL, VENTED, SMOOTH FINISH-PAINT, PROVIDE 4/4 X 2.50" FIBER CEMENT TRIM BOARDS AS NEEDED AT PANEL TO PANEL END JOINTS.
- NOT USED
- EXTERIOR EMERGENCY LIGHTING CENTERED ABOVE DOOR SEE ELEC.
- FIR PANEL CEILING WITH V-GROOVES @ 4" O.C. w/ SHIP LAP ENDS OVER 1/2" GYP. BD., WITH 1X PERIMETER TRIM, TYP. ALIGN WITH INTERIOR PANEL JOINTS, TYP. - STAIN
- WOOD CLAD CUSTOM STEEL BEAM WITH KING POST ROD, STAIN. WITH CONCEALED LIGHT FIXTURES, SEE ELEC.
- OVERHEAD COILING GRILLE ENCLOSURE SEE DETAILS ON SHEET GN-a10.5
- FABRIC WRAPPED ACOUSTIC PANEL WITH V-JOINT AT PANEL TO PANEL
- CONDITIONS AND STRAIGHT SQUARE EDGES AT PERIMETER, TYP. CONT. FASCIA ASSEMBLY, PAINT - SEE DETAILS ON SHEET GN-a10.1
- 2"X2" WOOD TRIM CONT. ATTACH FROM SOFFIT TO RIDGE W/PIN NAILS AND CONSTRUCTION ADHESIVE MITER JOINTS@ TRANSITIONS PAINT
- 2"X WOOD FRAMING SUN SHADE ASSEMBLY SEE ROOF PLAN, SHEET a2.2
- BEAM AT ENTRY CANOPY SEE STRUCTURAL, WRAP IN FIBER CEMENT TRIM BOARDS, PAINT — SEE DETAILS ON SHEET GN—a10.3
- 1X CEDAR BRACKET ASSEMBLY, STAIN W/GALV. STEEL T—SHAPED MOUNTING PLATES AT SOFFIT & WALL SEE DETAILS ON SHEET GN—a10.2
- CEILING FAN SEE ELECTRICAL
- 1x2 WOOD BATTEN AT CEILING PANEL JOINT STAIN, MATCH PERIMETER 1X2 TRIM
- PROVIDE PREFINISHED #2 CONTINUOUS SOFFIT VENT WITH INSECT SCREEN IN EXTERIOR ENTRY CANOPY LOCATIONS - MATCH COLOR OF SOFFIT STAIN - LOCATE VENT BEHIND SOFFIT FASCIA TRIM BOARD PERPENDICULAR TO ROOF FRAMING, TYPICAL - SEE DETAILS ON SHEET
- WOOD ARBOR ASSEMBLY STAIN, WITH SUN SHADE FABRIC PANELS - SEE DETAIL 2/RO-a9.1 AND STRUCTURAL - PROVIDE PREFINISHED METAL CAP FLASHING OVER WOOD POSTS AND 2X CEDAR FRAMING ASSEMBLY



ROSEVILLE PARKS & RECREATION

2660 CIVIC CENTER DRIVE ROSEVILLE, MINNESOTA 55113



PERFORMANCE DRIVEN DESIGN. LHBcorp.com

250 3rd Ave. N, Ste 450 | Minneapolis, MN 55401 | 612.338.2029



ARCHITECT #

4201 CEDAR AVENUE SO. . MINNEAPOLIS, MN 55407 TEL. (612)904-1332 • FAX (612)904-7366

I hereby certify that this drawing was prepared by me or under my direct supervision and that I am a duly registered architect under the laws of the State of Minnesota.

TAM MALLOW

TITLE: ARCHITECT DATE: 1/21/14 REG. NO.: 22541

5	6/10/2014	CONSTRUCTION SET
4	1/21/2014	BID
3	12/20/2013	90% REVIEW SET
2	10/07/2013	90% REVIEW SET
1	9/11/2013	FINAL DESIGN
NO	DATE	ISSUED FOR

NO DATE REVISION

COPYRIGHT 2014 BY LHB, INC. ALL RIGHTS RESERVED.

1 07/24/2014 ASI #1

PROJECT NAME: ROSEVILLE PARKS AND RECREATION RENEWAL PROGRAM

ROSEBROOK PARK 2590 FRY STREET **ROSEVILLE, MINNESOTA 55113**

DRAWING TITLE: REFLECTED CEILING PLAN

FILE: 1353RO-a9.1.dwg DRAWN BY: JRG CHECKED BY: DRL PROJ. NO: 1353

DRAWING NO:

REFELCTED CEILING PLAN





PLAN NORTH TRUE NORTH

GENERAL NOTES

GENERAL

- 1. IN MECHANICAL, AND ELECTRICAL EQUIPMENT ROOMS, CONDUIT FOR LIGHTING FIXTURES MAY BE RUN EXPOSED.
- 2. REFER TO ARCHITECTURAL ELEVATIONS AND REFLECTED CEILING PLAN FOR EXACT LOCATION OF LIGHTING FIXTURES AND DEVICES.
- 3. INTERRUPING RATINGS NOTED IN SCHEDULES SHALL APPLY TO ENTIRE PANELBOARD AND/OR SWITCHBOARD. ALL EQUIPMENT COMPRISING PANELS AND/OR SWITCHBOARDS SHALL BE FULLY RATED FOR SHORT CIRCUIT CURRENT NOTED.
- 4. LETTER THUS: "A" INDICATES TYPE OF LIGHTING FIXTURES. REFER TO LIGHTING FIXTURE TYPES AS NOTED ON THE LIGHTING FIXTURE
- 5. PROVIDE ENGRAVED NAMEPLATES ON SWITCHBOARDS, PANELBOARDS, DISCONNECT SWITCHES, ETC., INDICATING EQUIPMENT DESIGNATION (OR DESIGNATION OF EQUIPMENT SERVED) AND VOLTAGE.
- ANY ELECTRICAL BOX THAT BECOMES ABANDONED DURING THE COURSE OF THE PROJECT SHALL HAVE A BLANK COVERPLATE.
- 7. ADJUST MOUNTING HEIGHTS OF ALL OUTLETS IF REQUIRED SO AS NOT TO INTERFERE WITH RADIATION, VERIFY CHANGES WITH ENGINEER.
- 8. DATA AND TELEPHONE AND TELEVISION CONDUIT SHALL BE MINIMUM % INCH UNLESS OTHERWISE NOTED ON DRAWINGS.
- 9. WHERE OTHER ELECTRICAL DEVICES ARE LOCATED ADJACENT TO LIGHT SWITCHES, MOUNT ALL DEVICES AT THE SAME CENTER LINE ELEVATION.
- DO NOT SCALE DRAWINGS, VERIFY DIMENSIONS IN FIELD PRIOR TO COMMENCEMENT OF WORK.
- 11. FINAL CONNECTIONS TO EQUIPMENT SHALL BE PER MANUFACTURER'S APPROVED WIRING DIAGRAMS, DETAILS , AND INSTRUCTIONS. IT SHALL BE THE CONTRACTOR'S RESPONSIBILITY TO PROVIDE MATERIALS AND EQUIPMENT COMPATIBLE WITH EQUIPMENT ACTUALLY SUPPLIED.
- 12. IT IS THE INTENT OF THESE DRAWINGS AND SPECIFICATIONS TO ESTABLISH A STANDARD OF QUALITY. THE ENGINEER RESERVES THE RIGHT TO APPROVE METHODS AND MATERIALS NOT REFLECTED HEREIN.
- WORK SHALL BE PERFORMED IN A WORKMANLIKE MANNER TO THE SATISFACTION OF THE ARCHITECT.
- 14. WORK, MATERIALS AND EQUIPMENT SHALL CONFORM TO THE LATEST EDITIONS OF LOCAL, STATE OF MINNESOTA, AND NATIONAL CODES AND ORDINANCES.
- 15. PROVIDE PERMITS AND INSPECTIONS REQUIRED.
- 16. GUARANTEE THE INSTALLATION AGAINST DEFECTS IN MATERIALS AND WORKMANSHIP WHICH MAY OCCUR UNDER NORMAL USAGE FOR A PERIOD OF ONE YEAR AFTER OWNER'S ACCEPTANCE, DEFECTS SHALL BE PROMPTLY REMEDIED WITHOUT COST TO THE OWNER.
- 17. VERIFY THAT EXACT LOCATION OF EQUIPMENT TO BE FURNISHED BY OTHERS PRIOR TO ROUGH-IN. 18. SYSTEMS SHALL BE TESTED FOR PROPER OPERATION. IF TESTS SHOW THAT WORK IS DEFECTIVE, CONTRACTOR SHALL MAKE CORRECTIONS
- NECESSARY AT NO COST TO OWNER. 19. CONTRACTOR SHALL BE RESPONSIBLE FOR REPLACING EQUIPMENT WHICH IS DAMAGED DUE TO INCORRECT FIELD WIRING OR FACTORY
- WIRING IN EQUIPMENT PROVIDED BY THIS CONTRACTOR. 20. CONTRACTOR'S FAILURE TO ORDER OR RELEASE ORDER FOR MATERIALS AND/OR EQUIPMENT WILL NOT BE ACCEPTED AS A REASON TO
- SUBSTITUTE ALTERNATE MATERIALS, EQUIPMENT, OR INSTALLATION METHODS. 21. SYSTEMS BE COMPLETE, OPERABLE, AND READY FOR CONTINUOUS ORPERATION. LIGHTS, SWITCHES, RECEPTACLES, MOTORS, ETC.
- SHALL BE CONNECTED AND OPERABLE.
- 22. VERIFY EXACT LOCATIONS OF EXISTING AND NEW UNDERGROUND UTILITIES, PIPING, AND RACEWAY SYSTEMS PRIOR TO TRENCHING. PROVID NECESSARY TRENCHING, BACKFILL, EXCAVATION, SUPPORTS, SERVICE FEEDERS (CONDUIT AND/OR WIRE), PULLBOXES, TRANSFORMER PADS, SAWCUTTING AND PATCHING, CONCRETE/PAVING, ETC. REQUIRED. BACKFILL TRANCHES TO AND PATCH TO MATCH EXISTING. CONTRACTOR SHALL OBTAIN AND VERIFY EXACT UTILITY COMPANY DRAWINGS AND REQUIREMENTS.
- 23. PANEL DIRECTORIES SHALL BE REMOVABLE. SUBMIT PROPOSED SCHEDULE OF DIRECTORIES TO OWNER FOR APPROVAL. ROOM NAMES AND NUMBERS SHALL BE AS DIRECTED BY OWNER, DIRECTORIES SHALL BE TYPED AND INSTALLED UNDER CLEAR PLASTIC COVERS.
- 24. PROVIDE SELF ADHESIVE INDENTIFICATION INSIDE COVER OF EACH FUSABLE SWITCH, INDICATING SIZE AND TYPE OF FUSES PROVIDED.
- 25. PROVIDE ONE (1) SET OF THREE (3) SPARE FUSES FOR EACH SIZE AND TYPE PROVIDED ON THIS PROJECT. INSTALL FUSES IN A HINGE DOOR, SHEET METAL STORAGE CABINET EQUIPPED WITH CLIPS OR CUBICLES, EACH MARKED WITH THE SIZE AND TYPE FUSE STORED THEREIN. PROVIDE NAMEPLATE "SPARE FUSES". INSTALL IN LOCATION(S) AS DIRECTED BY OWNER.
- 26. ALL WIRING SHALL BE INSTALLED IN LISTED METALLIC RACEWAYS. RACEWAYS IN SLAB-ON-GRADE OR BELOW GRADE SHALL BE SCHEDULE 40 PVC, TRANSITIONS FROM BELOW TO ABOVE GRADE SHALL BE WITH RIGID STEEL ELBOWS WITH PVC JACKET OR PROVIDED EQUAL PROTECTION, EMT FITTINGS SHALL BE MALLEABLE IRON OR STEEL. CONNECTORS SHALL BE INSULATED THROAT TYPE.
- 27. ALL BRANCH CIRCUIT AND FEEDER CONDUITS SHALL HAVE A CODE SIZED COPPER GROUNDING CONDUCTOR. INCREASE CONDUIT SIZE AS
- 29. CONDUITS PENETRATING THRU ROOF SHALL BE CONSTRUCTED IN CONFORMANCE WITH "BUILT-UP BITUMINOUS ROOFING" SECTION 07510

28. SOUND, TELEPHONE, COMPUTER, AND SIMILAR SYSTEMS CONDUITS LARGER THAT 1"SHALL HAVE LONG RADIUS SWEEPS (12 TIMES THE

- AND "SHEET METAL FLASHING AND TRIM" SECTION 07620. 30. FINAL CONNECTIONS TO MOTORS, TRANSFORMERS, AND OTHER VIBRATING EQUIPMENT SHALL BE WITH FLEX METAL CONDUIT AND FITTINGS. DO NOT SECURE CONDUITS, DISCONNECTS, OR DEVICES TO DUCTWORK OR MECHANICAL EQUIPMENT.
- 31. ALL ELECTRICAL SYSTEMS COMPONENTS SHALL BE LISTED OR LABELED BY UL OR OTHER RECOGNIZED TESTING FACILITY.
- 32. WHERE THE NEUTRAL CONDUCTOR IS SHARED BETWEEN (2) CIRCUITS (MULTIWIRE BRANCH CIRCUIT), IT IS THE CONTRACTORS RESPONSIBILTY TO PROVIDE HANDLE TIES AS REQUIRED TO COMPLY WITH NEC 210.

LIGHTING

- 1. FIXTURES INDICATED AS BEING ON EMERGENCY OR NIGHT LIGHT CIRCUITS SHALL BE PROVIDED WITH SELF-CONTAINED BATTERY POWERED INVERTER UNIT FOR DIRECT MOUNTING IN FIXTURE. PROVIDE UNIT WITH FULLY AUTOMATIC TWO RATE CHARGER, NICKEL CADMIUM BATTERY, AC "ON PILOT LIGHT, AND TEST SWITCH. DESIGN AND WIRE UNIT TO AUTOMATICALLY TRANSFER TO BATTERY SUPPLY UPON LOSS OF NORM AC POWER AND TO OPERATE LINEAR FLUORESCENT LAMP WITH MINIMUM OUTPUT OF 1000 LUMENS FOR MINIMUM 1-1/2 HOURS.
- 2. RECESSED LIGHT FIXTURES INSTALLED IN GYP BOARD OR PLASTER CEILINGS SHALL HAVE PLASTER FRAMES INSTALLED PRIOR TO CEILING MATERIAL.
- 3. RECESSED FIXTURES INSTALLED INDOORS SHALL BE THERMALLY PROTECTED.
- VERIFY TYPE OF CEILING CONSTRUCTION FOR PROPER MOUNTING OF ALL RECESSED LIGHT FIXTURES. INSTALLATION OF LIGHT FIXTURES SHALL COMPLY WITH ALL INTERNATIONAL BUILDING CODE REQUIREMENTS.

CUSTOM

- FY LOCATION OF ALL MOTORS AND EQUIPMENT BEFORE ROUGH-IN. SEE MECHANICAL DRAWINGS FOR LOCATION OF MECHANICAL PMENT, PROVIDE SERVICE TO AND CONNECT EQUIPMENT AS REQUIRED.
- RICAL CONTRACTOR SHALL PROVIDE CONTROLS, INTERLOCKS, ACCESSORIES, ETC., IN MOTOR CONTROL STARTERS AS REQUIRED BY THE RATURE CONTROL CONTRACTOR. STARTERS SHALL CONTAIN 120V CONTROL TRANSFORMER, PILOT LIGHT, AND PUSHBUTTONS OR OR SWITCH AS REQUIRED, IN ADDITION TO OTHER ITEMS (AUXILIARY CONTACTS, DOOR SWITCHES, RELAYS, ETC.) REQUIRED. SUBMIT TARY CONTROL DIAGRAMS FOR APPROVAL. SUBMITTALS SHALL INCLUDE INDICATION OF PRIOR REVIEW AND ACCEPTANCE BY TURE CONTROL CONTRACTOR, REFER TO DIVISION 15 DRAWINGS AND TEMPERATURE CONTROL DIAGRAMS FOR ADDITIONAL CONDUIT, 'AYS, TRANSFORMERS, CONNECTIONS, ETC. REQUIRED FOR A COMPLETE AND OPERABLE SYSTEM.

				ELECTRICA	L SYM	BOLS 50	OUEDOFE		Ch. Branch		
	LIGHTING			POWER DISTRIBUTION			FIRE ALARM			POWER	
SYMBOL	DESCRIPTION	MTG HT	SYMBOL	DESCRIPTION	MTG HT	SYMBOL	DESCRIPTION	MTG HT	SYMBOL	DESCRIPTION	MTG HT
	FLUORESCENT FIXTURE RECESSED MOUNTED	CEILING	Ţ	GROUND		FACP	FIRE ALARM CONTROL PANEL		Φ	DUPLEX RECEPTACLE	
0	FLUORESCENT FIXTURE SURFACE MOUNTED	CEILING	0	METER		FAA	FIRE ALARM ANNUNCIATOR PANEL		SS CP	WP INDICATES WEATHERPROOF SS INDICATES STAINLESS STEEL FACEPLATE CP INDICATES CHILDPROOF RECEPTACLE	18"
	STRIP TYPE LIGHT FIXTURE	CEILING	мн	MANHOLE		■DH	MAGNETIC DOOR HOLD OPEN		GD MICRO	DW INDICATES DISHWASHER GD INDICATES GARBAGE DISPOSAL (SWITCHED)	
	CEILING MOUNTED STRIP TYPE LIGHT FIXTURE	CEILING	нн	HANDHOLE		⊦®◀	FIRE ALARM SPEAKER	90*		MICRO INDICATES MICROWAVE OVEN	
- Q-I	WALL MOUNTED STRIP TYPE LIGHT FIXTURE	CEILING	Λ	PANEL SURFACE (BRANCH)		Ē	FIRE ALARM STROBE	90"	₩	FOURPLEX RECEPTACLE	18*
	FLUORESCENT STAGGERED STRIP TYPE LIGHT FIXTURE			PANEL FLUSH (BRANCH)		臣	FIRE ALARM HORN/STROBE	90"	Φ	SIMPLEX RECEPTACLE	18"
0	ROUND DOWN LIGHT TYPE LIGHT FIXTURE	CEILING	P77			Ē	FIRE ALARM CEILING STROBE	CEILING	Фс	CEILING MOUNT DUPLEX RECEPTACLE	
Ю	WALL MOUNT SCONCE	-		PANEL (DISTRIBUTION)		F	FIRE ALARM CEILING HORN/STROBE	CEILING	Φ.	GFI RECEPTACLE	18"
	PENDANT TYPE LIGHT FIXTURE	-	P7773			69	FIRE/SMOKE DAMPER		P	HORIZONTAL GFI RECEPTACLE	18"
0	HIGHBAY TYPE LIGHT FIXTURE			SWITCHBOARD		更	FIRE ALARM PULL STATION	42*	\$	ABOVE COUNTER RECEPTACLE	
	TRACK LIGHTING WITH HEADS SPACED AS INDICATED					Ĉ	FIRE ALARM SMOKE DETECTOR - PHOTOELECTRIC	CEILING	. AF	ABOVE COUNTER FOURPLEX RECEPTACLE	
	EXIT LIGHT FACE/DIRECTION ARROWS AS INDICATED		СТ	CT CABINET		Ē	FIRE ALARM DUCT DECTECTOR		AN.	ABOVE COUNTER GFI RECEPTACLE	
	EXIT LIGHT FACE/DIRECTION ARROWS AS INDICATED						FIRE ALARM HEAT DETECTOR	1,000	æ	ABOVE COUNTER HORIZONTAL GFI RECEPTACLE	
+≪,						135 200	135 INDICATES 135 FXD HEAT DETECTOR 200 INDICATES 200 FXD HEAT DETECTOR	CEILING	•	LOWER SWITCHED RECEPTACLE	18*
4	LIGHT FIXTURE ON EMERGENCY CIRCUIT	CEILING	т	UTILITY CO. TRANSFORMER		R CR	R INDICATES 135 ROR HEAT DETECTOR CR INDICATES 200 ROR HEAT DETECTOR		0	SWITCHED RECEPTACLE	18"
	EMERGENCY BUGEYE LIGHT FIXTURE	CEILING					FIRE SPRINKLER TAMPER SWITCH			HORIZONTAL RECEPTACLE	18
_	EMERGENCY DOWNLIGHT TYPE LIGHT FIXTURE					®	FIRE SPRINKLER FLOW SWITCH		Φ	RANGE RECEPTACLE TYPE AS NOTED	6"
∾□	EXTERIOR POLE MOUNTED LIGHT FIXTURE			COMMUNICATIONS					₩	SPECIAL PURPOSE RECEPTACLE WALL TYPE AS NOTED	18
₩	BOLLARD LIGHT FIXTURE		SYMBOL	DESCRIPTION	MTG HT		MOTORS	100 10	⊕	SPECIAL PURPOSE RECEPTACLE TYPE AS NOTED	18
	LIGHTING CONTROL		*	TELEPHONE	18"	SYMBOL	DESCRIPTION CINCLE	MTG HT	6	CEILING JUNCTION BOX WITH FLEX	CEIL
SYMBOL	DESCRIPTION	MTG HT	, ¥	TELEPHONE - WALL HUNG		Ю	PUSHBUTTON — SINGLE		0	CEILING JUNCTION BOX RECESSED	CEIL
\$	SINGLE POLE SWITCH - LETTER INDICATES SWITCHING	46"	e1777111700	COMMUNICATIONS BOARD SIZE AS INDICATED	_	н	PUSHBUTTON — DOUBLE		-	CEILING SURFACE JUNCTION BOX	CEILI
² \$ ³ \$ ⁴	DOUBLE POLE, 3-WAY AND 4-WAY SWITCHES	46*	▽ .	DATA OUTLET		Here	PUSHBUTTON - TRIPLE		J		- VEIC
\$ ^K	KEY OPERATED SWITCH	46*	ç	DATA — CEILING MOUNTED		Φ	THERMOSTAT	60"	Ю	WALL RECESSED JUNCTION BOX	
⊢ □−×	WALL BOX DIMMER SWITCH WITH TYPE AS INDICATED		3.	COMBINATION PHONE/DATA OUTLET		MC	MAGNETIC CONTACT		HJ	WALL SURFACE JUNCTION BOX	
R	RELAY		Ŷ	CALL STATION		100	MOTOR	7	0	FLOOR BOX WITH DEVICES INDICATED	FLO
TS	TIME SWITCH	46"	9	SPEAKER - WALL MOUNTED		- 	MOTOR WITH ELECTRICAL CONNECTION; REFER TO MOTOR		PB	PULLBOX	
С	CONTACTOR		3	SPEAKER - CEILING MOUNTED		L##	SCHEDULE		NOTES: 1. THESE SYM	IBOLS COMPRISE A STANDARD LIST; ALL SYMBOLS MAY NOT APPE	EAR ON
— P	OCCUPANCY SENSOR CEILING MOUNTED "D" INDICATES DUAL		ŢV	TV OUTLET - WALL MOUNTED		ㅁ	FUSED DISCONNECT		THIS PROJECT		
os _{IR}	"D" INDICATES DUAL TECHNOLOGY. "IR" INDICATES INFRARED TECHNOLOGY.	CEILING	TV	TV OUTLET - CEILING MOUNTED		□ _{NF}	NF DISCONNECT		 MOUNTING HEIGHTS SHOWN ARE STANDARD AND SHALL BE USED UNLESS IN OTHERWISE, MOUNTING HEIGHTS ARE TO CENTERLINE OF DEVICE, UNLESS INDICA 		CATED
\$ ^{os}	OCCUPANCY SENSOR WALL SWITCH BOX MOUNTED	46"		SECURITY		н	MUSHROOM BUTTON		OTHERWISE.		
PS	PHOTOSENSOR		SYMBOL	DESCRIPTION	MTG HT	`	EQUIPMENT CONNECTION #1				
	CABLING		Ģ	SECURITY ALARM PUSHBUTTON (DURESS BUTTON)			EQUIPMENT CONNECTION #2				
SYMBOL	DESCRIPTION	MTG HT	ᅋ	SECURITY CARD READER (PROXIMITY READER)		ماء		V 21 22			
	CONDUIT RUN EXPOSED		•	SECURITY ELECTRIC STRIKE		*	CEILING FAN				
	CONDUIT RUN IN OR BELOW FLOOR, OR UNDER GROUND (UG)		□	SECURITY ELECTRIC LATCH		O~~~	HEAT TAPE				
	WIRE COUNTS		MC	SECURITY MAGNETIC CONTACT					_		
	HOME RUN		IC	FACILITY INTERCOM							
				SECURITY KEYPAD		1					
						1					
□	CONDUIT STUB UP		· ¥	SECURITY KEYPAD CCTV VIDEO CAMERA — CEILING MOUNTED							

SECURITY DOOR TYPE CALLOUT, SEE DETAILS

DRAWING NUMBER	DRAWING TITLE
RO-e0.1	ELECTRICAL LEGEND AND GENERAL NOTES
RO-e1.0	ELECTRICAL SITE PLAN AND DETAILS
RO-e2.0	LIGHTING PLAN
RO-e2.1	POWER AND AUX PLAN
RO-e3.0	ELECTRICAL SINGLE LINE DIAGRAM AND SCHEDULES



ROSEVILLE PARKS & RECREATION

2660 CIVIC CENTER DRIVE ROSEVILLE, MINNESOTA 55113



PERFORMANCE DRIVEN DESIGN. LHBcorp.com

250 3rd Ave. N, Ste 450 | Minneapolis, MN 55401 | 612.338.2029



DATE: 01/21/2014

emanuelson-podas consulting engineers

10401 Bren Road East Minnetonka, MN 55343 ph: 952-930-0050 fax: 952-930-0777 www.epinc.net

I hereby certify that this drawing was prepared by me or under my direct supervision and that I am a duly registered architect under the laws of the State of Minnesota.

TITLE: ENGINEER BY: Matthew W. Fults REG. NO.: 40887

5 6/10/2014 CONSTRUCTION SET 4 01/21/2014 BID 3 12/20/2013 90% REVIEW SET 2 10/07/2013 90% REVIEW SET FINAL DESIGN 9/11/2013 ISSUED FOR DATE

6/04/2014 ADDENDUM 4 2/11/2014 ADDENDUM 1 DATE NO ...

COPYRIGHT 2014 BY LHB, INC. ALL RIGHTS RESERVED.


PROJECT NAME:

ROSEVILLE PARK AND RECREATION RENEWAL PROGRAM

ROSEBROOK PARK 2590 FRY STREET ROSEVILLE, MINNESOTA 55113

DRAWING TITLE: ELECTRICAL LEGEND AND GENERAL NOTES

FILE: DRAWN BY: MD CHECKED BY: CM

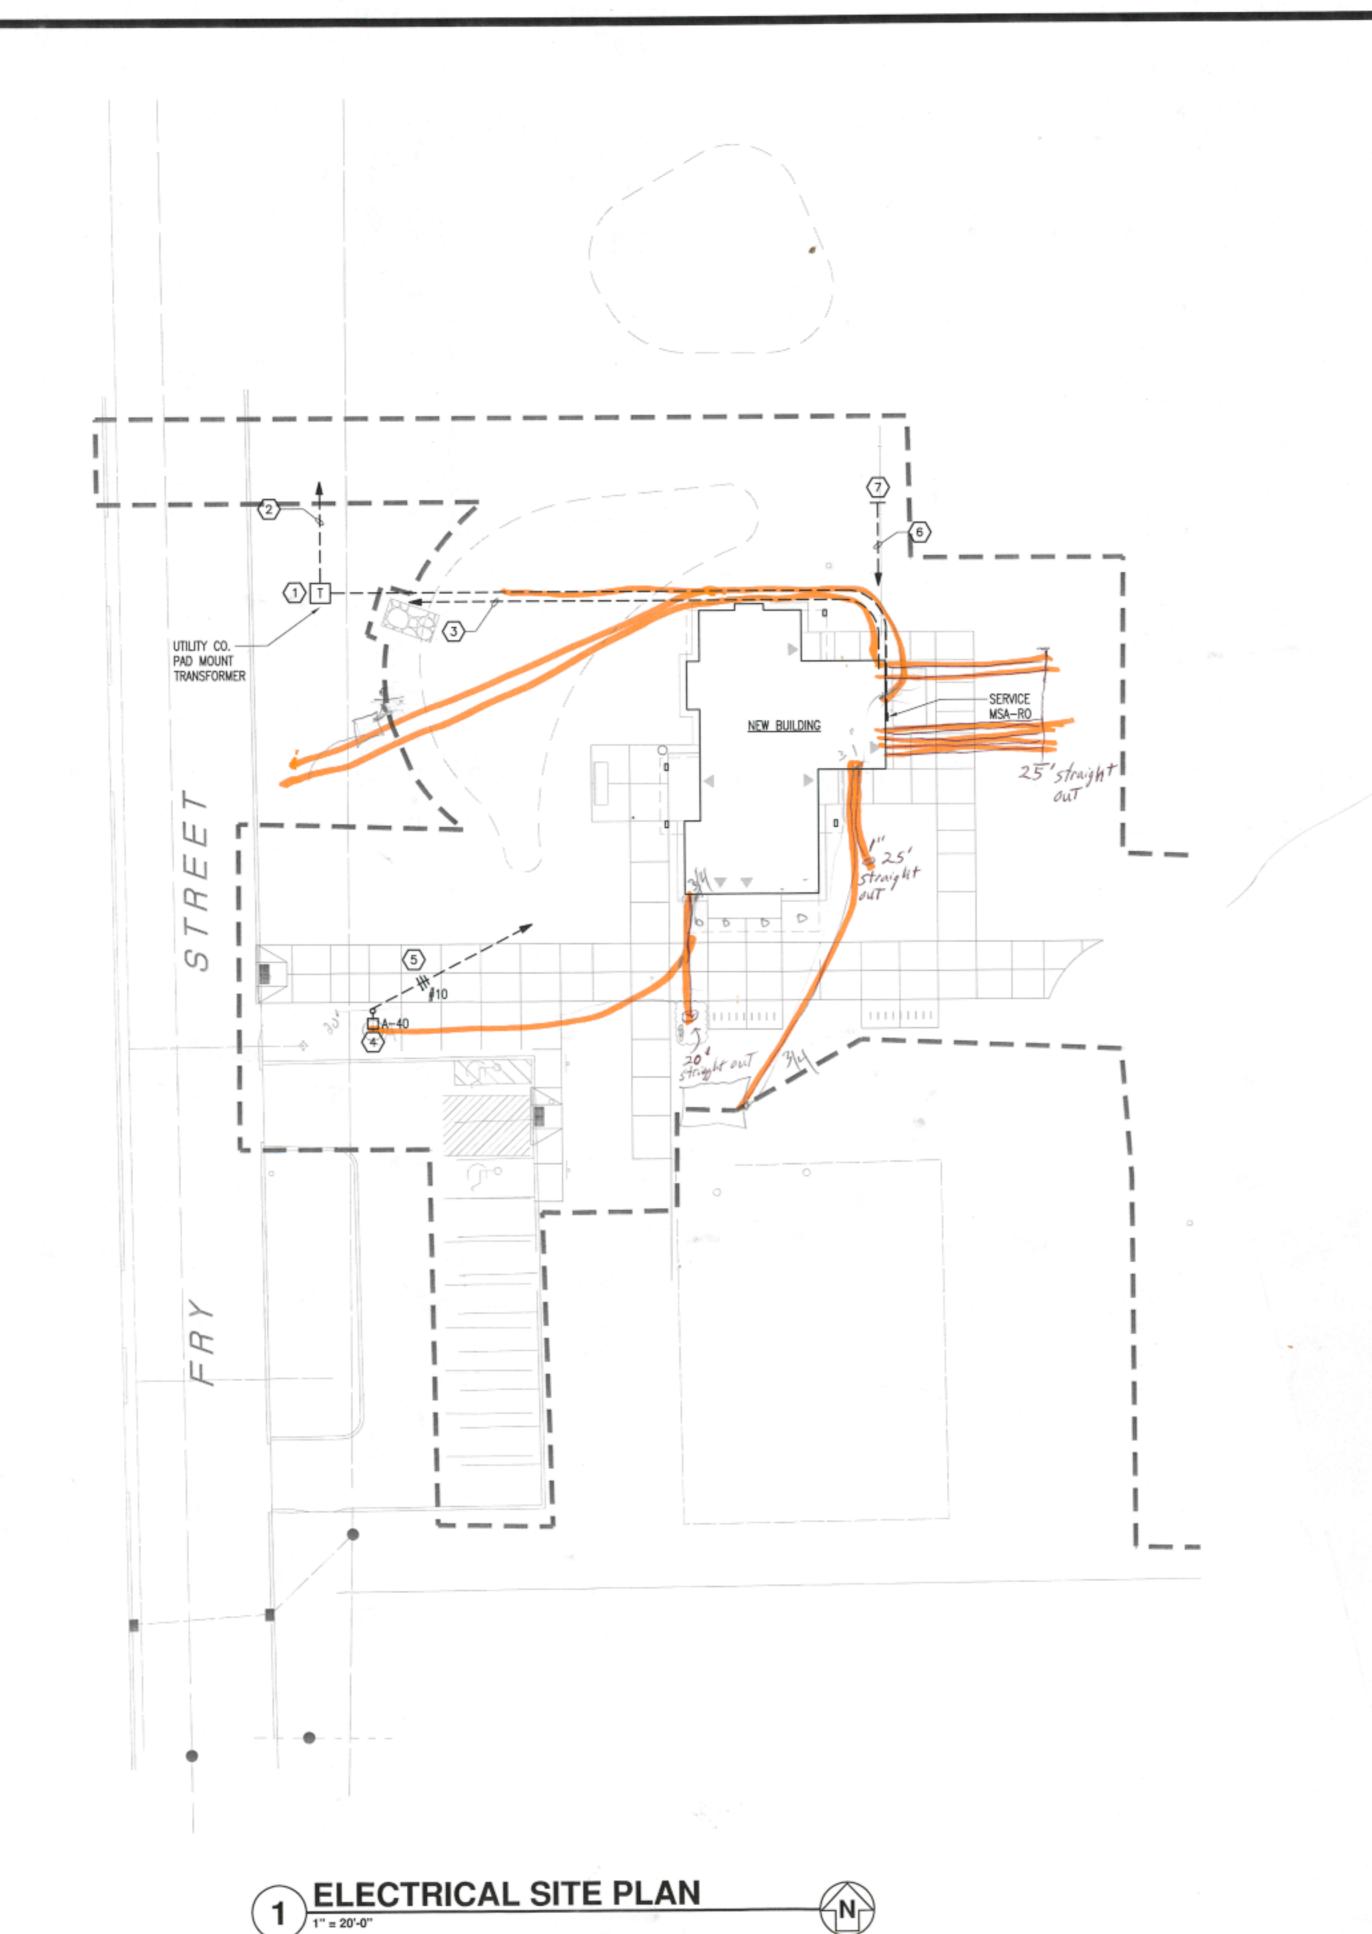

GENERAL NOTES

- A. COORDINATE DEMOLITION OF SITE ELECTRICAL AND COMMUNICATION UTILITIES WITH CIVIL DRAWINGS. REFER TO CIVIL AND LANDSCAPE DRAWINGS FOR ADDITIONAL INFORMATION.
- C. COORDINATE ALL BUILDING SERVICE UTILITIES WITH ASSOCIATED UTILITY COMPANY PRIOR TO ANY
- D. COORDINATE EXACT LOCATION(S) OF POLE LIGHT FIXTURES WITH LANDSCAPE DRAWINGS.

KEYNOTES

- PROVIDE PAD FOR TRANSFORMER PER UTILITY CO. REQUIREMENTS.
- (1) 4" EMPTY CONDUIT (POWER) TO UTILITY CO. PRIMARY POINT OF SERVICE. VERIFY EXACT LOCATION AND REQUIREMENTS WITH UTILITY CO.
- (1) 2" EMPTY CONDUIT (TELEPHONE) TO UTILITY CO. POINT OF SERVICE. VERIFY EXACT LOCATION AND REQUIREMENTS WITH UTILITY CO.
- CONNECT TO POLE LIGHT FIXTURE FURNISHED AND INSTALLED UNDER SEPARATE CONTRACT.
- 5 3/4°C-3#10 TO PANEL A VIA TS-1.
- 6 1" EMPTY CONDUIT TO PANEL B FOR SPORTS LIGHTING CONTROL BY OTHERS.
- STUB, CAP AND PROVIDE SURFACE MARKER FOR EXTENSION BY OTHERS.



ROSEVILLE PARKS & RECREATION

2660 CIVIC CENTER DRIVE ROSEVILLE, MINNESOTA 55113



PERFORMANCE DRIVEN DESIGN. LHBcorp.com

250 3rd Ave. N, Ste 450 | Minneapolis, MN 55401 | 612.338.2029



DATE: 01/21/2014

emanuelson-podas consulting engineers

10401 Bren Road East Minnetonka, MN 55343 ph: 952-930-0050 fax: 952-930-0777 www.epinc.net

I hereby certify that this drawing was prepared by me or under my direct supervision and that I am a duly registered architect under the laws of the State of Minnesota.

TITLE: ENGINEER BY: Matthew W. Fults REG. NO.: 40887

5 6/10/2014 CONSTRUCTION SET 4 01/21/2014 BID 90% REVIEW SET 90% REVIEW SET FINAL DESIGN 9/11/2013 ISSUED FOR NO DATE

6/04/2014 ADDENDUM 4 NO DATE REVISION


COPYRIGHT 2014 BY LHB, INC. ALL RIGHTS RESERVED.

PROJECT NAME: ROSEVILLE PARK AND RECREATION RENEWAL PROGRAM


ROSEBROOK PARK 2590 FRY STREET ROSEVILLE, MINNESOTA 55113

DRAWING TITLE: ELECTRICAL SITE PLAN AND DETAILS

DRAWN BY: MD CHECKED BY: CM

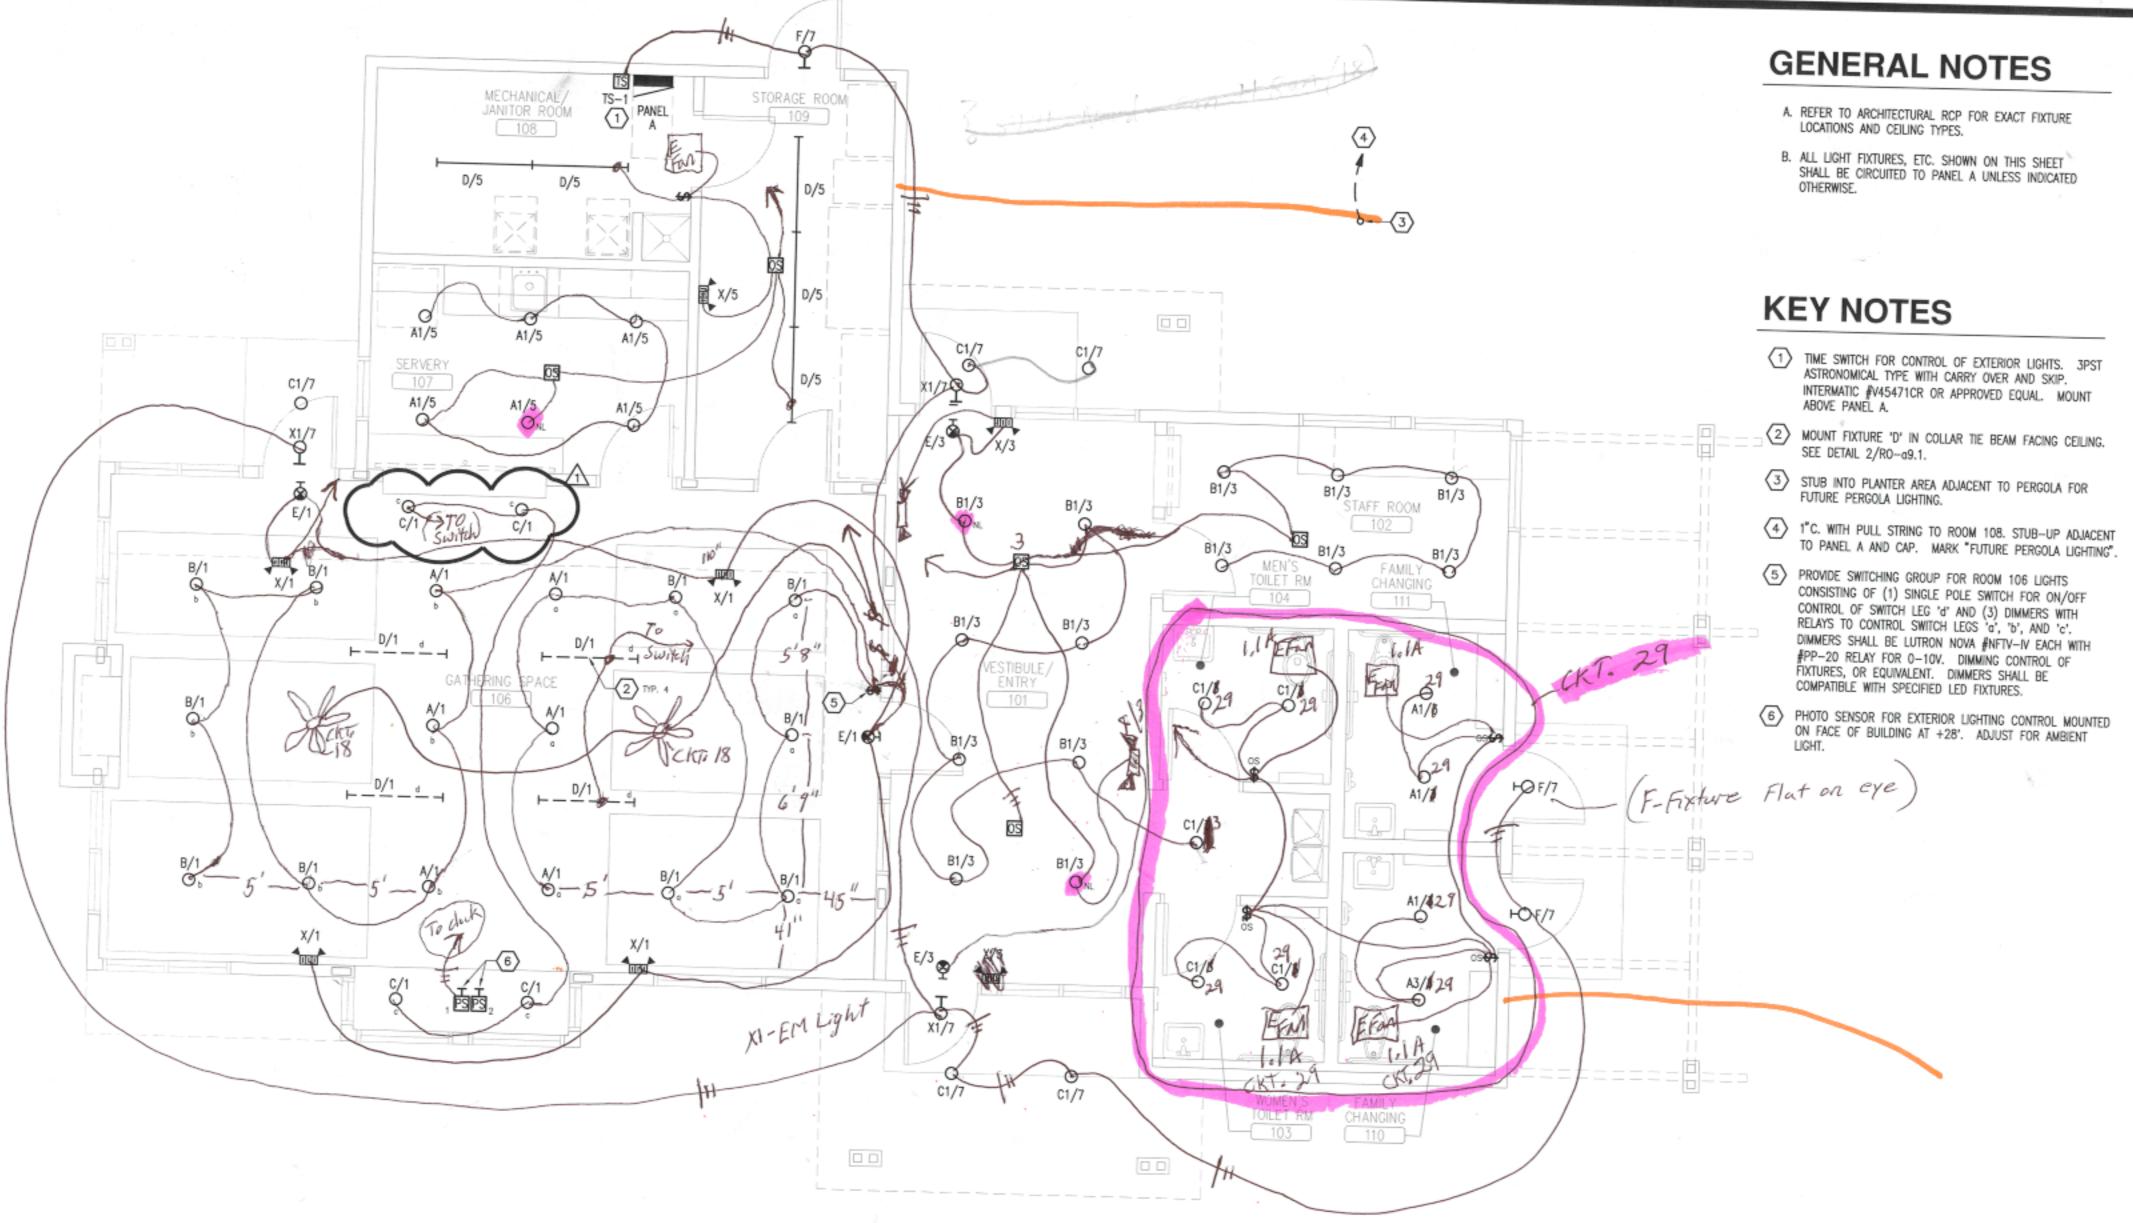

1 LIGHTING PLAN

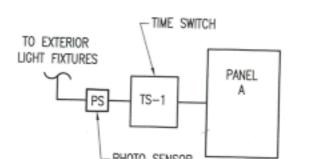

2 EXTERIOR LIGHT CONNECTION
N.T.S.

- SHALL BE CIRCUITED TO PANEL A UNLESS INDICATED OTHERWISE.
- TIME SWITCH FOR CONTROL OF EXTERIOR LIGHTS. 3PST ASTRONOMICAL TYPE WITH CARRY OVER AND SKIP. INTERMATIC #V45471CR OR APPROVED EQUAL. MOUNT
- MOUNT FIXTURE 'D' IN COLLAR TIE BEAM FACING CEILING.

- CONSISTING OF (1) SINGLE POLE SWITCH FOR ON/OFF CONTROL OF SWITCH LEG 'd' AND (3) DIMMERS WITH RELAYS TO CONTROL SWITCH LEGS 'a', 'b', AND 'c'. DIMMERS SHALL BE LUTRON NOVA #NFTV-IV EACH WITH #PP-20 RELAY FOR 0-10V. DIMMING CONTROL OF FIXTURES, OR EQUIVALENT. DIMMERS SHALL BE COMPATIBLE WITH SPECIFIED LED FIXTURES.
- 6 PHOTO SENSOR FOR EXTERIOR LIGHTING CONTROL MOUNTED ON FACE OF BUILDING AT +28'. ADJUST FOR AMBIENT

10401 Bren Road East Minnetonka, MN 55343 ph: 952-930-0050 fax: 952-930-0777 www.epinc.net

emanuelson-podas consulting engineers

PERFORMANCE DRIVEN DESIGN.

LHBcorp.com

250 3rd Ave. N, Ste 450 | Minneapolis, MN 55401 | 612.338.2029

YOUR NEIGHBORHOOD OUR COMMUNITY ROSEVILLE PARKS & RECREATION RENEWAL PROGRAM


ROSEVILLE PARKS &

2660 CIVIC CENTER DRIVE

ROSEVILLE, MINNESOTA 55113

RECREATION

I hereby certify that this drawing was prepared by me or under my direct supervision and that I am a duly registered architect under the laws of the State of Minnesota.

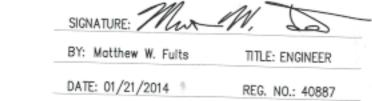

5	6/10/2014	CONSTRUCTION SET
4	05/16/2014	REISSUE
3	1/21/2014	PROPOSAL
2	12/20/2013	90% REVIEW SET
1	11/19/2013	CC PACKET
NO /	DATE	ISSUED FOR

07/24/2014 ASI #1 NO DATE REVISION

COPYRIGHT 2014 BY LHB, INC. ALL RIGHTS RESERVED.


PROJECT NAME: ROSEVILLE PARK AND RECREATION RENEWAL PROGRAM

ROSEBROOK PARK 2590 FRY STREET ROSEVILLE, MINNESOTA 55113

DRAWING TITLE: LIGHTING PLAN

> DRAWN BY: MD CHECKED BY: CM

RO-e2.0

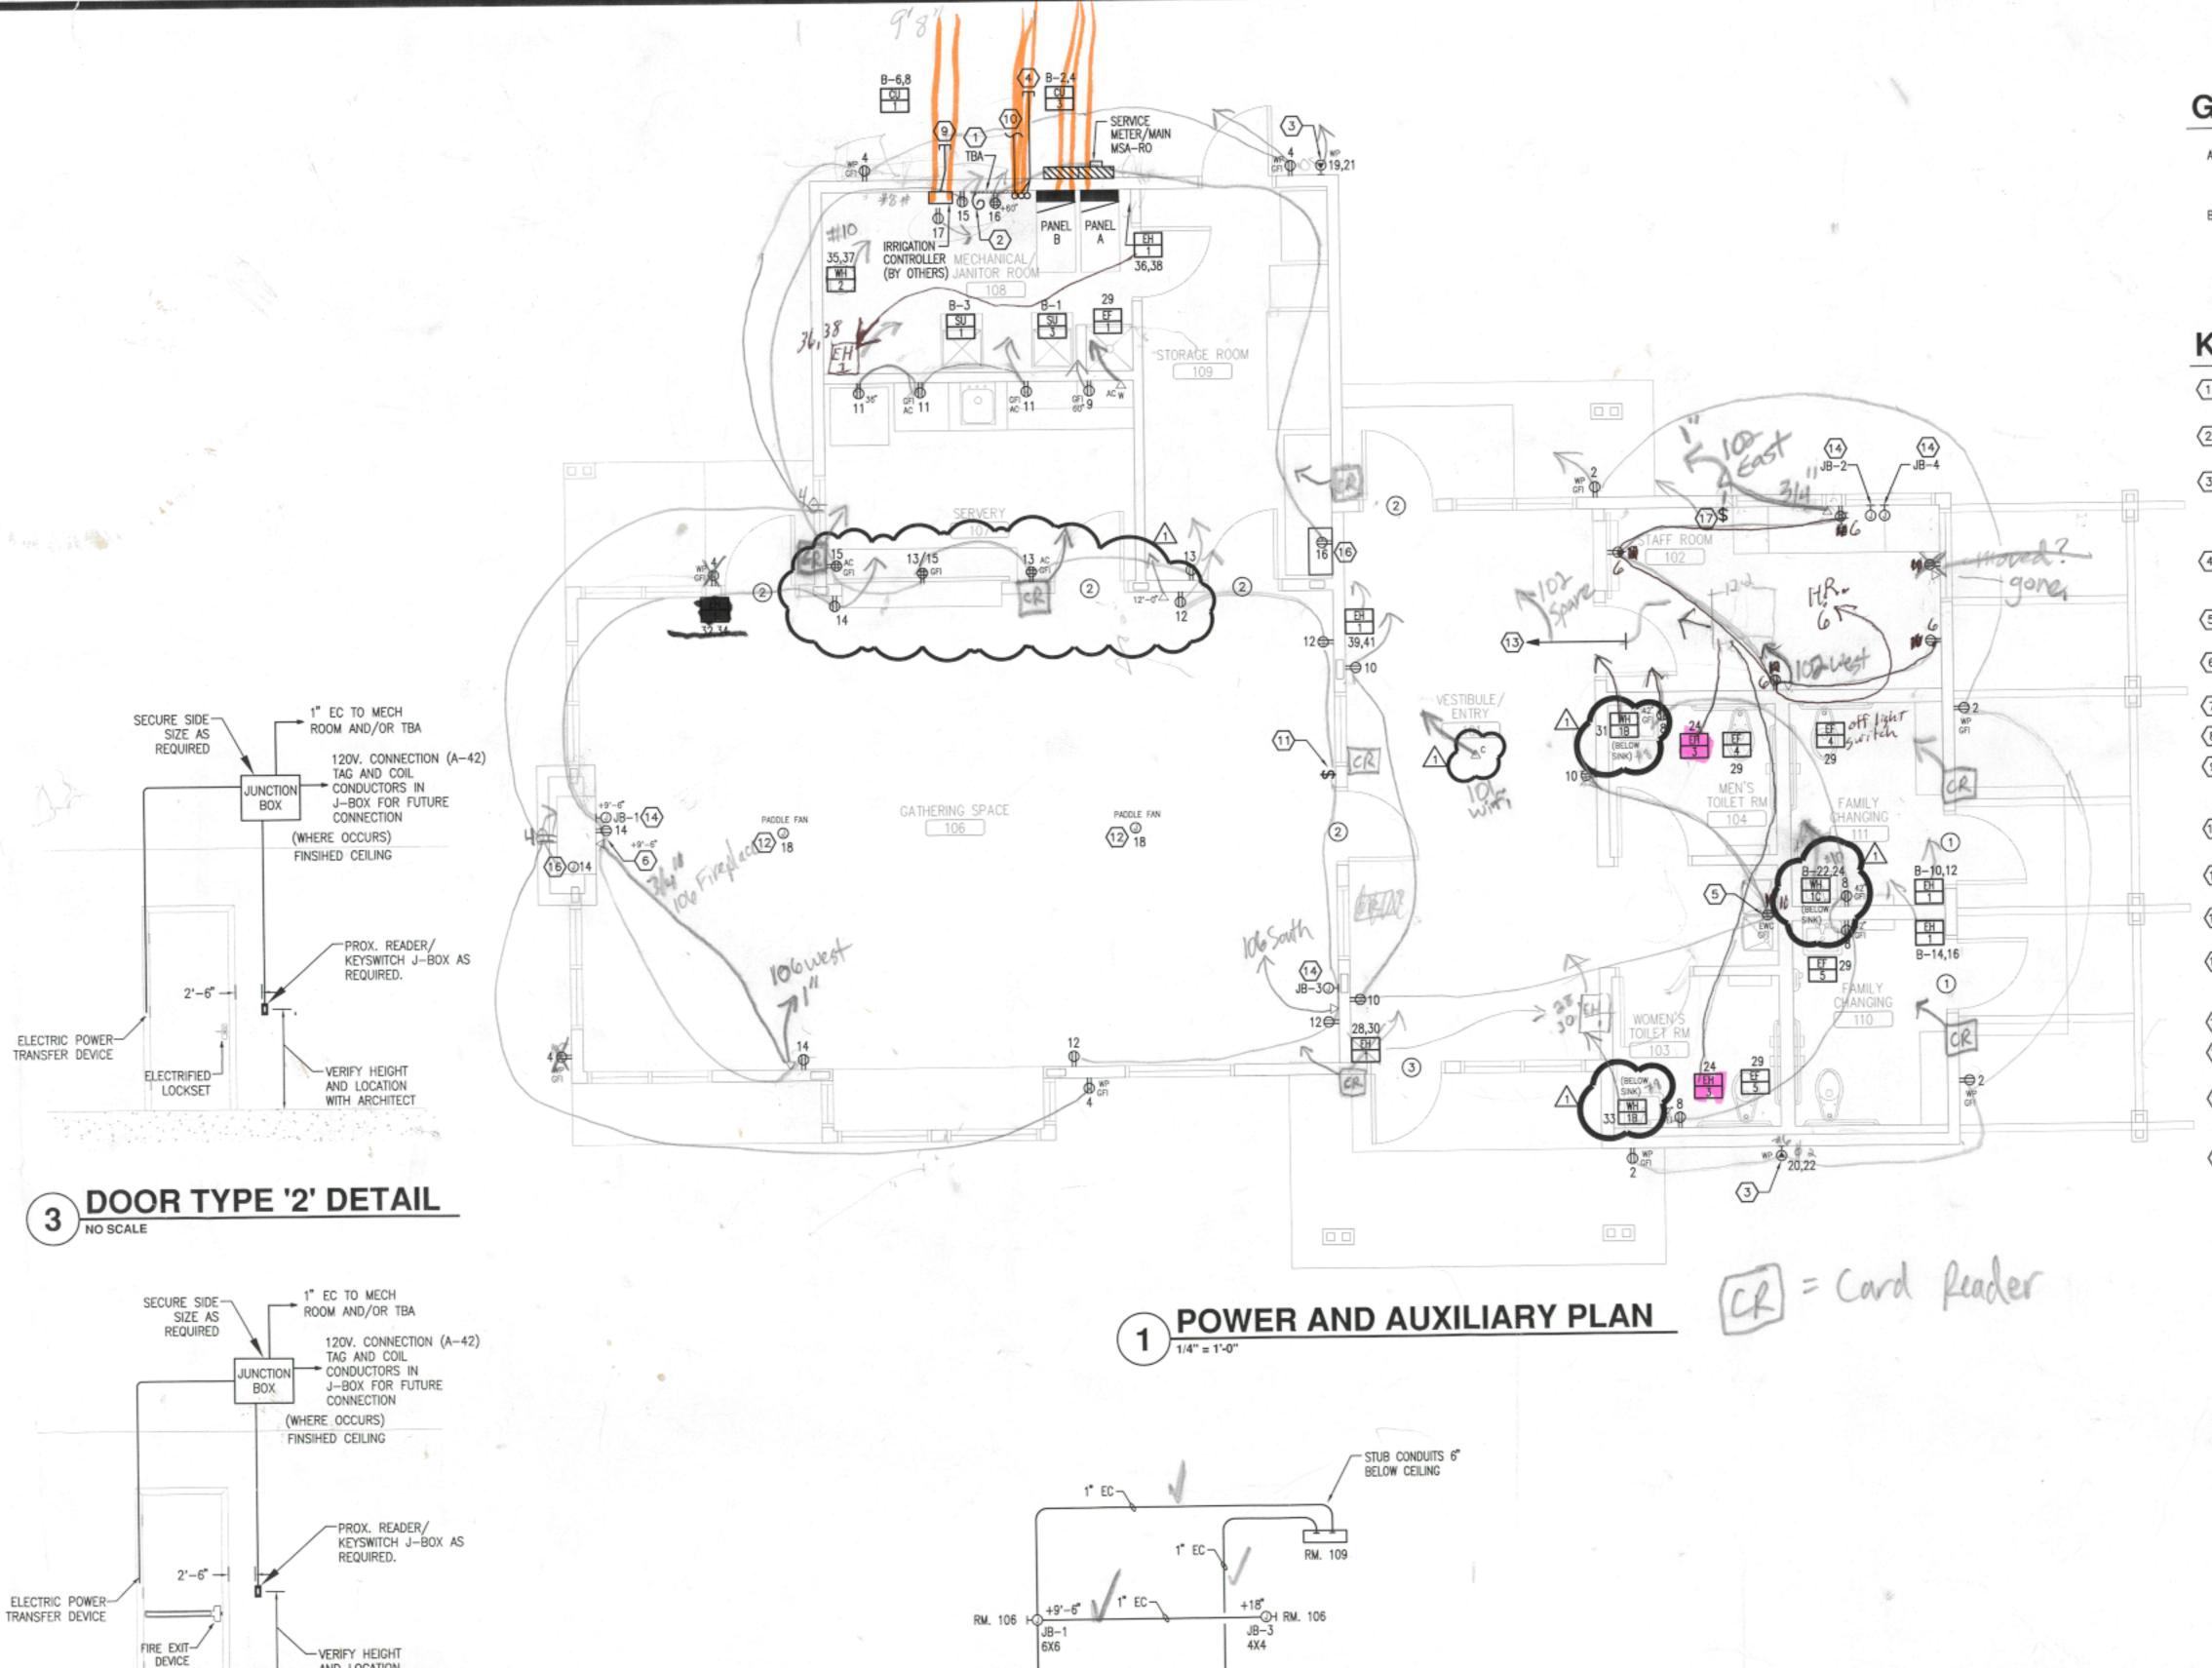



- A. ALL RECEPTACLES, DEVICES, EQUIPMENT, ETC. SHOWN ON THIS SHEET SHALL BE CIRCUITED TO PANEL A UNLESS INDICATED OTHERWISE.
- B. SEE 2/RO-e3.0 FOR TYPICAL COMMUNICATION ROUGH-IN DETAIL.

KEYNOTES

- TERMINAL BOARD TBA 3/4"X2'X4' FIRE RATE PLYWOOD BACKBOARD. PAINT WHITE WITH FIRE RETARDANT PAINT.
- #6 CU. GROUND CONDUCTOR TO SERVICE MSA GROUND. PROVIDE 4' SLACK AT TBA.
- 3 PROVIDE NEMA 14-50R OUTLET AT +24". WIRE WITH (3) #6 + (1) #10 GND. PROVIDE LOCKING W.P. OUTLET BOX EQUAL TO COLE #TL310-WCS-MOD. MOUNT OUTLET IN BOX AT +24".
- (2) 1/4°C. WITH PULL STRINGS STUBBED OUT OF BUILDING TO GRASS AREA, CAP, AND PROVIDE SURFACE MARKER FOR FUTURE USE.
- 5) CONCEAL OUTLET BEHIND EWC. COORDINATE EXACT LOCATION WITH EQUIPMENT.
- 6 VERIFY EXACT LOCATION WITH ARCHITECT PRIOR TO
- 7 NOT USED.
- 8 NOT USED.
- STUB (1) 1* CONDUIT OUT OF BUILDING APPROXIMATELY 20', CAP, AND PROVIDE SURFACE MARKER FOR EXTENSION BY OTHERS (IRRIGATION CONTROL WIRING).
- (1) 2" CONDUIT WITH PULLSTRING TO TELEPHONE POINT OF SERVICE. SEE 1/RO-e0.1 FOR CONTINUATION.
- PROVIDE SWITCH TO CONTROL PADDLE FANS. MOUNT ADJACENT TO ROOM LIGHTING CONTROL SWITCHES.
- PROVIDE 120V CONNECTION VIA FAN CONTROL SWITCH. CONNECT TO CIRCUIT INDICATED ON PLAN.

AND STUB AT TBA.

- (13) 3/4" EMPTY CONDUIT STUBBED INTO STAFF ROOM CEILING FOR FUTURE WAP. RUN CONDUIT TO ROOM 108
- (14) J-BOX AND CONDUIT FOR A/V CABLING. SEE 2/RO-e2.1.
- 15 STUB A/V CONDUITS 6" BELOW CEILING AT THIS
- (16) CONNECT GAS FIREPLACE MODULE PER MANUFACTURER.
 ROUTE CIRCUIT THROUGH SWITCH IN STAFF ROOM 102 FOR ON/OFF CONTROL.
- 17) SWITCH FOR ON/OFF CONTROL OF FIREPLACE. LABEL

YOUR NEIGHBORHOOD OUR COMMUNITY ROSEVILLE PARKS & RECREATION RENEWAL PROGRAM

ROSEVILLE PARKS & RECREATION

2660 CIVIC CENTER DRIVE ROSEVILLE, MINNESOTA 55113



PERFORMANCE DRIVEN DESIGN.

250 3rd Ave. N, Ste 450 | Minneapolis, MN 55401 | 612.338.2029



emanuelson-podas consulting engineers 10401 Bren Road East Minnetonka, MN 55343 ph: 952-930-0050

I hereby certify that this drawing was prepared by me or under my direct supervision and that I am a duly registered architect under the laws of

fax: 952-930-0777

www.epinc.net



BY: Matthew W. Fults

NO DATE ISSUED FOR

the State of Minnesota.

REG. NO.: 40887 DATE: 01/21/2014

5	6/10/2014	CONSTRUCTION SET	
4	05/16/2014	REISSUE	
3	1/21/2014	PROPOSAL	
2	12/20/2013	90% REVIEW SET	
1	11/19/2013	CC PACKET	

07/24/2014 ASI #1 NO DATE REVISION

COPYRIGHT 2014 BY LHB, INC. ALL RIGHTS RESERVED.

PROJECT NAME:

ROSEVILLE PARK AND RECREATION RENEWAL PROGRAM

ROSEBROOK PARK 2590 FRY STREET ROSEVILLE, MINNESOTA 55113

DRAWING TITLE: POWER AND AUXILIARY PLAN

FILE: DRAWN BY: MD CHECKED BY: CM PROJ. NO: s\3587

DRAWING NO:

RO-e2.1

2 A/V CONDUITING SCHEMATIC

JB-2 4X4 +18[®] ♀ ♀+18°

AND LOCATION

4 DOOR TYPE '3' DETAIL
NO SCALE

WITH ARCHITECT

MOTOR									1	MOTOR CON	NECTIC	N SCHEDULE									
NO.	EQUIPMENT	LOCATION	HP/KW/					STARTE		DISC		CONTROL.			DEVICES TO BE INTERLOCKED			PANEL	FEEDER	NOTES	MOTOR
SU-1	FURNACE	LOCATION	AMPS	PHASE	VOLTS	TYPE	SIZE	LOC	BY	FU/SW	BY	CONTROL DEVICE	FURN BY	WIRED BY		FURN BY	WIRED BY		PH-G-C	MOTES	MOTOR
SU-3		ROOM 108	1/2 HP	1	120					20A 1P	ELEC		T			_	1	+		+	
30-3	FURNACE	ROOM 108	1/2 HP		120					20A 1P	ELEC		-	-				В	12-12-1/2"	1,2	SU-1
CILS			1 64															В	12-12-1/2*	1,2	SU-2
CU-3	CONDENSING UNIT	EXTERIOR	17.9 A	1	240					WP 30/60	ELEC		_								
CU-1	CONDENSING UNIT	EXTERIOR	22.5 A	1	240					WP 40/60	ELEC							В	10-10-3/4"	1,3	CU-S
										111 40/00	ELEC							В	10-10-3/4*	1,3	CU-1
EF-1	EXHAUST FAN	ROOM 108	2.0 A	1	120					20A 1P	FIED										
EF-4 (2 REQ.)	EXHAUST FAN	ROOM 104	2.0 A	1	120			_			ELEC	FAN SPEED SWITCH	MECH	ELEC	CONTROL W/ ROOM LTS,	ELEC	ELEC	A	12-12-1/2"	4	EF-1
EF-5 (2 REQ.)	EXHAUST FAN	ROOM 103	2.0 A	1	120					20A 1P	ELEC	FAN SPEED SWITCH	MECH	ELEC	CONTROL W/ ROOM LTS.	ELEC	ELEC	A	12-12-1/2"	4	EF-4
		1100111100	8.07	<u> </u>	120					20A 1P	ELEC	FAN SPEED SWITCH	MECH	ELEC	CONTROL W/ ROOM LTS.	ELEC	ELEC	A	12-12-1/2"	4	EF-6
H-1 (6 REQ.)	WALL ELECTRIC HEATER	SEE PLAN	2.0 KW	+ -	240		_	_				-							12-12-112	+	Ers
H-3 (2 REQ.)	RADIANT CEILING DANIEL	OFF PLAN	0.000.000	+							MFGR	T-STAT	MECH	MECH				Δ.	12-12-1/2*	+ +	EH-1
$\sim\sim$	~~~~~	O O O O O	375 W	-	120	RELAY	20A, 1P.	CLG	ELEC		MFGR	RELAY	ELEC	ELEC				<u>^</u>	12-12-1/2"		
WH-1B	ELECTRIC WATER HEATER (QUANTITY 2)	ROOM 103, 104		* *	-	~ ~	~ ~	~ ~		$\sim\sim$	$\sim\sim$	$\sim\sim\sim$	$\sim\sim$	\sim	$\sim\sim\sim$		~~	 ~~	~~~	$+\dot{\circ}+$	EH-3
WH-1C	ELECTRIC WATER HEATER		3.0 KW	1	120													-	8-10-1/2"		
JWH-2A A A	A A AFI ESTRIQUIATED HEAVES	ROOM 111	4.8 KW	1	240													1 2		1	WH-1
	CLEATERNIATE HATEL			\sim		\sim			~~	~~··~				A A			-:-	В .	10-10-1/2*	1	WH-1
												00000	000	\sim		$\sim\sim$	\sim	\sim			

ABBREVIATIONS:
MAG - MAGNETIC, HOA - HAND/OFF/AUTOMATIC, SS - START/STOP, TT - THERMAL TOGGLE, PB - PUSHBUTTON, START - STARTER, EMS - ENERGY MANAGEMENT SYSTEM, SW - TOGGLE SWITCH, BKR - CIRCUIT BREAKER

1. ROUTE POWER TO SINGLE POINT CONNECTION.

2. PROVIDE TOGGLE SWITCH FOR DISCONNECT,

3. PROVIDE NEMA 3R DISCONNECT AT UNIT FOR DISCONNECT. DISCONNECT MOUNTED TO UNIT SHALL NOT INTERFERE WITH SERVICE ACCESS, PROVIDE UNISTRUT SUPPORT IF REQUIRED, FUSE PER NAMEPLATE. 4. ELECTRICAL CONTRACTOR TO INSTALL AND CONNECT FAN SPEED SWITCH FURNISHED BY MECHANICAL CONTRACTOR, FAN SHALL BE CONTROLLED WITH ROOM LIGHTS.

5. CONNECT POWER TO UNIT VIA RELAY, LOCATE RELAY IN AN ACCESSIBLE LOCATION IN CEILING ADJACENT TO WH-1.


					P	ANEL	SC	<u>HEDU</u>	LE					
PANEL:	A	LOCATION	RM. 100	3		VOLTS		120	/	240		PH: 1-Phase		W: 3-Wire
AMP MAIN BRKR:	-	AMP MLO:	200		AIC	RATING	:	10,000			мо	UNT: SURFACE	FED FRO	M: MSA
			LOAD	CKT	Р	CIR	P	CIR	Р	CKT	LOAD			
CIRCUIT DESCRIPTION			VA	BKR	L	*	Н	2		BKR	KVA	CIRCUIT DESCRIPTIO	IN	
INTERIOR LIGHTING			706	20	1	1	Α	2	1	20	720	EXTERIOR RECEPTAC	LES	
INTERIOR LIGHTING			504	20	1	3	В	4	1	20	900	EXTERIOR RECEPTAC	LES	
INTERIOR LIGHTING			242	20	1	5	A	6	1	20	720	STAFF ROOM RECEP	ACLES	507037
EXTERIOR LIGHTING		NOTE 2	177	20	1	7	В	- 8	1	20	720	RESTROOMS RECEPT		
MICROWAVE RECEPTACLE			1200	20	1	9	A	10	1	20	1140	EWC & VESTIBULE RE		5
SERVERY RECEPTACLES			540	20	1	11	В	12	1	20	720	GATHERING SPACE I		
SERVERY & STORAGE RECEP	PTACLES		720	20	1	13	A	14	1	20	620	GATHERING SPACE F		
RECEPTACLES			720	20	1	15	В	- 16	1	20	360	TELECOM. BOARD R		
IRRIGATION CONTROLLER			800	20	1	17	A	18	1	20	700	(2) PADDLE FANS		
NEMA 14-50R OUTDOOR R	ECEPTACLE		2800	50	2	19	В	20	2	50		NEMA 14-50R OUTD	OOR RECEP	TACLE
			2800	-	-	21	A	22	-			-	011111001	TTOCK
SPARE				20	1	23	В	24	1	20	750	(2) EH-3		
SPARE				30	1	25] A	26	1	20		SPARE		
SPARE EPM, (2YEF-W, (2)YEF-5V	2000			30	1	27	В	28	2	15	1000	EH-1 (VESTIBULE)		
	~ ~ ~ ~	~ ~ ~	1200	~ 20~		29	A	30	-	-	1000			
WH-1B (RESTROOM)			3000	3P(##)	1	31	В	32	2	15	1000 4	EHET (GATHERING, 5)	ACE) C	DADT
WH-1B (RESTROOM)			3000	200	1) 33	A	34	-	-	1000	- Deleted	.1	710/-
	$\sim\sim$	\sim	مصر	30	~	35	В	36	2	15	1000	EH-1 (MECHANICAL F	(MOO)	
ELL 1 ACCETIBLUE			2500	-	-	37	Α	38	-	-	1000	- "		
EH-1 (VESTIBULE)			1000	15	2	39	В	40	1	20	150	EXTERIOR POLE LIGH	T :	NOTE 1
			1000	-	-	41	Α	42	1	20	300	DOOR CONTROL		NOTE 3
					419		1							NOTES.
	CONNECTED	FEEDER / SE	RVICE C	ALC .				NOTES:						
IGHTING	1.78 KVA	2.22	KVA (12:	5%)										
ARGEST MOTOR	0.00 KVA	0.00	KVA (12)	5%)			185	1. ROUT	TE CI	RCUIT	THRUT	S-1 & PS-1. SEE 2/RO-e	2.0	
REMAINING MOTORS	1.20 KVA	1.20	KVA (100	0%)				2. ROUT						
RECEPTACLES	15.48 KVA	15.48	KVA (100	0%)				3. PROV						
(ITCHEN EQUIPMENT	0.00 KVA	0.00	KVA (100	0%)			184				CICOIN	CLII .		
OTHER & MISC	12.00 KVA	12.00	KVA (100	9%)										
LECTRIC HEATING	8.75 KVA	8.75	KVA (100	(%)										
PARE / SPACE	0.00 KVA	0.00	KVA (100	9%)										
TOTALS	39.21 KVA	39.65	KVA											
. 517465	163.3708 AMPS	29.03	KV/N											

PANEL: B AMP MAIN BRKR: — CIRCUIT DESCRIPTION SU-3 SU-1 SPORTS LIGHTING CONTROL SPARE SPARE SPARE		MLO: 200 LOAD VA 1176 1176 500		P 1 1 1 1	VOLTS RATING:		120 10,000 CIR #) /	240 CKT BKR		PH: 1-Phase W: 3-Wire UNT: SURFACE FED FROM: MSA
CIRCUIT DESCRIPTION SU-3 SU-1 SPORTS LIGHTING CONTROL SPARE SPARE SPARE SPARE	AME	LOAD VA 1176 1176	20 20 20	P 1 1	CIR #	P H	CIR #			LOAD	UNT: SURFACE FED FROM: MSA
SU-3 SU-1 SPORTS LIGHTING CONTROL SPARE SPARE SPARE		VA 1176 1176	20 20 20 20	1	1	Н	2				
SU-3 SU-1 SPORTS LIGHTING CONTROL SPARE SPARE SPARE		1176 1176	20 20 20	1	1	-	-	\vdash	BKR	KVA	
SU-1 SPORTS LIGHTING CONTROL SPARE SPARE SPARE		1176	20 20	1	_	J A	2		_		CIRCUIT DESCRIPTION
SPORTS LIGHTING CONTROL SPARE SPARE SPARE			20	-	3	1		2	40	2148	CU-3
SPARE SPARE SPARE		500		1.1		B	4	-	-	2148	_
SPARE SPARE			20	-	- 5	A	- 6	2	45	2700	CU-1
SPARE				1	7	В	- 8	-	-	2700	-
		_	20	1	9	Α	10	2	15	1000	EH-1
SPARE		_	20	1	11	В	12	-	-	1000	
SPARE SPARE		_	20	1	13	A	14	2	15	1000	EH-1
SPARE			20	1	15	В	16	-	-	1000	=
SPARE			20	1	17	A	18	1	20		SPARE
SPACE			20	2	19	В	20/	M	26	<u></u>	SPARE
SPACE					21	A	22	2	30	2400	WH-1C (FAMILY CHANGING)
SPACE					23	В	24 (-	-	2400	- /
SPACE			-	\vdash	25	A	26	44	\sim	\sim	SPACE
SPACE				Н	27	В	28	##			SPACE
SPACE				\vdash	29	A	30	##			SPACE
SPACE					31	В	32	94			SPACE
SPACE				\vdash	33	Λ	34	##			SPACE
SPACE				\vdash	35	В	36	##			SPACE
SPACE				\vdash	37	A	38	##	-		SPACE
SPACE		1		H	39	В	40	#0	-		SPACE
N ACE	CONTRACTOR OF THE PERSON NAMED IN			ш	41	A	42	$\theta \theta$			SPACE


TYPE	LIGHTING F	IXTURE	SCHEDU	LE					
TYPE	DESCRIPTION	VOLTAGE	LAMPS QUANTITY	TYPE	TOTAL WATTAGE	DIFFUSER	MOUNTING	MANUFACTURER	CATALOG NUMBER
A	6° LED DOWN LIGHT 1600 LUMEN OUTPUT, 3500K COLOR TEMP., 80+ CRI, CLEAR ALZAK SEMI-DIFFUSE REFLECTOR 0-10 VOLT DIMMING AND 30° SLOPE ADAPTER.	120		LED	30		RECESSED W 30° SLOPE ADAPTER	PRESCOLITE MAXILUME	LC6LED120DM-6LCLED7358WT-SCA6D30
A1	6° LED DOWN LIGHT 1600 LUMEN OUTPUT, 3500K COLOR TEMP., 80+ CRI, CLEAR ALZAK SEMI-DIFFUSE REFLECTOR.	120		LED	30		RECESSED	PRESCOLITE MAXILUME	LC6LED120-6LCLED7358WT
В	6" LED DOWN LIGHT 1400 LUMEN OUTPUT, 3500K COLOR TEMP., 80+ CRI, CLEAR ALZAK SEMI-DIFFUSE REFLECTOR 0-10 VOLT DIMMING AND 30" SLOPE ADAPTER.	120		LED	24		RECESSED W/ 30° SLOPE ADAPTER	PRESCOLITE MAXILUME	LC6LED120DM-6LCLED6358WT-SCA6D30
B1	6" LED DOWN LIGHT 1400 LUMEN OUTPUT, 3500K COLOR TEMP., 80+ CRI, CLEAR ALZAK SEMI-DIFFUSE REFLECTOR.	120		LED	24		RÉCESSED	PRESCOLITE MAXILUME	LC6LED120-6LCLED6358WT
с	6" LED DOWN LIGHT 1000 LUMEN OUTPUT, 3500K COLOR TEMP., 80+ CRI, CLEAR ALZAK SEMI-DIFFUSE REFLECTOR 0-10 VOLT DIMMING.	120		LED	18		RECESSED	PRESCOLITE MAXILUME	LC6LED120DM-6LCLED5358WT
C1	6" LED DOWN LIGHT 1000 LUMEN OUTPUT, 3500K COLOR TEMP., 80+ CRI, CLEAR ALZAK SEMI-DIFFUSE REFLECTOR.	120		LED	18		RECESSED	PRESCOLITE MAXILUME	LC6LED120-6LCLED5358WT
D	LED DRY LOCATION STRIP LIGHT WITH DIFFUSE ACRYLIC LENS, 80+ CRI, 4000K COLOR TEMP. AND 2100 LUMEN OUTPUT.	120		LED	24		SURFACE	LITHONIA	MNSL-MV-M6
E	EXIT LIGHT, BATTERY TYPE WITH GREEN STENCIL LETTERS AND WHITE HOUSING.	120		LED	1		SURFACE ABOVE DOOR	LITHONIA DUAL-LITE	LQM-S-W-3-G-120/277-ELN
F	LED WALLPACK CUTOFF FIXTURE 1300 LUMEN OUTPUT, 65+ CRI, 3500K COLOR TEMP. AND WET LOCATION LABEL.	120		LED	21		SURFACE ABOVE DOOR	LUMARK HUBBELL LITHONIA	XTOR2A-N-PC1
×	EMERGENCY LIGHT, BATTERY TYPE WITH TWIN EMERGENCY LED HEADS.	120		LED	2		SUPEACE AT	LITHONIA DUAL-LITE	ELM2
X1	EMERGENCY LIGHT, BATTERY TYPE WITH (2) 6W ZENON LAMPS, DIE CAST HOUSING, BATTERYHEATER AND LISTED FOR COLD WEATHER AND WET LOCATIONS.	120		LED	21		SUBEACE	LITHONIA DUAL-LITE	AFNDBEXT
А3	6° LED DOWN LIGHT 1600 LUMEN OUTPUT, 3500K COLOR TEMP., 80+ CRI, CLEAR ALZAK SEMI-DIFFUSE REFLECTOR 0-10 VOLT DIMMING AND 15° SLOPE ADAPTER.	120		LED	30		RECESSED W 15' SLOPE ADAPTER	PRESCOLITE	LC6LED120DM-6LCLED7358WT-SCA6D15

1. CATALOG NUMBER INDICATES BASIC FIXTURE TYPE REQUIRED FOR THIS PROJECT, VERIFY WITH MANUFACTURER TO INCLUDE ALL OPTIONS AND ACCESSORIES REQUIRED FOR THIS INSTALLATION.

2. ELECTRICAL CONTRACTOR SHALL BE RESPONSIBLE FOR VERIFYING FIXTURE LOCATIONS, MOUNTING AND REQUIREMENTS WITH ARCHITECTURAL PLANS, SECTIONS, ELEVATIONS, AND REFLECTED CEILING PLANS PRIOR TO ORDERING FIXTURES. 3. ALL FINISHES TO BE VERIFIED WITH ARCHITECT. FINISH SELECTION TO BE FROM MANUFACTURER'S STANDARD FINISHES UNLESS INDICATED OTHERWISE. FINISHES SHALL BE VERIFIED AT TIME OF SHOP DRAWING SUBMITTAL.

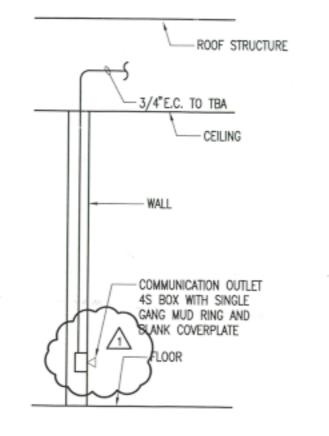

2 COMMUNICATION ROUGH-IN
NO SCALE

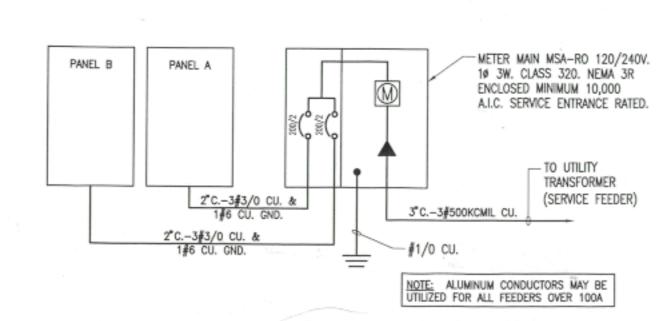

ELECTRICAL SINGLE LINE DIAGRAM



ROSEVILLE PARKS & RECREATION

2660 CIVIC CENTER DRIVE ROSEVILLE, MINNESOTA 55113



PERFORMANCE DRIVEN DESIGN. LHBcorp.com

250 3rd Ave. N, Ste 450 | Minneapolis, MN 55401 | 612.338.2029



emanuelson-podas consulting engineers

10401 Bren Road East Minnetonka, MN 55343 ph: 952-930-0050 fax: 952-930-0777 www.epinc.net

I hereby certify that this drawing was prepared by me or under my direct supervision and that I am a duly registered architect under the laws of the State of Minnesota.

BY: Matthew W. Fults TITLE: ENGINEER DATE: 01/21/2014 REG. NO.: 40887

5	6/10/2014	CONSTRUCTION SET
4	05/16/2014	REISSUE
3	1/21/2014	PROPOSAL
2	12/20/2013	90% REVIEW SET
1	11/19/2013	CC PACKET
NO	DATE	ISSUED FOR

07/24/2014 ASI #1 NO DATE REVISION

COPYRIGHT 2014 BY LHB, INC. ALL RIGHTS RESERVED.

PROJECT NAME:


ROSEVILLE PARK AND RECREATION RENEWAL PROGRAM

ROSEBROOK PARK 2590 FRY STREET ROSEVILLE, MINNESOTA 55113

DRAWING TITLE: ELECTRICAL SINGLE LINE DIAGRAM AND SCHEDULES

FILE: DRAWN BY: MD CHECKED BY: CM PROJ. NO: s\3587



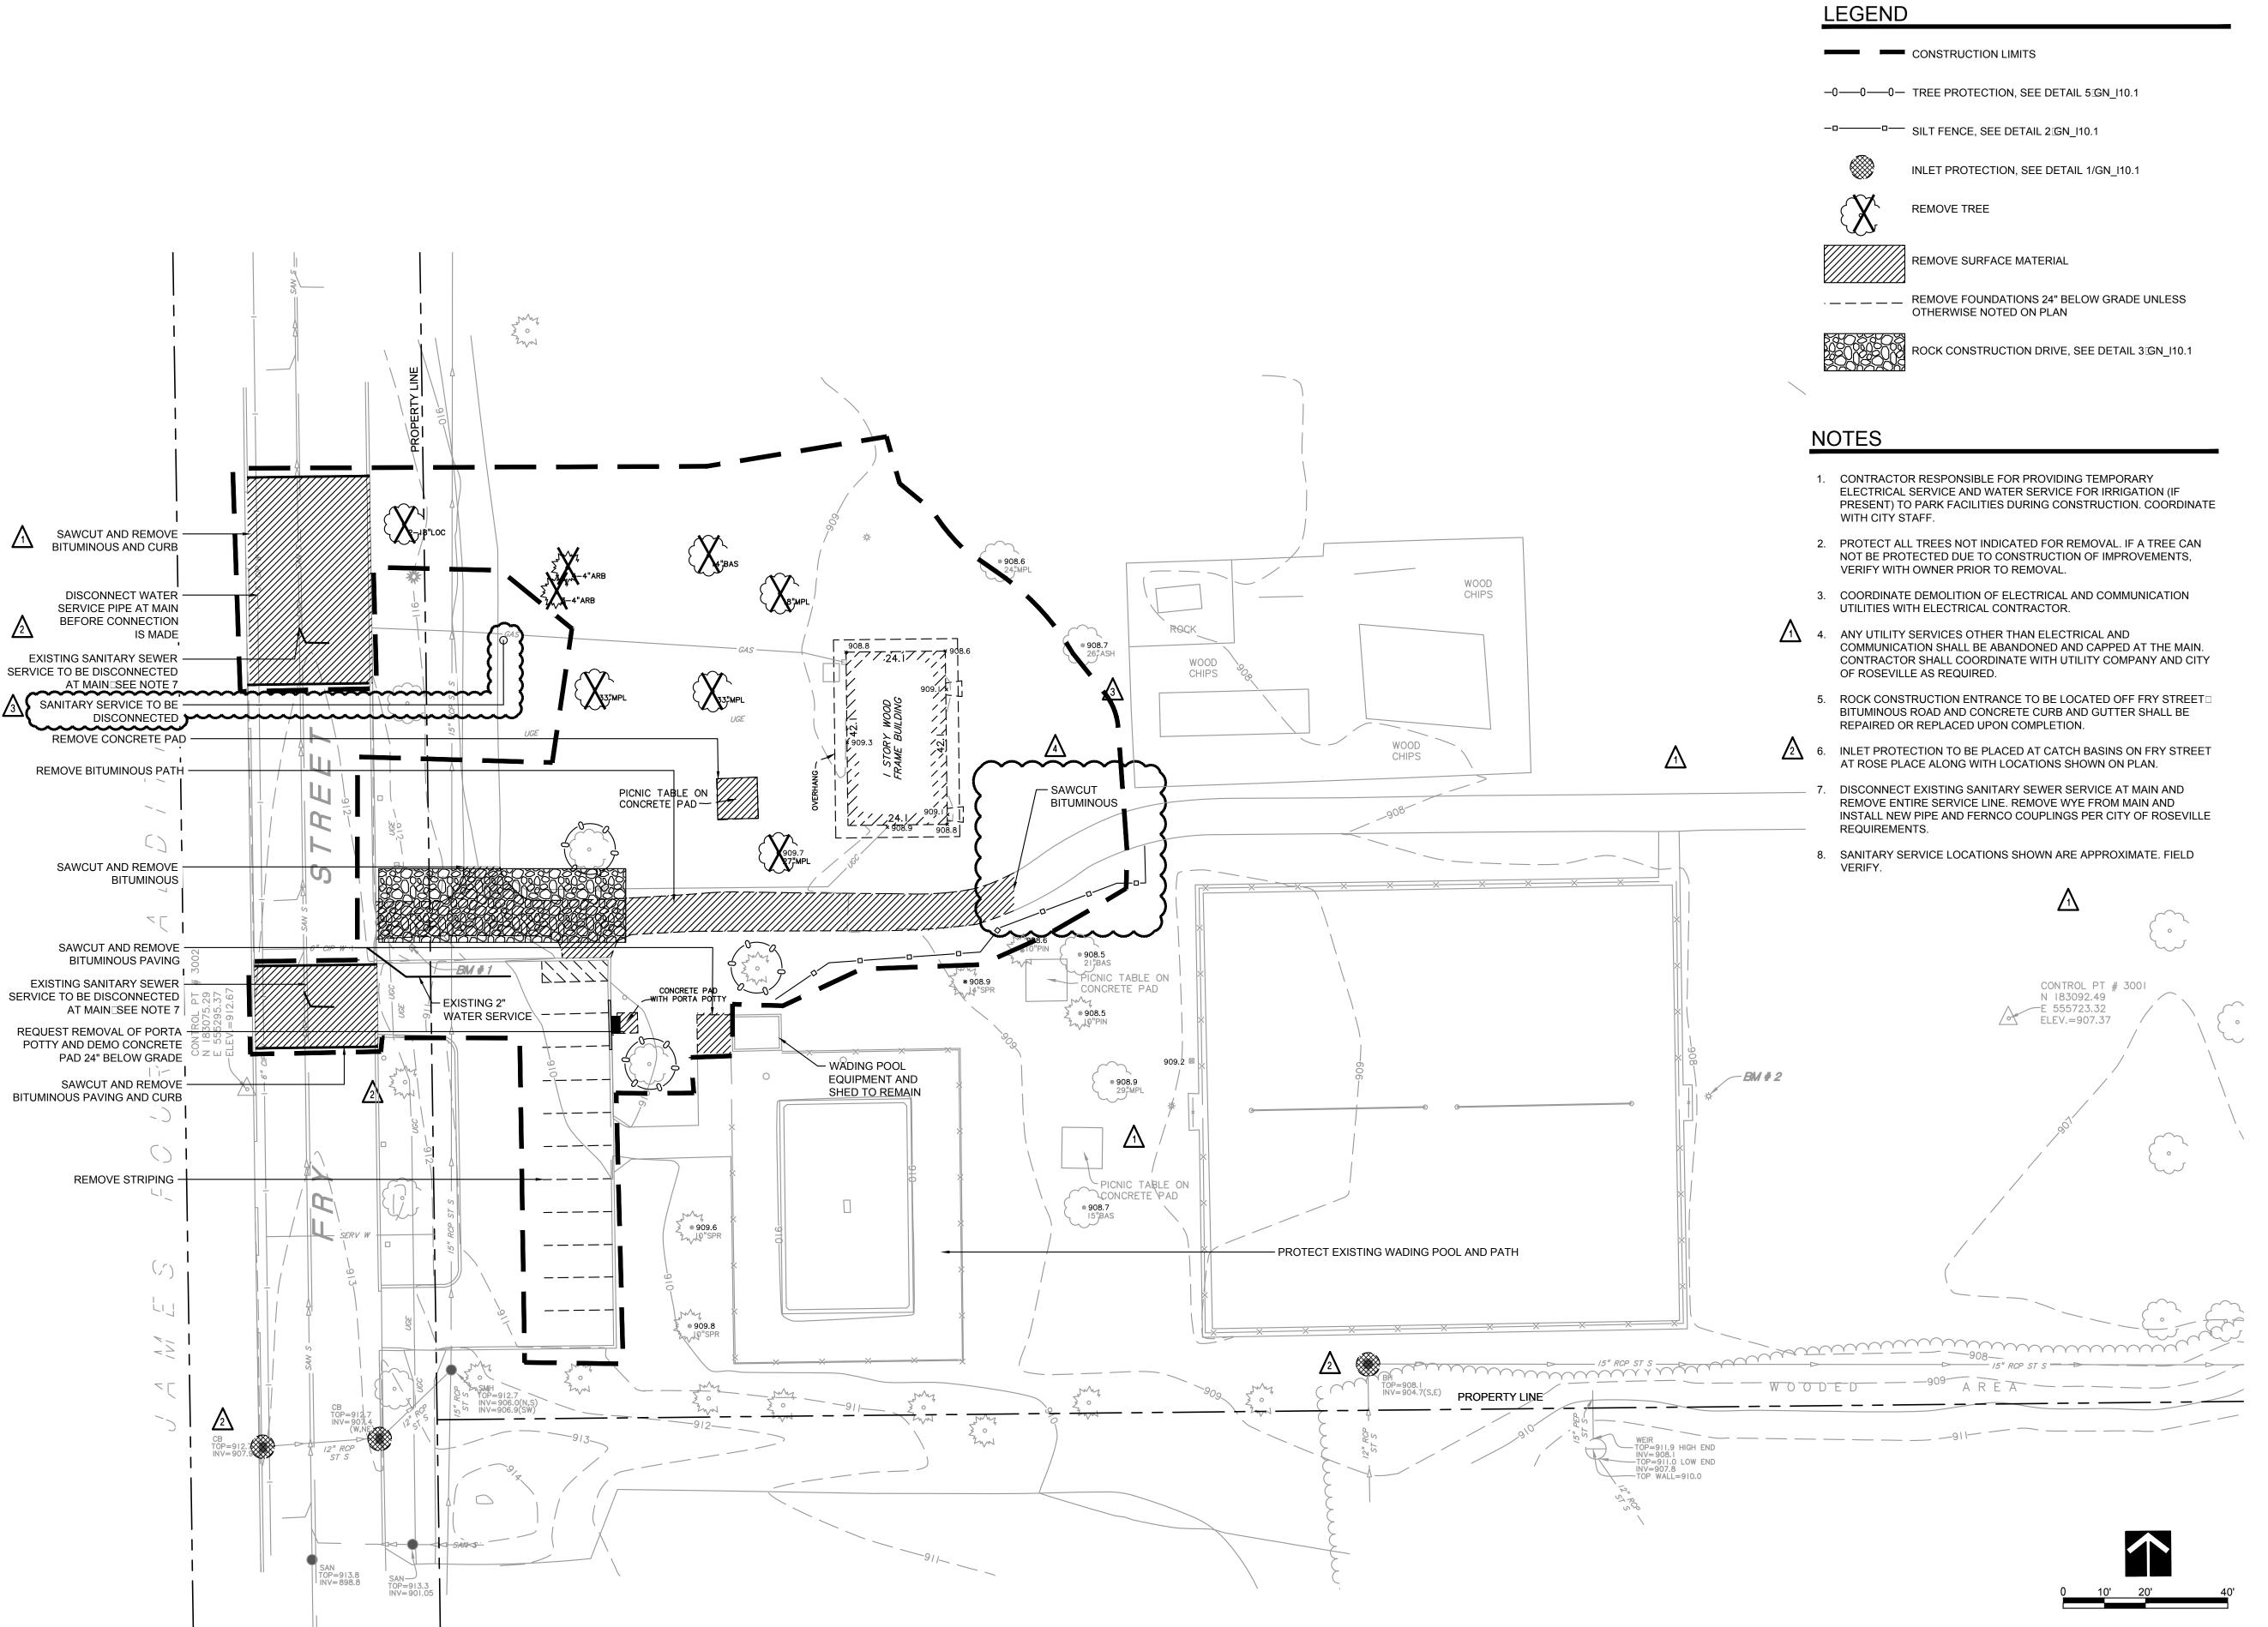



2660 CIVIC CENTER DRIVE ROSEVILLE, MINNESOTA 55113



701 Washington Ave. N, Ste 200 | Minneapolis, MN 55401 | 612.338.2029

I HEREBY CERTIFY that this plan, specifica tion or report was prepared by me or under my direct supervision and that I am a duly Licensed Landscape Architect under the laws of the State of Minnesota.

SIGNATURE:

TYPED OR PRINTED NAME: MICHAEL SCHROEDER

DATE: 01/21/2014 REG. NO.: 19664

5	07/17/2014	RCWD PERMIT	
4	06/10/2014	CONSTRUCTION SET	
3	01/21/2014	PROPOSAL	
2	12/20/2013	90% REVIEW SET	
1	10/24/2013	50% REVIEW SET	
NO	DATE	ISSUED FOR	

Δ	11/18/2014	ASI 6	
$\sqrt{3}$	09/29/2014	ASI 3	
$\sqrt{2}$	08/29/2014	ASI 2	
$\overline{\Lambda}$	07/24/2014	ASI 1	
NO	DATE	REVISION	

COPYRIGHT 2014 BY LHB, INC. ALL RIGHTS RESERVED

ROSEVILLE PARK AND RECREATION RENEWAL PROGRAM

ROSEBROOK PARK 2590 FRY STREET ROSEVILLE, MINNESOTA 55113


DEMOLITION PLAN

FILE: ...\130225\600 Drawings\LA\Rosebrook Park\CD SET\130225 Rosebrook_L1.0

DRAWN BY: BMD

CHECKED BY: LAM

PROJ. NO: 130225
DRAWING NO:

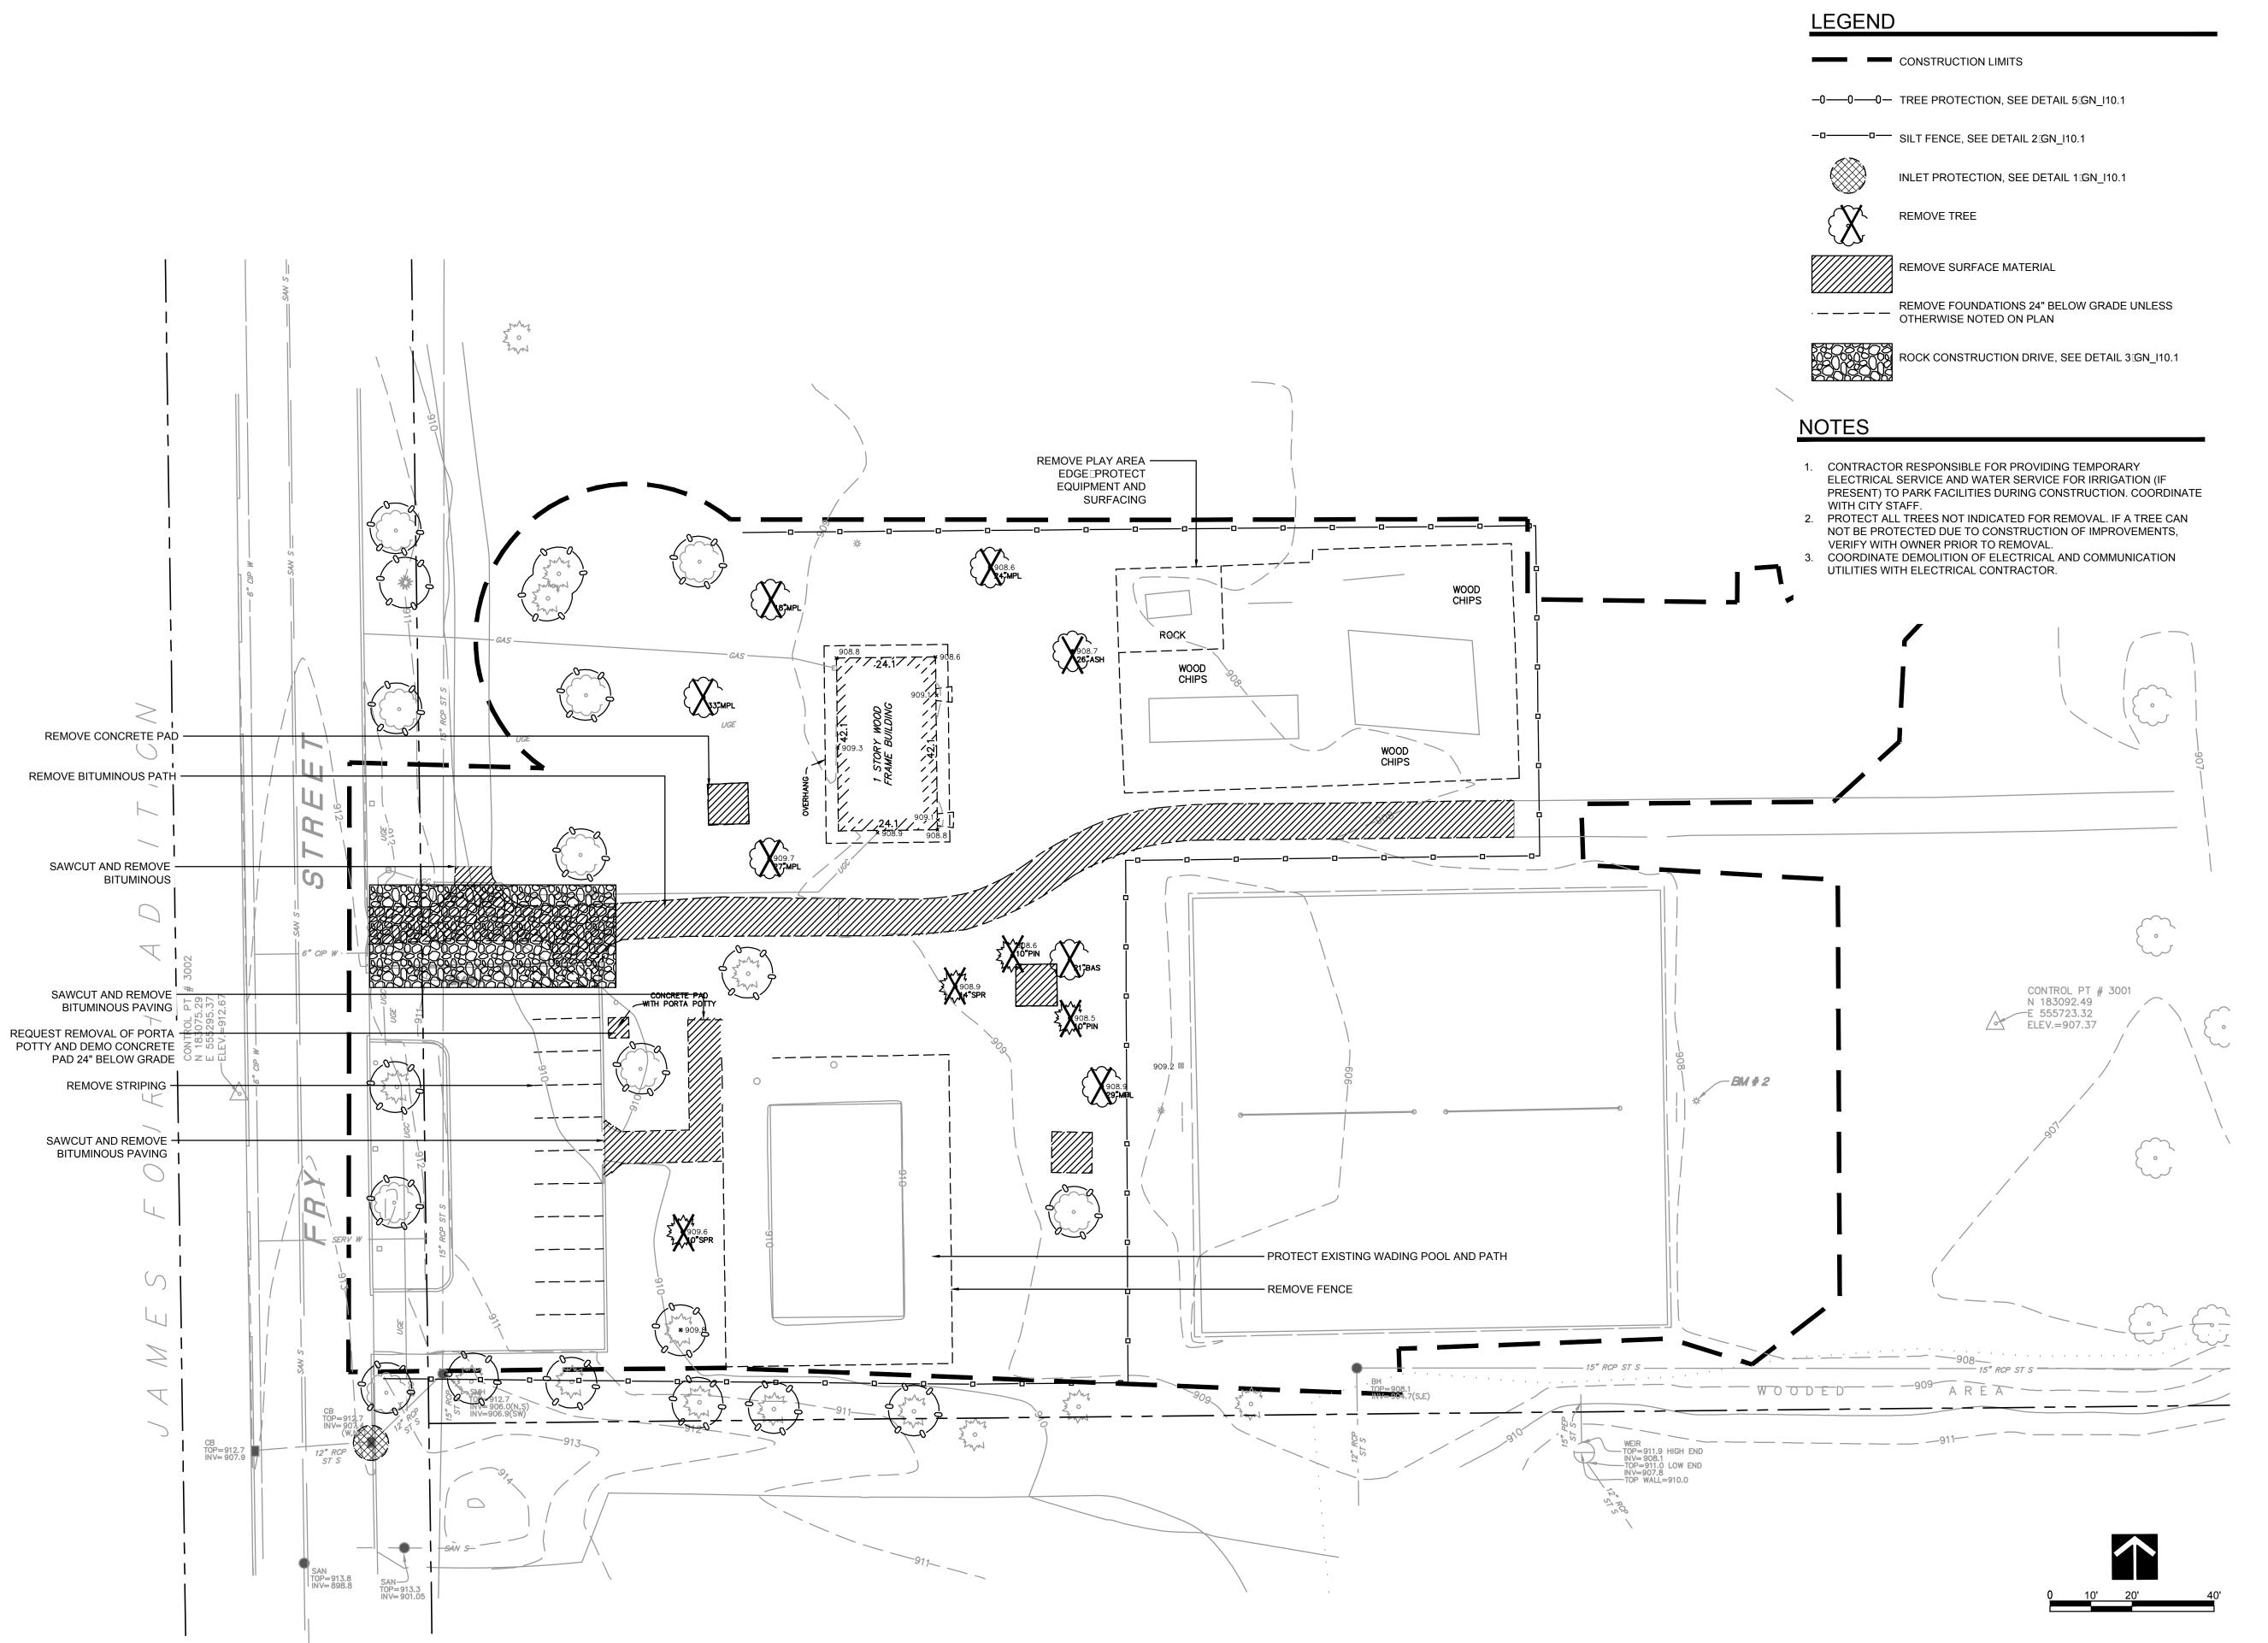



2660 CIVIC CENTER DRIVE ROSEVILLE, MINNESOTA 55113



701 Washington Ave. N, Ste 200 | Minneapolis, MN 55401 | 612.338.2029

I HEREBY CERTIFY that this plan, specifica tion or report was prepared by me or under my direct supervision and that I am a duly Licensed Landscape Architect under the laws of the State of Minnesota.

SIGNATURE:

TYPED OR PRINTED NAME: MICHAEL SCHROEDER

DATE: <u>01/21/2014</u> REG. NO.: <u>19664</u>

3	01/21/2014	BID	
2	12/20/2013	90% REVIEW SET	
1	10/24/2013	50% REVIEW SET	
NO	DATE	ISSUED FOR	

COPYRIGHT 2014 BY LHB, INC. ALL RIGHTS RESERVED

REVISION

PROJECT NAME:

ROSEVILLE PARK

NO DATE


AND RECREATION RENEWAL PROGRAM

ROSEBROOK PARK 2590 FRY STREET ROSEVILLE, MINNESOTA 55113

DEMOLITION PLAN

FILE: ...\130225\600 Drawings\LA\Rosebrook Park\CD SET\130225 Rosebrook_L1.0
DRAWN BY: BMD
CHECKED BY: LAM

CHECKED BY: LAM
PROJ. NO: 130225
DRAWING NO:

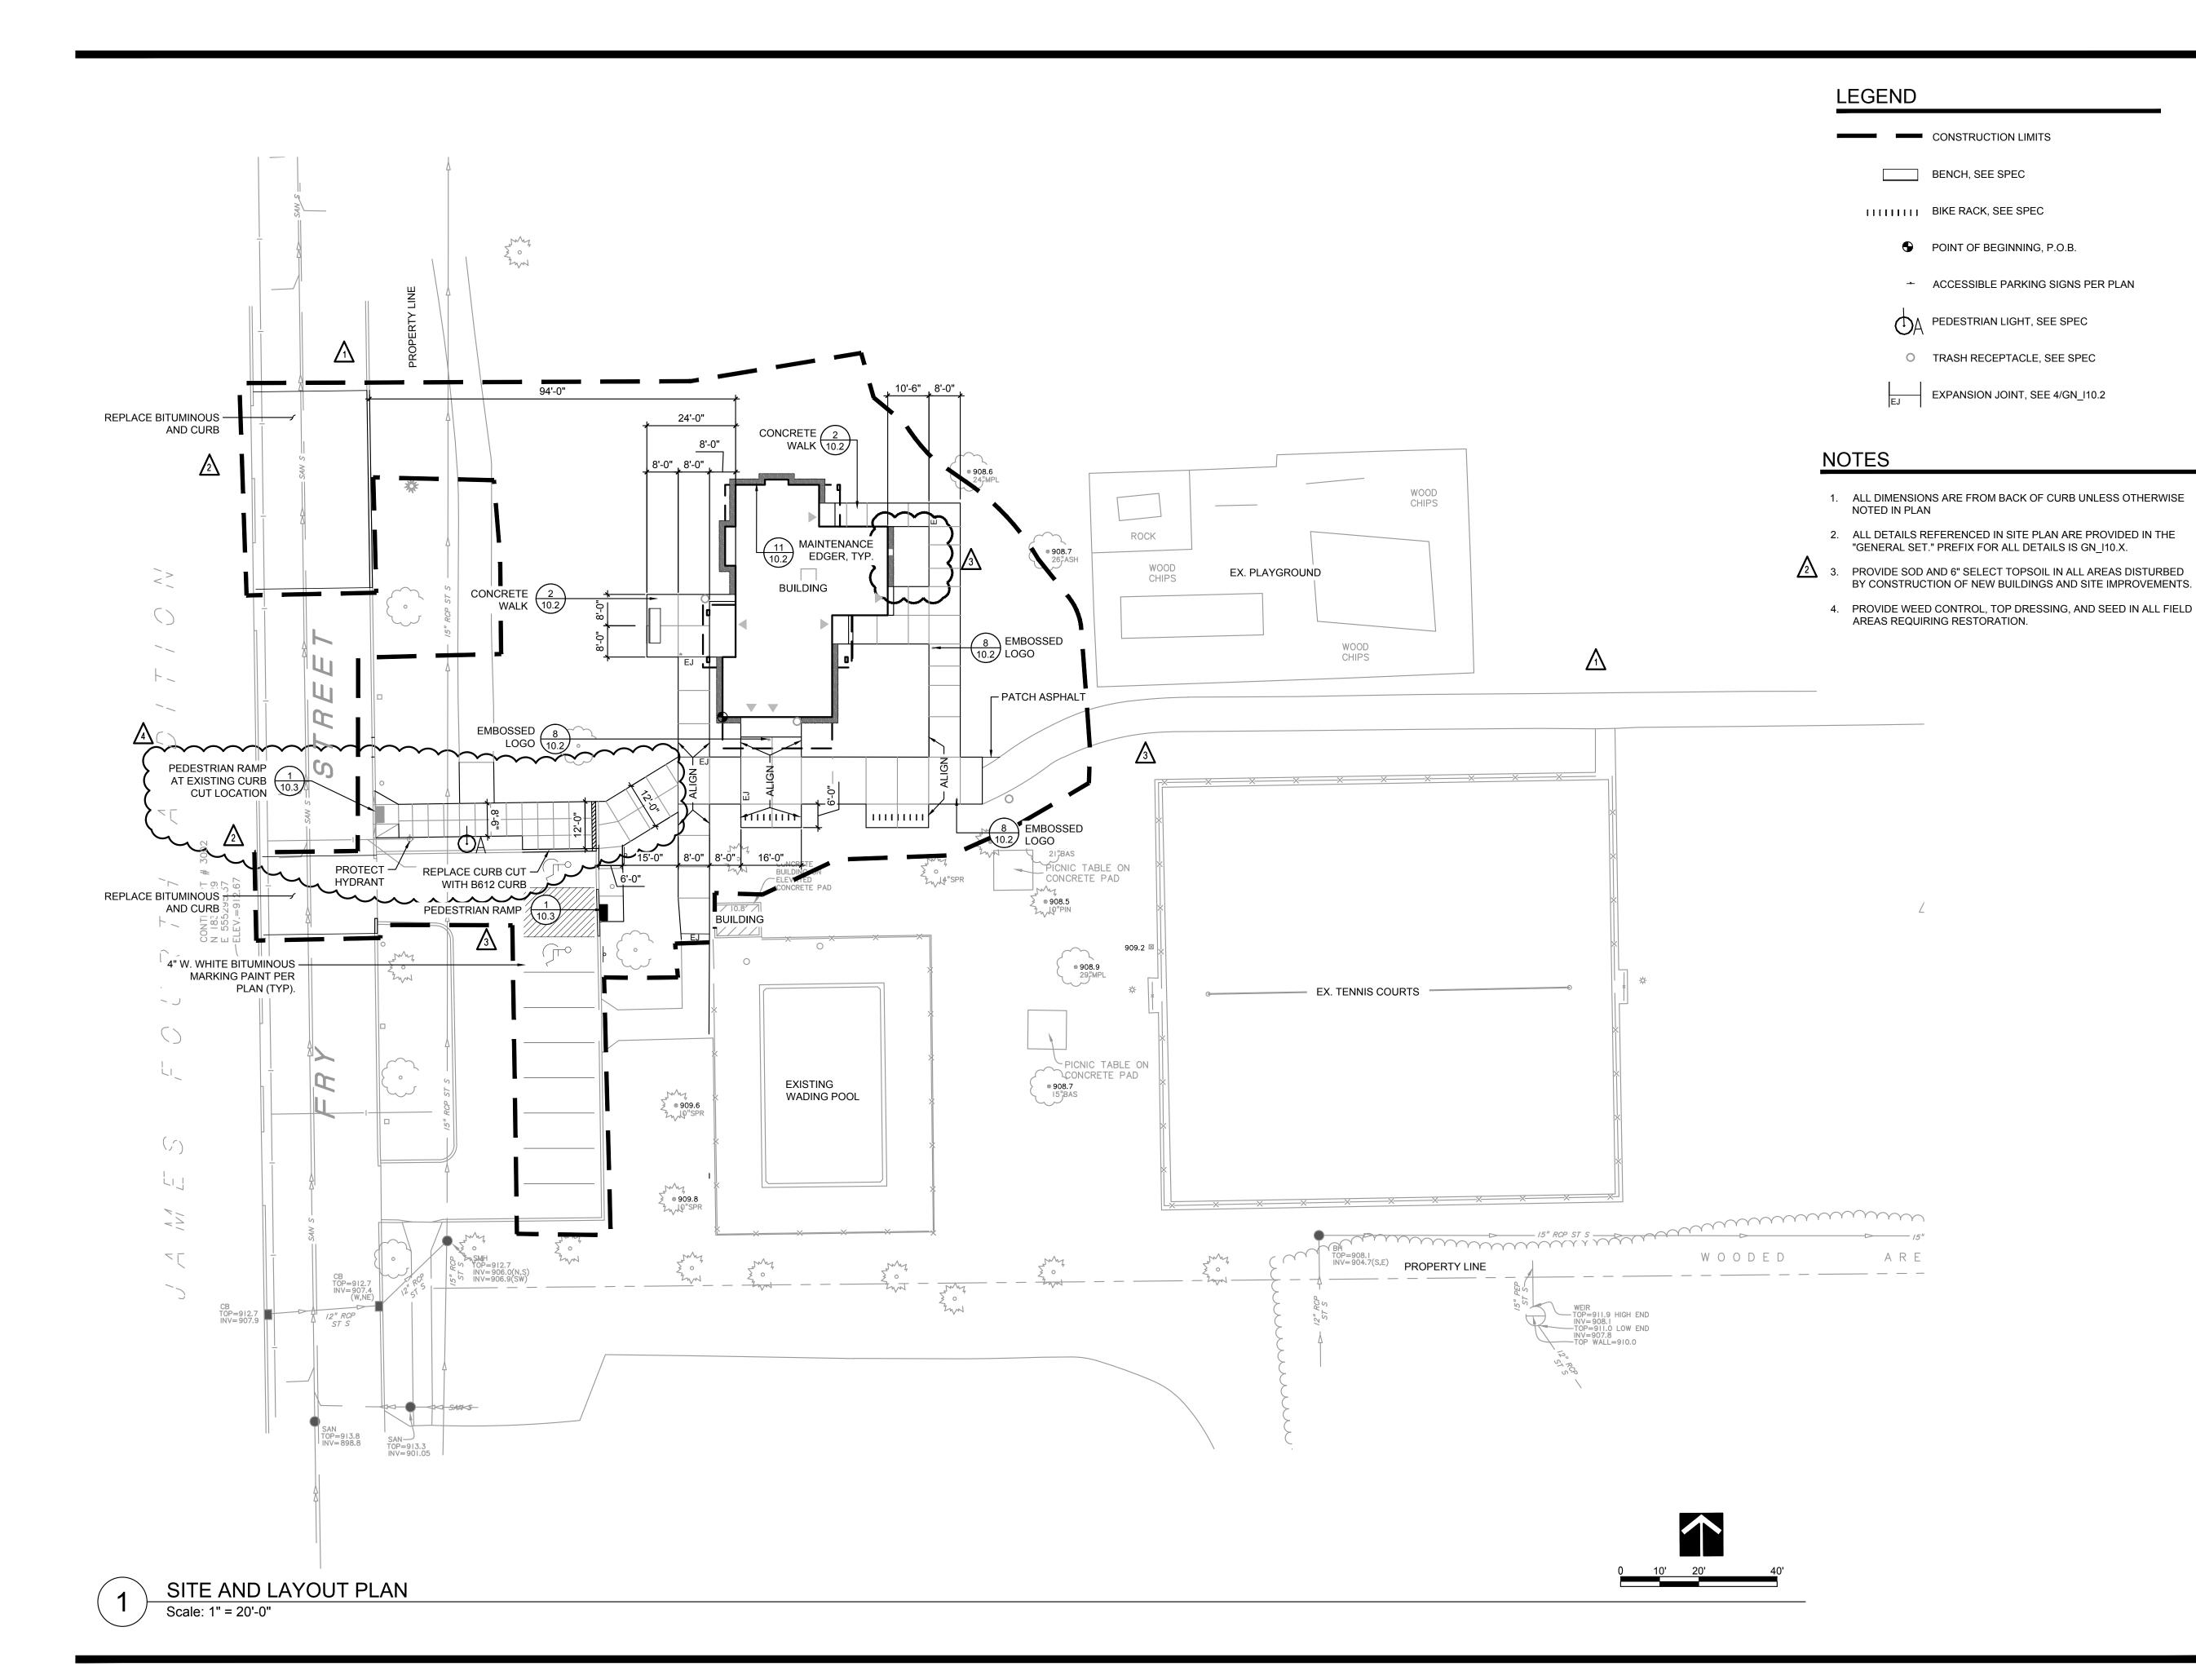



2660 CIVIC CENTER DRIVE ROSEVILLE, MINNESOTA 55113



701 Washington Ave. N, Ste 200 | Minneapolis, MN 55401 | 612.338.2029

I HEREBY CERTIFY that this plan, specifica tion or report was prepared by me or under my direct supervision and that I am a duly Licensed Landscape Architect under the laws of the State of Minnesota,

DATE: <u>04/30/2015</u> REG. NO.: <u>46911</u>

5	07/17/2014	RCWD PERMIT	
4	06/10/2014	CONSTRUCTION SET	
3	01/21/2014	PROPOSAL	
2	12/20/2013	90% REVIEW SET	
1	10/24/2013	50% REVIEW SET	
NO	DATE	ISSUED FOR	

04/30/2015	ASI 9	
3 11/18/2014	ASI 6	
2 08/29/2014	ASI 2	
07/24/2014	ASI 1	
NO DATE	REVISION	

COPYRIGHT 2014 BY LHB, INC. ALL RIGHTS RESERVED.

ROSEVILLE PARK AND RECREATION RENEWAL PROGRAM


ROSEBROOK PARK 2590 FRY STREET ROSEVILLE, MINNESOTA 55113

DRAWING TITLE:
SITE PLAN

FILE: ...\130225\600 Drawings\LA\Rosebrook Park\CD SET\130225 Rosebrook_L2.0 DRAWN BY: BMD

CHECKED BY: LAM
PROJ. NO: 130225

RO_I2.0

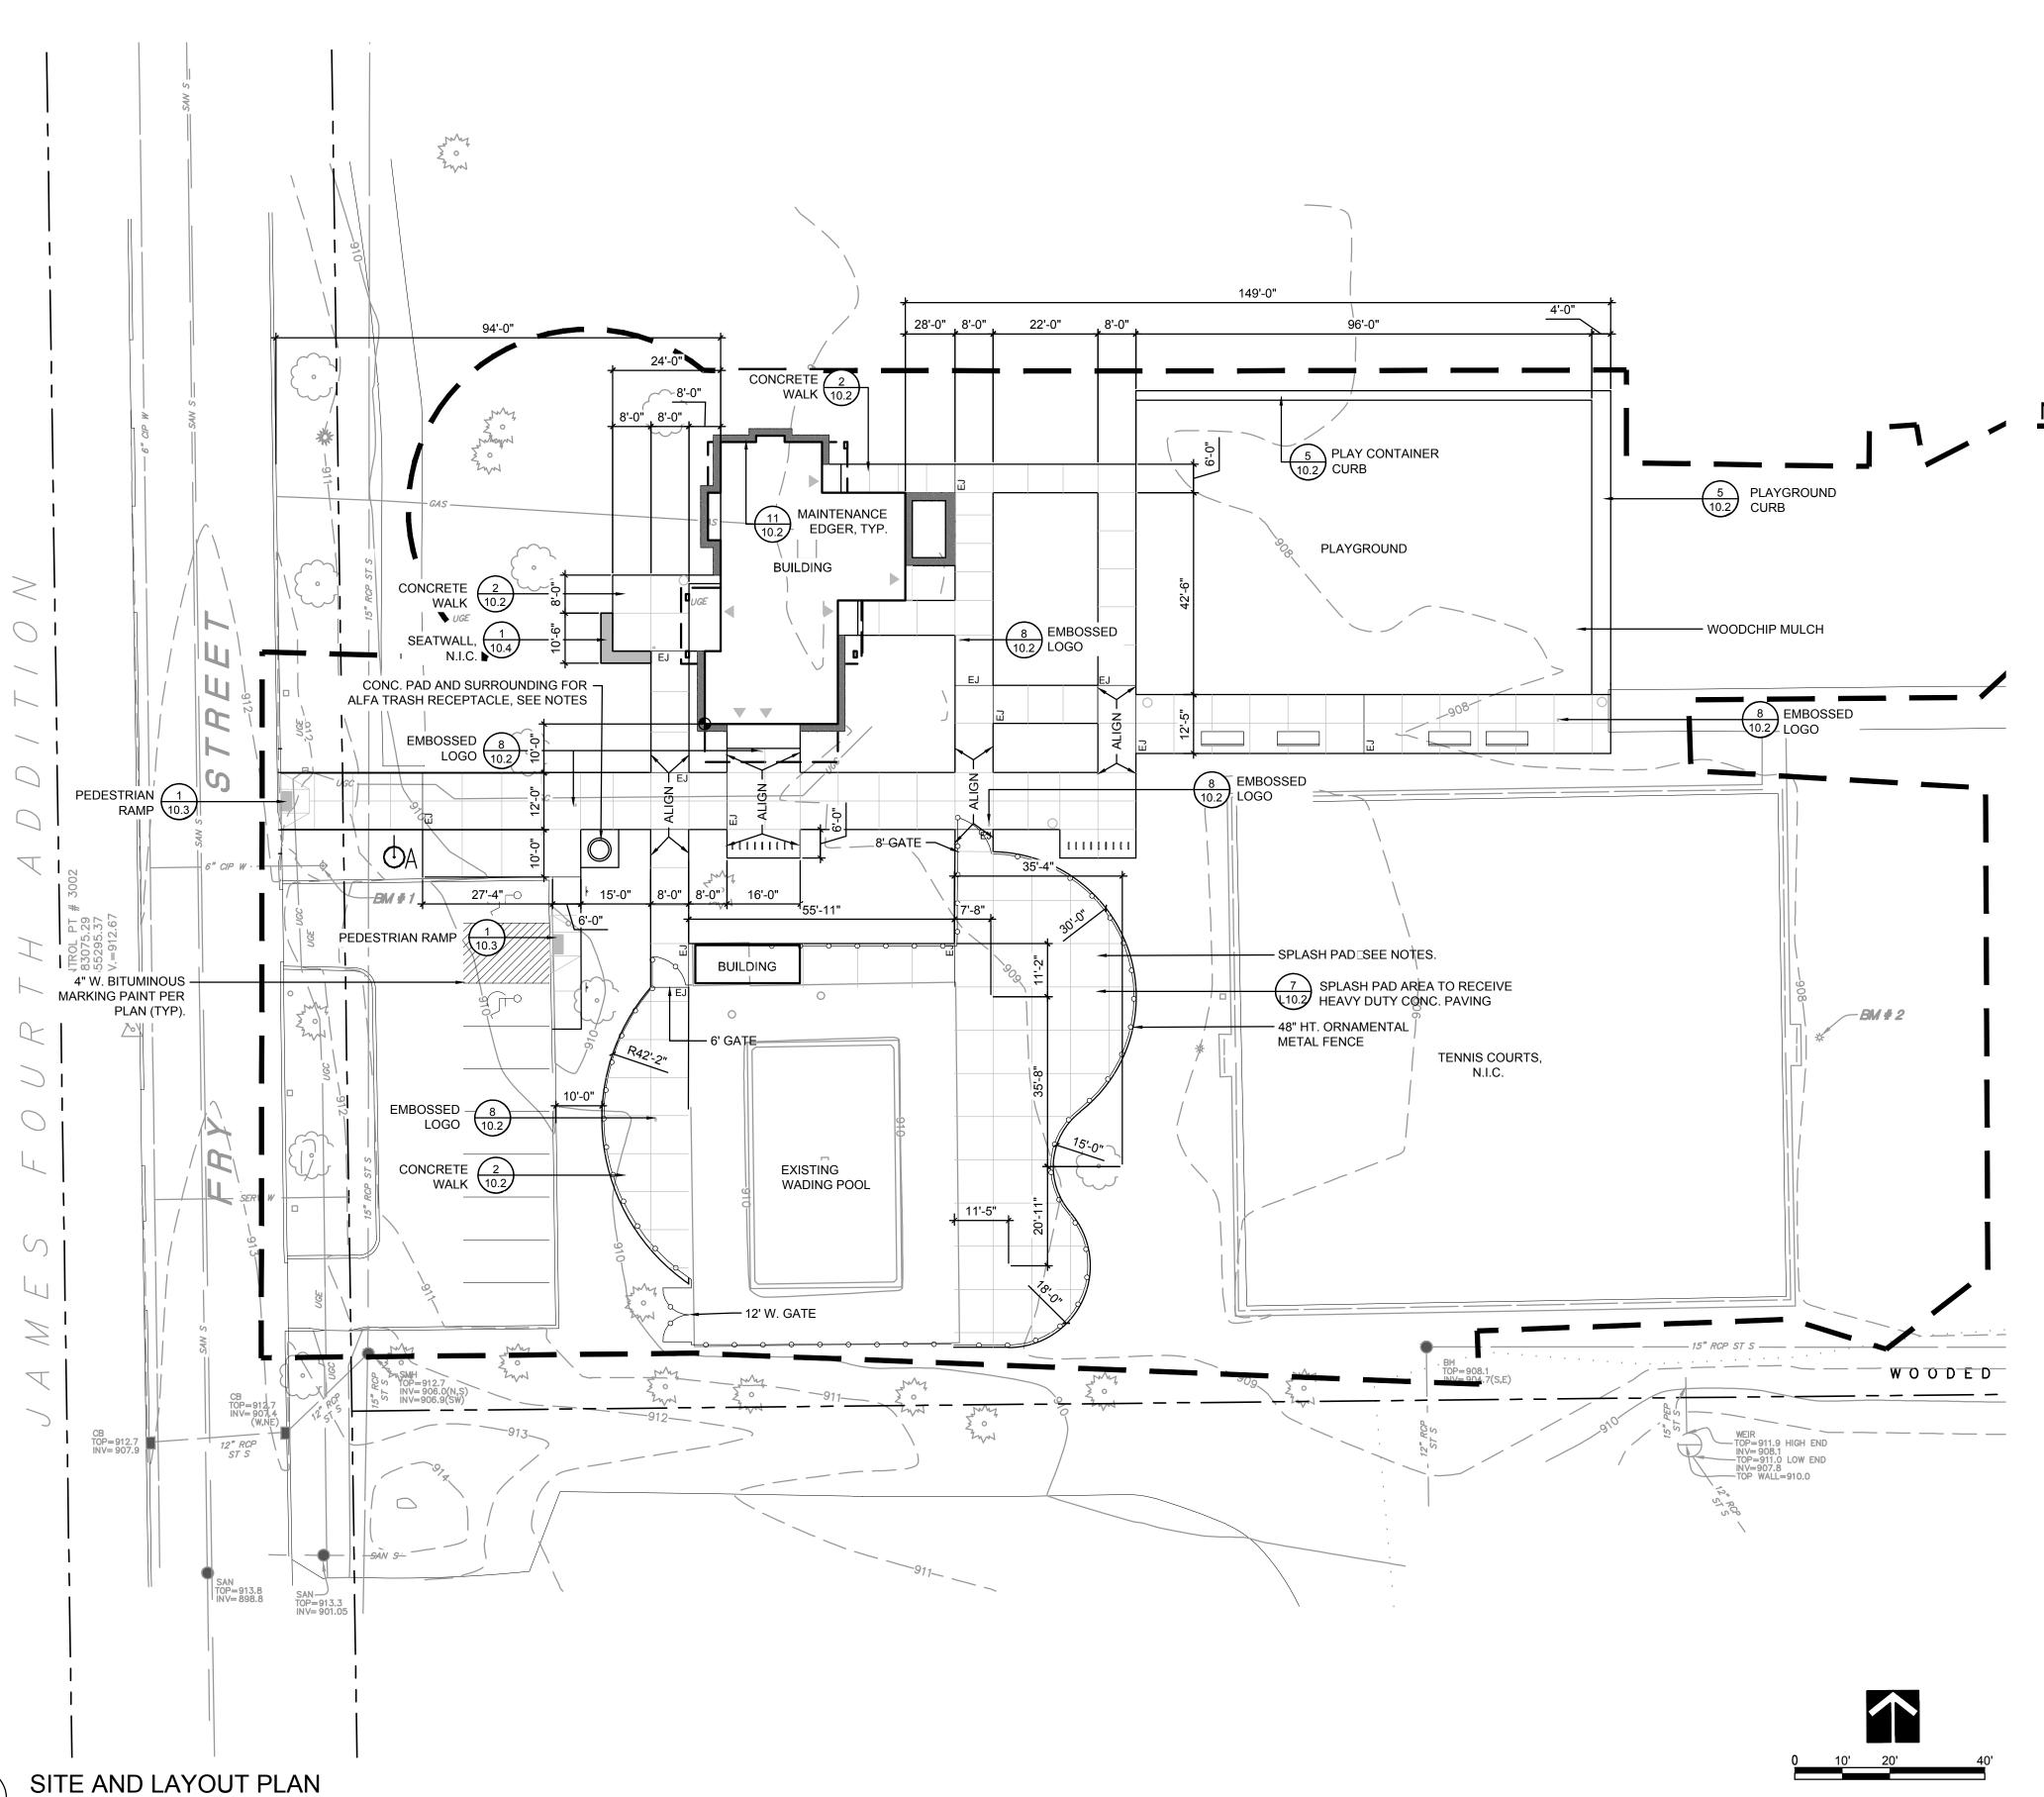



CONSTRUCTION LIMITS

BENCH, SEE SPEC

IIIIIIIII BIKE RACK, SEE SPEC

POINT OF BEGINNING, P.O.B.

→ ACCESSIBLE PARKING SIGNS PER PLAN

PEDESTRIAN LIGHT, SEE SPEC

O TRASH RECEPTACLE, SEE SPEC

EXPANSION JOINT, SEE 4/GN_I10.2

NOTES

- ALL DIMENSIONS ARE FROM BACK OF CURB UNLESS OTHERWISE NOTED IN PLAN
- 2. ALL DETAILS REFERENCED IN SITE PLAN ARE PROVIDED IN THE
- "GENERAL SET." PREFIX FOR ALL DETAILS IS GN_I10.X.
 3. ALFA TRASH RECEPTACLE TO BE INSTALLED BY CITY STAFF□
- CONTRACTOR TO INSTALL CONC. PAD AND SURROUND, SEE SPEC
 4. PROVIDE SOD IN ALL AREAS DISTURBED BY CONSTRUCTION OF NEW BUILDINGS AND SITE IMPROVEMENTS.
- 5. PROVIDE WEED CONTROL, TOP DRESSING, AND SEED IN ALL FIELD
- AREAS REQUIRING RESTORATION.

 6. COORDINATE WITH PLAYGROUND CONTRACTOR. PLAYGROUND CONTRACTOR RESPONSIBLE FOR INSTALLING PLAYGROUND EQUIPMENT AND PLAY SURFACES. THIS CONTRACT RESPONSIBLE FOR INSTALLING WALKS AND PLAY AREA CURBS, AND OTHER SITE
- IMPROVEMENTS.

 7. CONCRETE FOR SPLASH PAD: EXCAVATE TO 15", ADD 6" TO 8" COMPACTED GRANULAR SAND, CONCRETE SPLASH DECK TO BE 6" MONOLITHIC POUR WITH □4 REBAR 12" O.C., ROUGH BROOM FINISH. THE NO SPLASH/DRY ZONE TO BE 4" TO 6" COMPACTED GRANULAR/SAND, 4" CONCRETE WITH WIRE MESH, ROUGH BROOM
- 8. SPLASH PAD EQUIPMENT BY VORTEX, OR APPROVED EQUAL.
 CONTACT: DAVE OWEN, COMMERCIAL RECREATION SPECIALISTS□
 877-896-8442□DAVE@CRS4REC.COM□WWW.CRS4REC.COM.
- 9. SEATWALLS ARE NOT IN CONTRACT (N.I.C.)10. FIREPITS AND RELATED SEATWALLS AND PAVING ARE NOT IN CONTRACT (N.I.C.)



ROSEVILLE PARKS & RECREATION

2660 CIVIC CENTER DRIVE ROSEVILLE, MINNESOTA 55113



701 Washington Ave. N, Ste 200 | Minneapolis, MN 55401 | 612.338.2029

I HEREBY CERTIFY that this plan, specifica tion or report was prepared by me or under my direct supervision and that I am a duly Licensed Landscape Architect under the laws of the State of Minnesota.

SIGNATURE:

TYPED OR PRINTED NAME: MICHAEL SCHROEDER

DATE: <u>01/21/2014</u> REG. NO.: <u>19664</u>

3	01/21/2014	BID
2	12/20/2013	90% REVIEW SET
1	10/24/2013	50% REVIEW SET
NO	DATE	ISSUED FOR

NO DATE REVISION

PROJECT NAME:
ROSEVILLE PARK
AND RECREATION

COPYRIGHT 2014 BY LHB, INC. ALL RIGHTS RESERVED

RENEWAL PROGRAM
ROSEBROOK PARK
2590 FRY STREET


ROSEVILLE, MINNESOTA 55113


DRAWING TITLE:
SITE PLAN

FILE: ...\130225\600 Drawings\LA\Rosebrook Park\CD SET\130225 Rosebrook_L2.0 DRAWN BY: BMD

CHECKED BY: LAM
PROJ. NO: 130225
DRAWING NO:

RO_I2.0

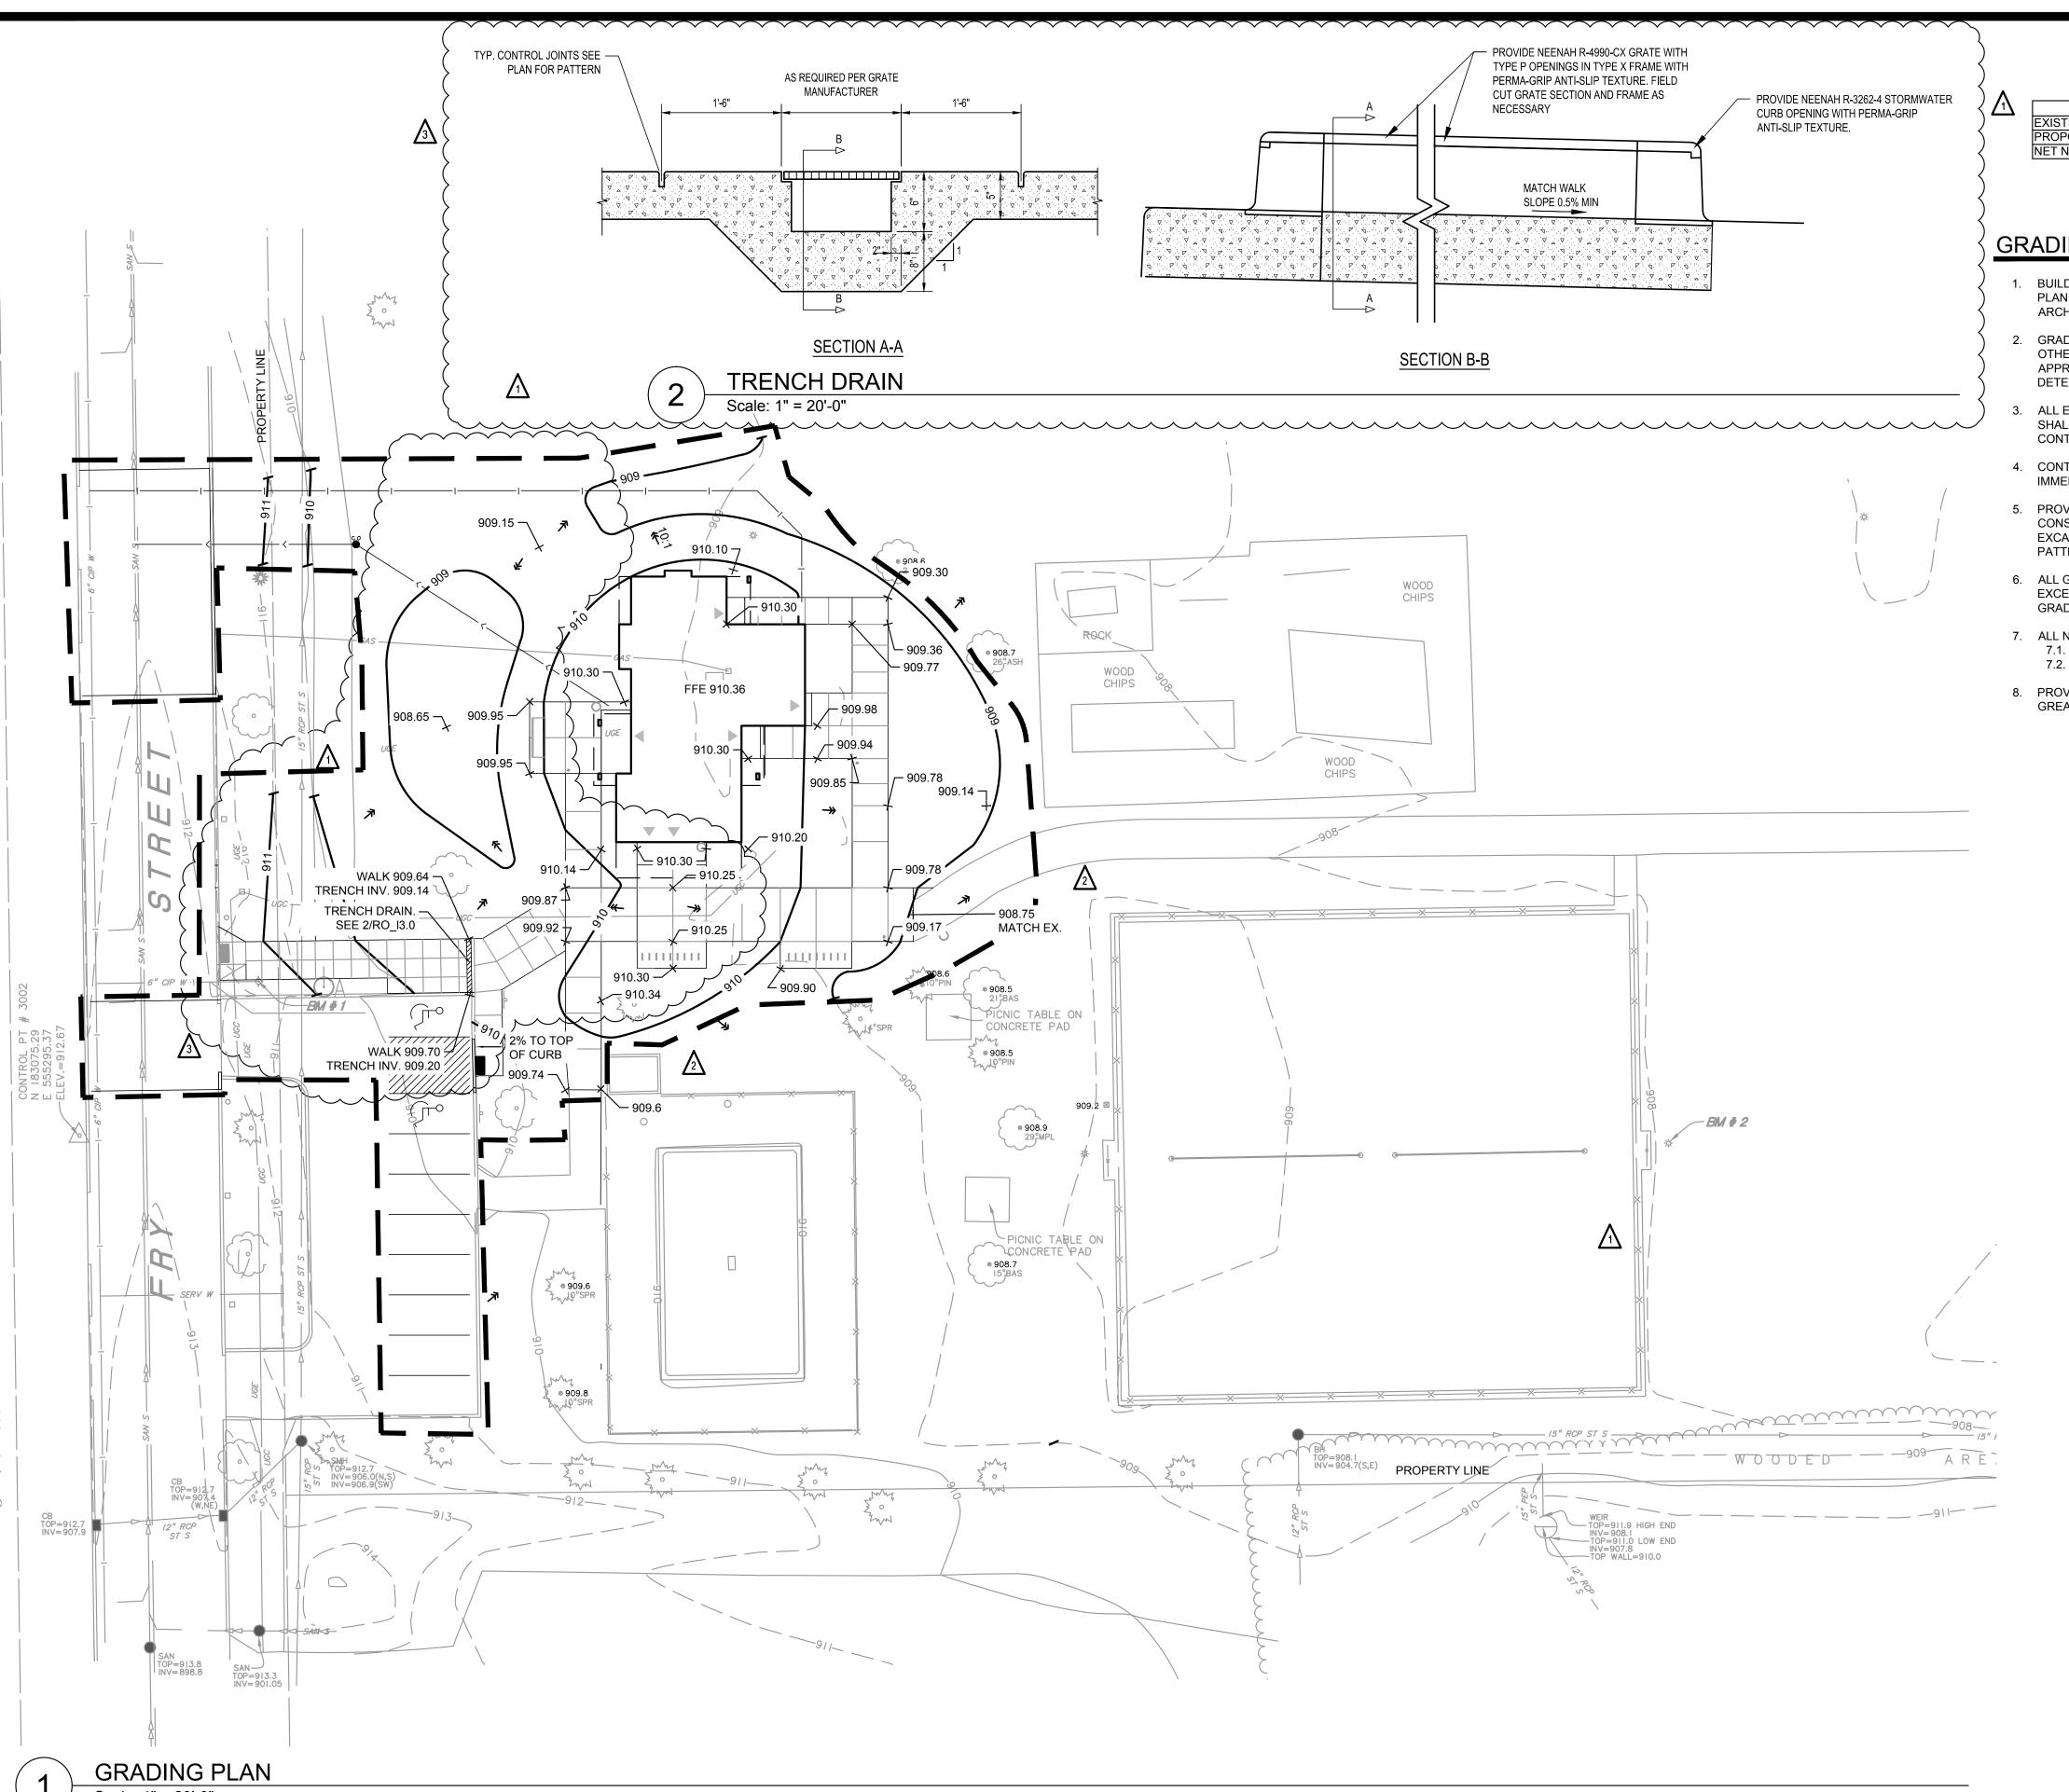

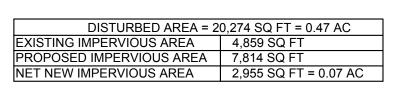

GRADING NOTES

- BUILDING MAIN FLOOR ELEVATION (FFE) SHOWN ON GRADING PLAN CORRESPONDS TO ELEVATION 100'-0" ON ARCHITECTURAL PLAN SHEETS.
- GRADES SHOWN ARE FINISH SURFACE ELEVATIONS UNLESS OTHERWISE NOTED. THE CONTRACTOR SHALL MAKE APPROPRIATE DEDUCTIONS FOR VARYING SURFACES TO DETERMINE SUBGRADE ELEVATIONS.
- 3. ALL EXISTING AND PROPOSED STRUCTURE ACCESS COVERS SHALL BE ADJUSTED TO FINISHED GRADE BY THE CONTRACTOR.
- 4. CONTRACTOR SHALL STOP WORK AND NOTIFY THE OWNER IMMEDIATELY IF CONTAMINANTS ARE SUSPECTED IN THE SOIL.
- 5. PROVIDE POSITIVE DRAINAGE AT ALL TIMES WITHIN THE CONSTRUCTION AREA. DO NOT ALLOW WATER TO POND IN EXCAVATION AREAS AND MAINTAIN ALL EXISTING DRAINAGE PATTERNS.
- 6. ALL GRADES WITHIN THE LANDSCAPED AREA SHALL NOT EXCEED 3 HORIZONTAL TO 1 VERTICAL AND HAVE A MINIMUM GRADE OF 2% UNLESS OTHERWISE NOTED.
- 7. ALL NEW PAVEMENT GRADES SHALL BE AS FOLLOWS: 7.1. CONCRETE PAVEMENT: 1.0% MINIMUM, 5% MAXIMUM 7.2. ASPHALT PAVEMENT: 1.5% MINIMUM, 6% MAXIMUM
- 8. PROVIDE EROSION CONTROL BLANKET ON ALL SLOPES 4:1 OR GREATER.



ROSEVILLE PARKS & RECREATION

2660 CIVIC CENTER DRIVE ROSEVILLE, MINNESOTA 55113



701 Washington Ave. N, Ste 200 | Minneapolis, MN 55401 | 612.338.2029

I HEREBY CERTIFY that this plan, specification or report was prepared by me or under my direct supervision and that I am a duly Licensed Landscape Architect under the laws of the State of Minnesota,

SIGNATURE: TYPED OR PRINTED NAME: LYDIA MAJOR

DATE: <u>04/30/2015</u> REG. NO.: <u>46911</u>

5 07/17/2014 RCWD PERMIT
4 06/10/2014 CONSTRUCTION SET
3 01/21/2014 PROPOSAL
2 12/20/2013 90% REVIEW SET
1 10/24/2013 50% REVIEW SET

ISSUED FOR

_		
$\sqrt{3}$ 0	4/30/2015	ASI 9
2 1	1/18/2014	ASI 6
Λ	07/24/2014	ASI #1
NO	DATE	REVISION

COPYRIGHT 2014 BY LHB, INC. ALL RIGHTS RESERVED.


ROSEVILLE PARK
AND RECREATION
RENEWAL PROGRAM


ROSEBROOK PARK 2590 FRY STREET ROSEVILLE, MINNESOTA 55113

GRADING PLAN

FILE: ..\130225\600 Drawings\LA\Rosebrook Park\CD SET\130225 Rosebrook_L3.0 DRAWN BY: BMD
CHECKED BY: LAM

CHECKED BY: LAM
PROJ. NO: 130225
DRAWING NO: RO

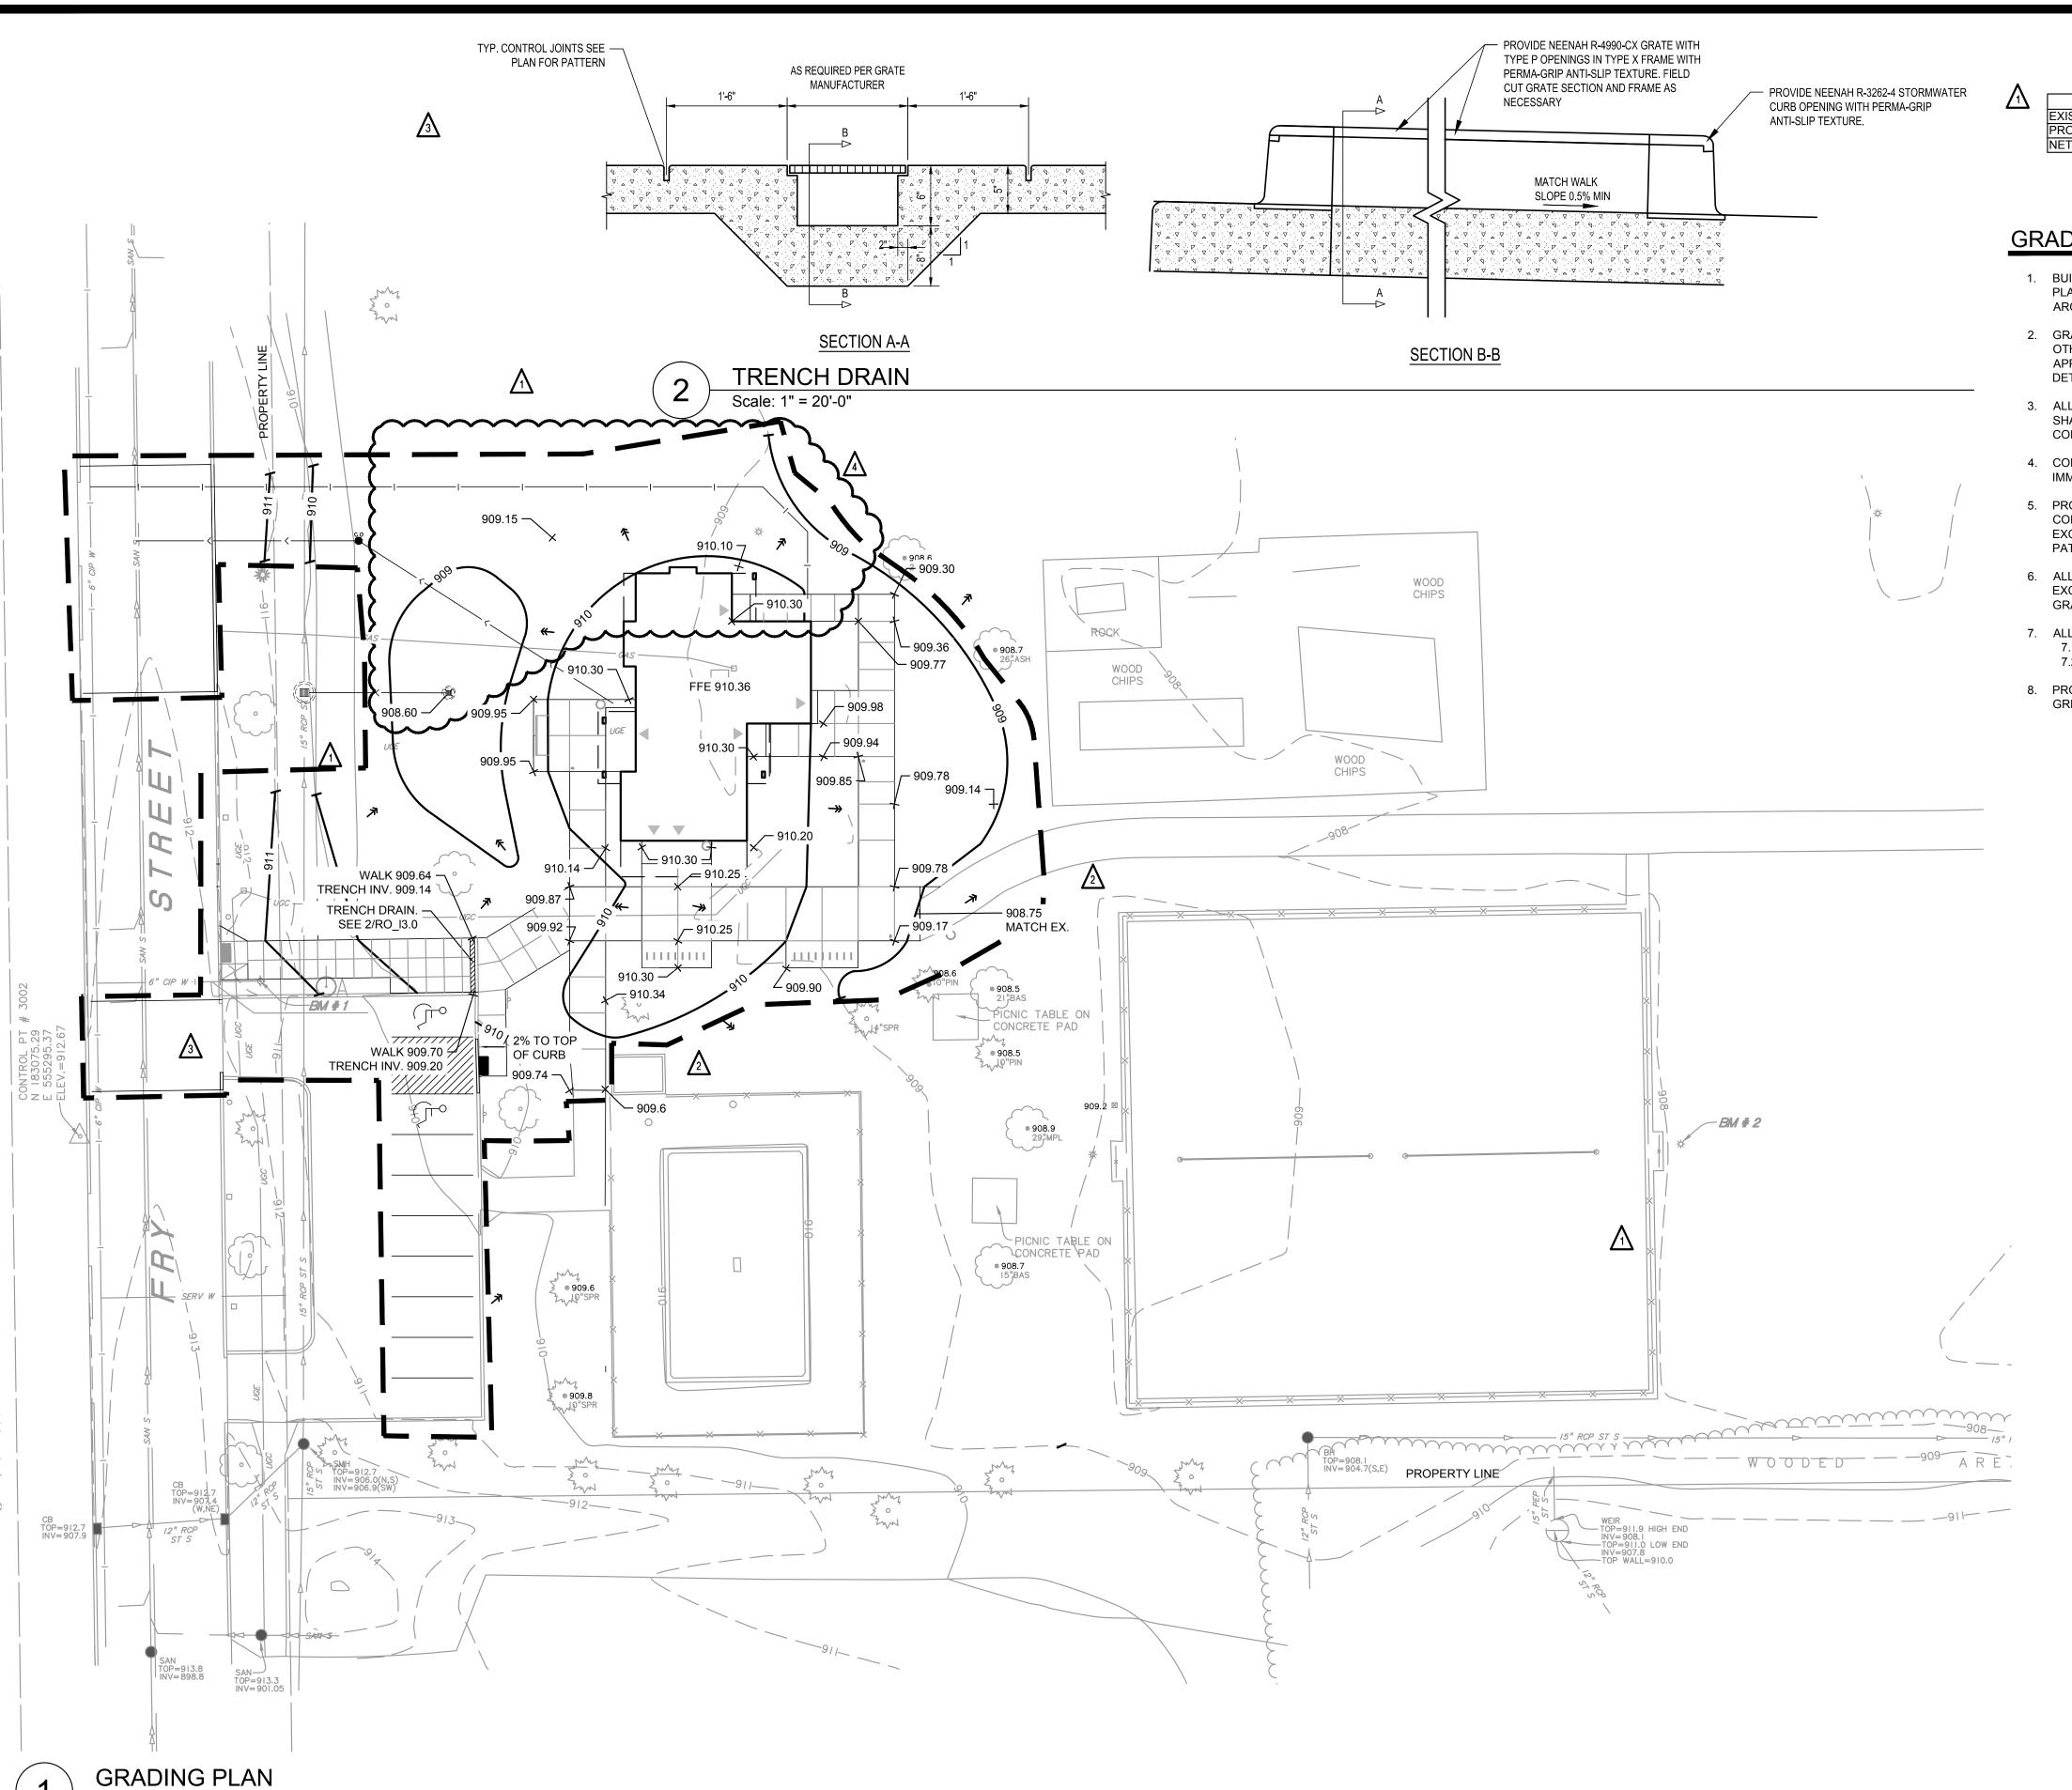

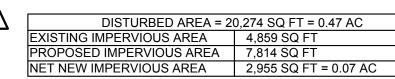

GRADING NOTES

- 1. BUILDING MAIN FLOOR ELEVATION (FFE) SHOWN ON GRADING PLAN CORRESPONDS TO ELEVATION 100'-0" ON ARCHITECTURAL PLAN SHEETS.
- 2. GRADES SHOWN ARE FINISH SURFACE ELEVATIONS UNLESS OTHERWISE NOTED. THE CONTRACTOR SHALL MAKE APPROPRIATE DEDUCTIONS FOR VARYING SURFACES TO DETERMINE SUBGRADE ELEVATIONS.
- 3. ALL EXISTING AND PROPOSED STRUCTURE ACCESS COVERS SHALL BE ADJUSTED TO FINISHED GRADE BY THE CONTRACTOR.
- 4. CONTRACTOR SHALL STOP WORK AND NOTIFY THE OWNER IMMEDIATELY IF CONTAMINANTS ARE SUSPECTED IN THE SOIL.
- 5. PROVIDE POSITIVE DRAINAGE AT ALL TIMES WITHIN THE CONSTRUCTION AREA. DO NOT ALLOW WATER TO POND IN EXCAVATION AREAS AND MAINTAIN ALL EXISTING DRAINAGE PATTERNS.
- 6. ALL GRADES WITHIN THE LANDSCAPED AREA SHALL NOT EXCEED 3 HORIZONTAL TO 1 VERTICAL AND HAVE A MINIMUM GRADE OF 2% UNLESS OTHERWISE NOTED.
- 7. ALL NEW PAVEMENT GRADES SHALL BE AS FOLLOWS: 7.1. CONCRETE PAVEMENT: 1.0% MINIMUM, 5% MAXIMUM 7.2. ASPHALT PAVEMENT: 1.5% MINIMUM, 6% MAXIMUM
- 8. PROVIDE EROSION CONTROL BLANKET ON ALL SLOPES 4:1 OR GREATER.



ROSEVILLE PARKS & RECREATION

2660 CIVIC CENTER DRIVE ROSEVILLE, MINNESOTA 55113



701 Washington Ave. N, Ste 200 | Minneapolis, MN 55401 | 612.338.2029

I HEREBY CERTIFY that this plan, specification or report was prepared by me or under my direct supervision and that I am a duly Licensed Landscape Architect under the laws of the State of Minnesota

SIGNATURE: TYPED OR PRINTED NAME: LYDIA MAJOR

DATE: <u>04/30/2015</u> REG. NO.: <u>46911</u>

5	07/17/2014	RCWD PERMIT
4	06/10/2014	CONSTRUCTION SET
3	01/21/2014	PROPOSAL
2	12/20/2013	90% REVIEW SET
1	10/24/2013	50% REVIEW SET
NO	DATE	ISSUED FOR

05/27/2	.015 ASI	10
3 04/30/2	015 ASI	9
2 11/18/2	.014 ASI	6
07/24/20	014 ASI #1	
NO DATE	REVIS	SION

COPYRIGHT 2014 BY LHB, INC. ALL RIGHTS RESERVED

PROJECT NAME: ROSEVILLE PARK AND RECREATION RENEWAL PROGRAM

ROSEBROOK PARK 2590 FRY STREET ROSEVILLE, MINNESOTA 55113

DRAWING TITLE: **GRADING PLAN**

DRAWN BY: BMD CHECKED BY: LAM

FILE: ...\130225\600 Drawings\LA\Rosebrook Park\CD SET\130225 Rosebrook_L3.0

STORM WATER POLLUTION PREVENTION PLAN (SWPPP) NARRATIVE

GENERAL

THE MINNESOTA POLLUTION CONTROL AGENCY (MPCA) REGULATES STORMWATER DISCHARGES ASSOCIATED WITH CONSTRUCTION ACTIVITY DISTURBING LAND EQUAL TO OR GREATER THAN ONE ACRE THROUGH A GENERAL PERMIT (PERMIT NO. MN R100001) AUTHORIZING THE DISCHARGE OF STORMWATER ASSOCIATED WITH CONSTRUCTION ACTIVITY TO WATERS OF THE STATE IN COMPLIANCE WITH THE CLEAN WATER ACT AND THE NATIONAL POLLUTANT DISCHARGE ELIMINATION SYSTEM/STATE DISPOSAL SYSTEM (NPDES/SDS) PROGRAM. THE GENERAL PERMIT (PERMIT) REQUIRES THE DEVELOPMENT AND IMPLEMENTATION OF A STORM WATER POLLUTION PREVENTION PLAN (SWPPP). THE SWPPP IS A COMBINATION OF NARRATIVE, PLANS SHEETS, AND STANDARD DETAIL SHEETS THAT ADDRESS THE FORESEEABLE CONDITIONS AT ANY STAGE IN THE CONSTRUCTION OR POST-CONSTRUCTION ACTIVITIES.

2. ADMINISTRATIVE REQUIREMENTS

- A. RESPONSIBLE PARTIES: THE OWNER AND GENERAL CONTRACTOR (CONTRACTOR) ARE CO-PERMITTEES OF THE PERMIT AND ARE JOINTLY RESPONSIBLE FOR COMPLIANCE WITH TERMS AND CONDITIONS OF THE PERMIT. OBTAIN A COPY OF THE PERMIT AND COMPLY WITH PARTS II.B, II.C, III.B-F, IV, V, AND APPLICABLE CONSTRUCTION ACTIVITY REQUIREMENTS FOUND IN APPENDIX A. PART C OF THE PERMIT. VERIFY THAT PERMIT REQUIREMENTS ARE SATISFIED AND COMPLETE THE BLANKS ON THIS SWPPP SHEET.
- B. PERMIT APPLICATION: THE CONTRACTOR IS RESPONSIBLE FOR COMPLETING THE PERMIT APPLICATION ON-LINE AND PAYING THE APPLICATION FEE. OWNER AND CONTRACTOR MUST BOTH MUST SIGN THE APPLICATION. OBTAIN A COPY OF THE PERMIT AND APPLY ON-LINE AT THE MPCA CONSTRUCTION STORM WATER WEBSITE: DIED:// DIED. Ca. Date. Died. Date. Date.
- C. PERMIT COVERAGE: PERMIT COVERAGE TYPICALLY BECOMES EFFECTIVE SEVEN (7) CALENDAR DAYS AFTER THE ELECTRONIC SUBMITTAL DATE. DO NOT BEGIN LAND DISTURBING CONSTRUCTION ACTIVITIES UNTIL PERMIT COVERAGE IS EFFECTIVE. THE START OF ANY LAND DISTURBING ACTIVITIES SIGNIFIES THAT THE CONTRACTOR IS ASSUMING RESPONSIBILITY FOR PERMIT COVERAGE AND HAS COMPLIED WITH PERMIT REQUIREMENTS.
- D. NOTIFICATION OF COVERAGE: THE CONTRACTOR WILL RECEIVE A NOTIFICATION OF COVERAGE FROM THE MPCA (E.G., VIA EMAIL, ONLINE NOTIFICATION, OR LETTER). KEEP OR POST A COPY OF THE NOTIFICATION OF COVERAGE WITH THE SWPPP AT THE PROJECT SITE. PROVIDE COPIES TO THE OWNER AND ENGINEER.
- E. CHANGE OF COVERAGE FOR NEW OWNER OR NEW OPERATOR (CONTRACTOR): FOR A NEW OWNER OR OPERATOR, THE CURRENT OWNER AND NEW OWNER OR OPERATOR MUST SUBMIT A PERMIT MODIFICATION FORM PRIOR TO THE NEW OWNER OR OPERATOR COMMENCING CONSTRUCTION ACTIVITY. CONTACT THE MPCA AT 800-657-3864 FOR THIS FORM. THE CURRENT OWNER MUST ALSO SUBMIT A NOTICE OF TERMINATION (NOT) FORM AS NOTED BELOW WHEN THE OWNERSHIP OF THE PROPERTY CHANGES, AS NOTED BELOW.
- F. TERMINATION OF COVERAGE: THE CONTRACTOR IS RESPONSIBLE FOR COORDINATING WITH THE OWNER AND TERMINATING PERMIT COVERAGE BY COMPLETING AND SUBMITTING A NOTICE OF TERMINATION (NOT) FORM TO THE MPCA. A NOTICE OF TERMINATION MUST BE SUBMITTED WITHIN 30 DAYS AFTER FINAL STABILIZATION HAS BEEN ESTABLISHED FOR THE SITE AND CONSTRUCTION ACTIVITY IS COMPLETE, OR WHEN THE OWNER OR OPERATOR CHANGES. COMPLIANCE WITH PERMIT REQUIREMENTS IS REQUIRED UNTIL SUBMISSION OF A NOTICE OF TERMINATION.
- G. RECORD RETENTION: THE CONTRACTOR SHALL KEEP A COPY OF THE SWPPP, INCLUDING ALL CHANGES TO IT, AND INSPECTIONS AND MAINTENANCE RECORDS ON SITE DURING CONSTRUCTION. THIS DOCUMENTATION MUST BE KEPT ON FILE FOR 3 YEARS AFTER SUBMITTAL OF THE NOTICE OF TERMINATION. COORDINATE TRANSFER OF THIS DOCUMENTATION TO THE OWNER AT
- H. CHANGES (AMENDMENTS) TO SWPPP: UPDATE AND DOCUMENT CHANGES TO THE SWPPP AS NECESSARY DURING CONSTRUCTION, AND AS REQUIRED BY THE PERMIT ACCORDING TO PART III.B OF THE PERMIT.

3. CONSTRUCTION ACTIVITY REQUIREMENTS

- A. GENERAL: COMPLY WITH PART IV.A OF THE PERMIT TO IMPLEMENT THE SWPPP AND THE REQUIREMENTS OF THE PERMIT. THE BEST MANAGEMENT PRACTICES (BMPS) IDENTIFIED IN THE SWPPP AND PERMIT MUST BE SELECTED, INSTALLED, AND MAINTAINED IN AN APPROPRIATE AND FUNCTIONAL MANNER IN ACCORDANCE WITH THE CONSTRUCTION DOCUMENTS, MANUFACTURER RECOMMENDATIONS, AND ACCEPTED ENGINEERING PRACTICES.
- B. EROSION PREVENTION PRACTICES: PLAN FOR AND IMPLEMENT CONSTRUCTION PRACTICES TO SATISFY PART IV.B OF THE PERMIT. STABILIZE EXPOSED SOIL AREAS AS SOON AS POSSIBLE, BUT IN NO CASE LATER THAN 14 DAYS AFTER CONSTRUCTION ACTIVITY IN THAT PORTION OF THE SITE HAS TEMPORARILY OR PERMANENTLY CEASED. AMEND SWPPP BY INDICATING THE LOCATION OF AREAS WHERE CONSTRUCTION WILL BE PHASED TO MINIMIZE DURATION OF EXPOSED SOIL AREAS.
- C. SEDIMENT CONTROL PRACTICES: PLAN FOR AND IMPLEMENT CONSTRUCTION PRACTICES THAT MINIMIZE SEDIMENT FROM ENTERING SURFACE WATERS, INCLUDING BUT NOT LIMITED TO, CURB AND GUTTER SYSTEMS AND STORM SEWER INLETS TO SATISFY PART IV.C OF THE PERMIT. PROVIDE TEMPORARY SEDIMENTATION BASINS WHERE 10 OR MORE ACRES OF DISTURBED SOIL DRAIN TO A COMMON LOCATION AS APPROVED BY LHB (SEE PART III.C OF THE PERMIT FOR BASIN REQUIREMENTS). IF TEMPORARY SEDIMENTATION BASINS ARE INFEASIBLE, DOCUMENT THIS DETERMINATION AND THE SUBSTITUTE BMPS IN THE
- D. DEWATERING AND BASIN DRAINING: COMPLY WITH PART IV.D OF THE PERMIT. ENSURE THAT ALL WATER FROM DEWATERING OR BASIN DRAINING ACTIVITIES IS DISCHARGED IN A MANNER THAT DOES NOT CAUSE NUISANCE CONDITIONS, EROSION IN RECEIVING CHANNELS OR DOWNSLOPE PROPERTIES, OR INUNDATION IN WETLANDS CAUSING SIGNIFICANT ADVERSE IMPACTS TO THE WETLANDS. ANY TURBID OR SEDIMENT LADEN DISCHARGE WATER MUST BE ADEQUATELY TREATED BY DISCHARGING TO A SEDIMENTATION BASIN WHENEVER FEASIBLE, OR TREATED WITH APPROPRIATE BMPS IF THE WATER CANNOT BE DISCHARGED TO A SEDIMENT BASIN. THE CONTRACTOR MUST VISUALLY CHECK THE TREATED STORMWATER PRIOR TO DISCHARGING TO RECEIVING WATERS TO ENSURE ADEQUATE TREATMENT IS BEING MET AND THAT THE DISCHARGE POINTS ARE ADEQUATEL' PROTECTED FROM EROSION AND SCOUR. BACKWASH WATER FROM FILTRATION MUST BE INCORPORATED INTO THE SITE IN A NON-EROSIVE MANNER, OR DISCHARGED TO THE SANITARY SEWER WITH PERMISSION FROM THE SANITARY SEWER AUTHORITY
- E. INSPECTIONS AND MAINTENANCE: COMPLY WITH PART IV.E OF THE PERMIT.
- F. POLLUTION PREVENTION MANAGEMENT MEASURES: COMPLY WITH PART IV.F OF THE PERMIT. NOTE, PREPARE AND INCLUDE A FUELING OPERATION PLAN AND EMERGENCY SPILL PLAN WITH THE SWPPP AS REQUIRED BY THIS PART. AMEND SWPPP BY INDICATING THE LOCATION OF POTENTIAL POLLUTANT GENERATING ACTIVITIES ON SITE MAPS.
- G. FINAL STABILIZATION: ESTABLISH FINAL STABILIZATION FOR THE SITE AS DESCRIBED IN PART IV.G OF THE PERMIT. SPECIFIC CONDITIONS REQUIRED FOR FINAL STABILIZATION INCLUDE:
- 1) SOIL DISTURBING ACTIVITIES AT THE SITE HAVE BEEN COMPLETED AND SOILS ARE STABILIZED BY A UNIFORM PERENNIAL VEGETATIVE COVER WITH A DENSITY OF 70% OVER THE ENTIRE PERVIOUS SURFACE AREA, OR OTHER EQUIVALENT MEANS NECESSARY TO PREVENT SOIL FAILURE UNDER EROSIVE CONDITIONS.
- 2) PERMANENT STORMWATER MANAGEMENT SYSTEMS ARE OPERATIONAL AND SEDIMENT IS REMOVED FROM TEMPORARY AND PERMANENT SEDIMENTATION BASINS AND CONVEYANCE SYSTEMS, AND DITCHES ARE STABILIZED WITH FINAL COVER.
- 3) ALL TEMPORARY SYNTHETIC AND STRUCTURAL EROSION PREVENTION AND SEDIMENT CONTROL BMPS ARE REMOVED. BMPS DESIGNED TO DECOMPOSE MAY BE LEFT IN PLACE.
- 4) FOR RESIDENTIAL CONSTRUCTION, THE STUCTURE(S) ARE FINISHED, TEMPORARY EROSION PROTECTION AND PERIMETER CONTROL IS COMPLETED, AND THE RESIDENCE SOLD TO THE HOMEOWNER WHO HAS BEEN GIVEN THE MPCA'S "HOMEOWNER FACT SHEET" REGARDING THE NEED FOR PERMANENT COVER.
- 5) DISTURBED AGRICULTURAL LAND IS RETURNED TO ITS PRECONSTRUCTION AGRICULTURAL USE.
- 4. SWPPP RESPONSIBILITIES (THE OWNER IS RESPONSIBLE FOR PREPARING AND AMENDING THE SWPPP).
- A. ON BEHALF OF THE OWNER, THE FOLLOWING PERSON PREPARED THE SWPPP AND IS TRAINED IN SWPPP DESIGN:

MAIA HAROLD / LHB, INC.

TRAINING DATE/INSTRUCTOR: CERTIFICATION 6/1/13 (EXPIRES 5/31/16)/SHRI RAMASWAMY, UMN

TRAINING CONTENT/HOURS: DESIGN OF CONSTRUCTION SWPPP

B. ON BEHALF OF THE OWNER, THE CONTRACTOR WILL OVERSEE SWPPP IMPLEMENTATION, REVISE AND AMEND THE SWPPP, PERFORM INSPECTIONS, AND SUPERVISE THE INSTALLATION, MAINTENANCE AND REPAIR OF BMPS BEFORE AND DURING CONSTRUCTION. THE FOLLOWING CONTRACTOR REPRESENTATIVE IS TRAINED TO PERFORM THESE DUTIES AND WILL ASSUME THESE RESPONSIBILITIES: NAME:

TRAINING DATE/INSTRUCTOR:

TRAINING CONTENT/HOURS:

C. THE OWNER IS RESPONSIBLE FOR THE LONG-TERM OPERATION AND MAINTENANCE OF THE PERMANENT STORMWATER MANAGEMENT SYSTEM. THE FOLLOWING PERSON IS DESIGNATED TO PERFORM THESE DUTIES:

MAINTENANCE PLAN: REFERENCE STORMWATER REPORT BY LHB DATED MONTH DAY, YEAR.

D. CHAIN OF RESPONSIBILITY: THE GENERAL CONTRACTOR IS IN CHARGE OF ALL SWPPP IMPLEMENTATION ON THE CONSTRUCTION SITE AND IS ACCOUNTABLE FOR SUBCONTRACTORS AND OTHER CONTRACTORS WORKING ON SITE AND THEIR COMPLIANCE WITH GENERAL STORMWATER PERMIT AND SWPPP REQUIREMENTS. NOTIFY THE OWNER OF ANY AMENDMENT NEEDED TO THE SWPPP.

- 5. REGULATORY AGENCIES AND PERMITS
- A. COMPLY WITH REQUIREMENTS OF ALL REGULATORY AGENCIES AND PERMITS HAVING JURISDICTION DURING CONSTRUCTION ACTIVITIES. THE FOLLOWING ADDITIONAL REGULATORS AND PERMITS ARE KNOWN TO HAVE SITE JURISDICTION:
- 1) CITY OF ROSEVILLE
- 2) RICE CREEK WATERSHED DISTRICT
- 6. DESCRIPTION OF THE CONSTRUCTION ACTIVITY / SWPPP COMPONENTS

A. NARRATIVE:

- 1) PROJECT SUMMARY: THE PROJECT INVOLVES THE REDEVELOPMENT OF THE EXISTING PARK. SPECIFIC WORK INCLUDES: a. DEMOLITION OF BITUMINOUS PATH, CONCRETE SLABS, LANDSCAPING, PARKING LOT STRIPING, AND ABOVEGROUND
- PORTIONS OF AN EXISTING BUILDING.
- □ DEWATERING ACTIVITIES.
- c. BITUMINOUS PARKING LOT STRIPING, CONCRETE WALK AND PADS, AND LANDSCAPING CONSTRUCTION.
- d. BIOFILTRATION BASINS, STORM SEWER, AND RELATED FACILITY CONSTRUCTION.
- e. WATER AND SANITARY SEWER UTILITY CONSTRUCTION.
- BUILDING CONSTRUCTION.
- 2) TIMING FOR INSTALLATION OF EROSION

 SEDIMENTATION BMPS AND PERMANENT STORMWATER MANAGEMENT SYSTEMS, IN GENERAL SEQUENTIAL ORDER FROM FIRST TO LAST:
- a. INLET PROTECTION FOR EXISTING INLETS / SILT FENCE / DELINATION AREAS NOT TO BE DISTURBED / ROCK CONSTRUCTION ENTRANCE / TEMPORARY SEDIMENTATION BASIN: PROVIDE PRIOR TO CONSTRUCTION MAINTAIN DURING CONSTRUCTION.
- □ SILT FENCE AROUND STOCKPILES: DURING CONSTRUCTION. c. PORTABLE SEDIMENT CONTAINMENT SYSTEMS FOR TREATING WATER FROM DEWATERING OPERATIONS: PROVIDE DURING
- CONSTRUCTION. d. INLET PROTECTION FOR NEW INLETS: AS CONSTRUCTED.
- e. BIOFILTRATION BASINS
- ☐ HARD SURFACING (E.G., BUILDING ROOFS, PAVEMENTS)
- □ VEGETATIVE COVER / EROSION CONTROL BLANKETS: <u>AFTER FINAL TOPSOIL PLACEMENT AND FINISH GRADING</u>
- ☐ REMOVAL OF TEMPORARY BMPS: <u>AFTER FINAL STABILIZATION IS ESTABLISHED.</u>



- 2 3) IMPERVIOUS SURFACE AREAS / WATER QUALITY VOLUME:
 - a. PRE-CONSTRUCTION IMPERVIOUS: 0.14 ACRES
 - ☐ POST CONSTRUCTION IMPERVIOUS: 0.19 ACRES
 - c. NET NEW IMPERVIOUS: 0.05 ACRES
- d. WATER QUALITY VOLUME REQUIRED: 1145 CUBIC FEET
- e. REASON WATER QUALITY VOLUME CANNOT BE INFILTRATED (PER PART III.D.1 .): THE SITE IS LOCATED ON AN AREA OF PREDOMINATELY HYDRAULIC SOIL GROUP D SOILS.
- □ ACTUAL WATER QUALITY VOLUME RETAINED ON-SITE / METHOD OF RETENTION: 4238 CUBIC FEET / BIOFILTRATION
- □ REMAINDER OF WATER QUALITY VOLUME AND ALTERNATIVE TREATMENT METHOD: NA
- 4) CHEMICAL TREATMENT SYSTEMS FOR ENHANCING THE ON-SITE SEDIMENTATION PROCESS AND HOW COMPLIANCE WILL BE ACHIEVED PER PART IV.C.10 OF THE PERMIT: NA
- 5) DOCUMENTATION OF INFEASIBILITY FOR OBTAINING RIGHT-OF-WAY FOR PERMANENT STORMWATER MANAGEMENT SYSTEMS:
- 6) STORMWATER POLLUTION MITIGATION MEASURES IDENTIFIED IN ENVIRONMENTAL REVIEW OR OTHER REQUIRED REVIEW: REFERENCE STORMWATER REPORT BY LHB DATED MONTH DAY, YEAR.
- 7) MEASURES TO ASSURE COMPLIANCE WITH SURFACE AND GROUNDWATER STANDARDS IN KARST AREAS: NA

- 1) SWPPP: THIS SHEET, INCLUDING DOCUMENTATION DESCRIBED AND REFERENCED HEREIN.
- 2) TEMPORARY BMPS / QUANTITIES / LOCATIONS OF AREAS NOT TO BE DISTURBED / SOIL TYPES: SEE SHEETS GN_I10.7, RO_I1.0
- 3) PERMANENT BMPS: SEE SHEET RO 13.0
- 4) EXISTING GRADES, DRAINAGE PATTERNS, AREAS OF STEEP SLOPES: SEE SHEET RO_I1.0
- 5) FINAL GRADES, DRAINAGE PATTERNS, AREAS OF STEEP SLOPES: SEE SHEET RO_I3.0
- 6) IMPERVIOUS SURFACING / METHODS OF FINAL STABILIZATION: SEE SHEETS RO_I2.0, RO_I2.1, RO_I4.0 7) IDENTIFICATION OF SURFACE WATERS AND WETLANDS WITHIN 1 MILE OF SITE THAT RECEIVE RUNOFF FROM SITE: SEE SHEET
- 8) FOR THE ABOVE SURFACE WATERS, IDENTIFICATION OF SPECIAL OR IMPAIRED WATERS, INCLUDING ENVIRONMENTAL
- PROTECTION AGENCY (EPA) APPROVED TOTAL MAXIMUM DAILY LOAD (TMDL) AND WASTE LOAD ALLOCATION (WLA) FOR POLLUTANTS OR STESSORS IDENTIFIED IN APPENDIX A, PART B.10 OF THE PERMIT: SEE SHEET RO 12.0 9) FOR THE ABOVE SPECIAL OR IMPAIRED WATERS, DOCUMENTATION OF BMPS USED TO ADDRESS TMDL OR WLA REQUIREMENTS
- TO COMPLY WITH APPENDIX A OF THE PERMIT: SEE SHEET RO_I3.0
- 10)CONSTRUCTION AREAS THAT ARE ADJACENT TO AND DRAIN TO MINNESOTA DEPARTMENT OF NATURAL RESOURCES (MDNR) PUBLIC WATERS PROMULGATED AS "WORK IN WATER RESTRICTIONS" DURING SPECIFIED FISH SPAWNING TIMES: NA 11)TOPSOIL PRESERVATION AREAS: NA
- 12)INFILTRATION AREAS TO BE PROTECTED FROM EXCESSIVE SOIL COMPACTION AND SEDIMENTATION / METHODS OF PROTECTION: NA
- C. STANDARD DETAIL SHEETS: GN_I10.7, GN_I10.8
- D. MAINTENANCE PLAN: CONTAINED IN STORMWATER REPORT BY LHB DATED MONTH DAY, YEAR.
- 7. STANDARDS SPECIFICATIONS FOR CONSTRUCTION:
- UNLESS OTHERWISE NOTED IN CONTRACT DOCUMENTS, ALL MATERIAL AND CONSTRUCTION REQUIREMENTS FOR TEMPORARY SEDIMENT CONTROL AND EROSION PREVENTION SHALL BE IN ACCORDANCE WITH THE MINNESOTA DEPARTMENT OF TRANSPORTATION STANDARD SPECIFICATIONS FOR CONSTRUCTION, CURRENT EDITION.



ROSEVILLE PARKS & RECREATION

2660 CIVIC CENTER DRIVE ROSEVILLE, MINNESOTA 55113



701 Washington Ave. N, Ste 200 | Minneapolis, MN 55401 | 612.338.2029

I HEREBY CERTIFY that this plan, specification or report was prepared by me or under my direct supervision and that I am a duly Licensed Professional Engineer under the laws of the State of Minnesota

TYPED OR PRINTED NAME: MELISSA M. WHIT DATE: 06/06/2014 REG. NO.: 46192

2 12/20/2013 90% REVIEW SET 10/24/2013 50% REVIEW SET	2 12/20/2013 90% REVIEW SET 10/24/2013 50% REVIEW SET	3 01/21/2014 PROPOSAL	
10/24/2013 50% REVIEW SET	10/24/2013 50% REVIEW SET		
		2 12/20/2013 90% REVIEW SET	
O DATE ISSUED FOR	O DATE ISSUED FOR	1 10/24/2013 50% REVIEW SET	
		O DATE ISSUED FOR	

DATE

ADDENDUM 4

ADDENDUM 1

REVISION

COPYRIGHT 2014 BY LHB, INC. ALL RIGHTS RESERVED PROJECT NAME:

06/04/2014

ROSEVILLE PARK AND RECREATION RENEWAL PROGRAM


ROSEBROOK PARK 2590 FRY STREET ROSEVILLE, MINNESOTA 55113

DRAWING TITLE: STORMWATER POLLUTION PREVENTION PLAN

...12\projects\13Proj\130225\600 Drawings\LA\Rosebrook Park\CD SET\130225 DRAWN BY: MRH

CHECKED BY: MJW



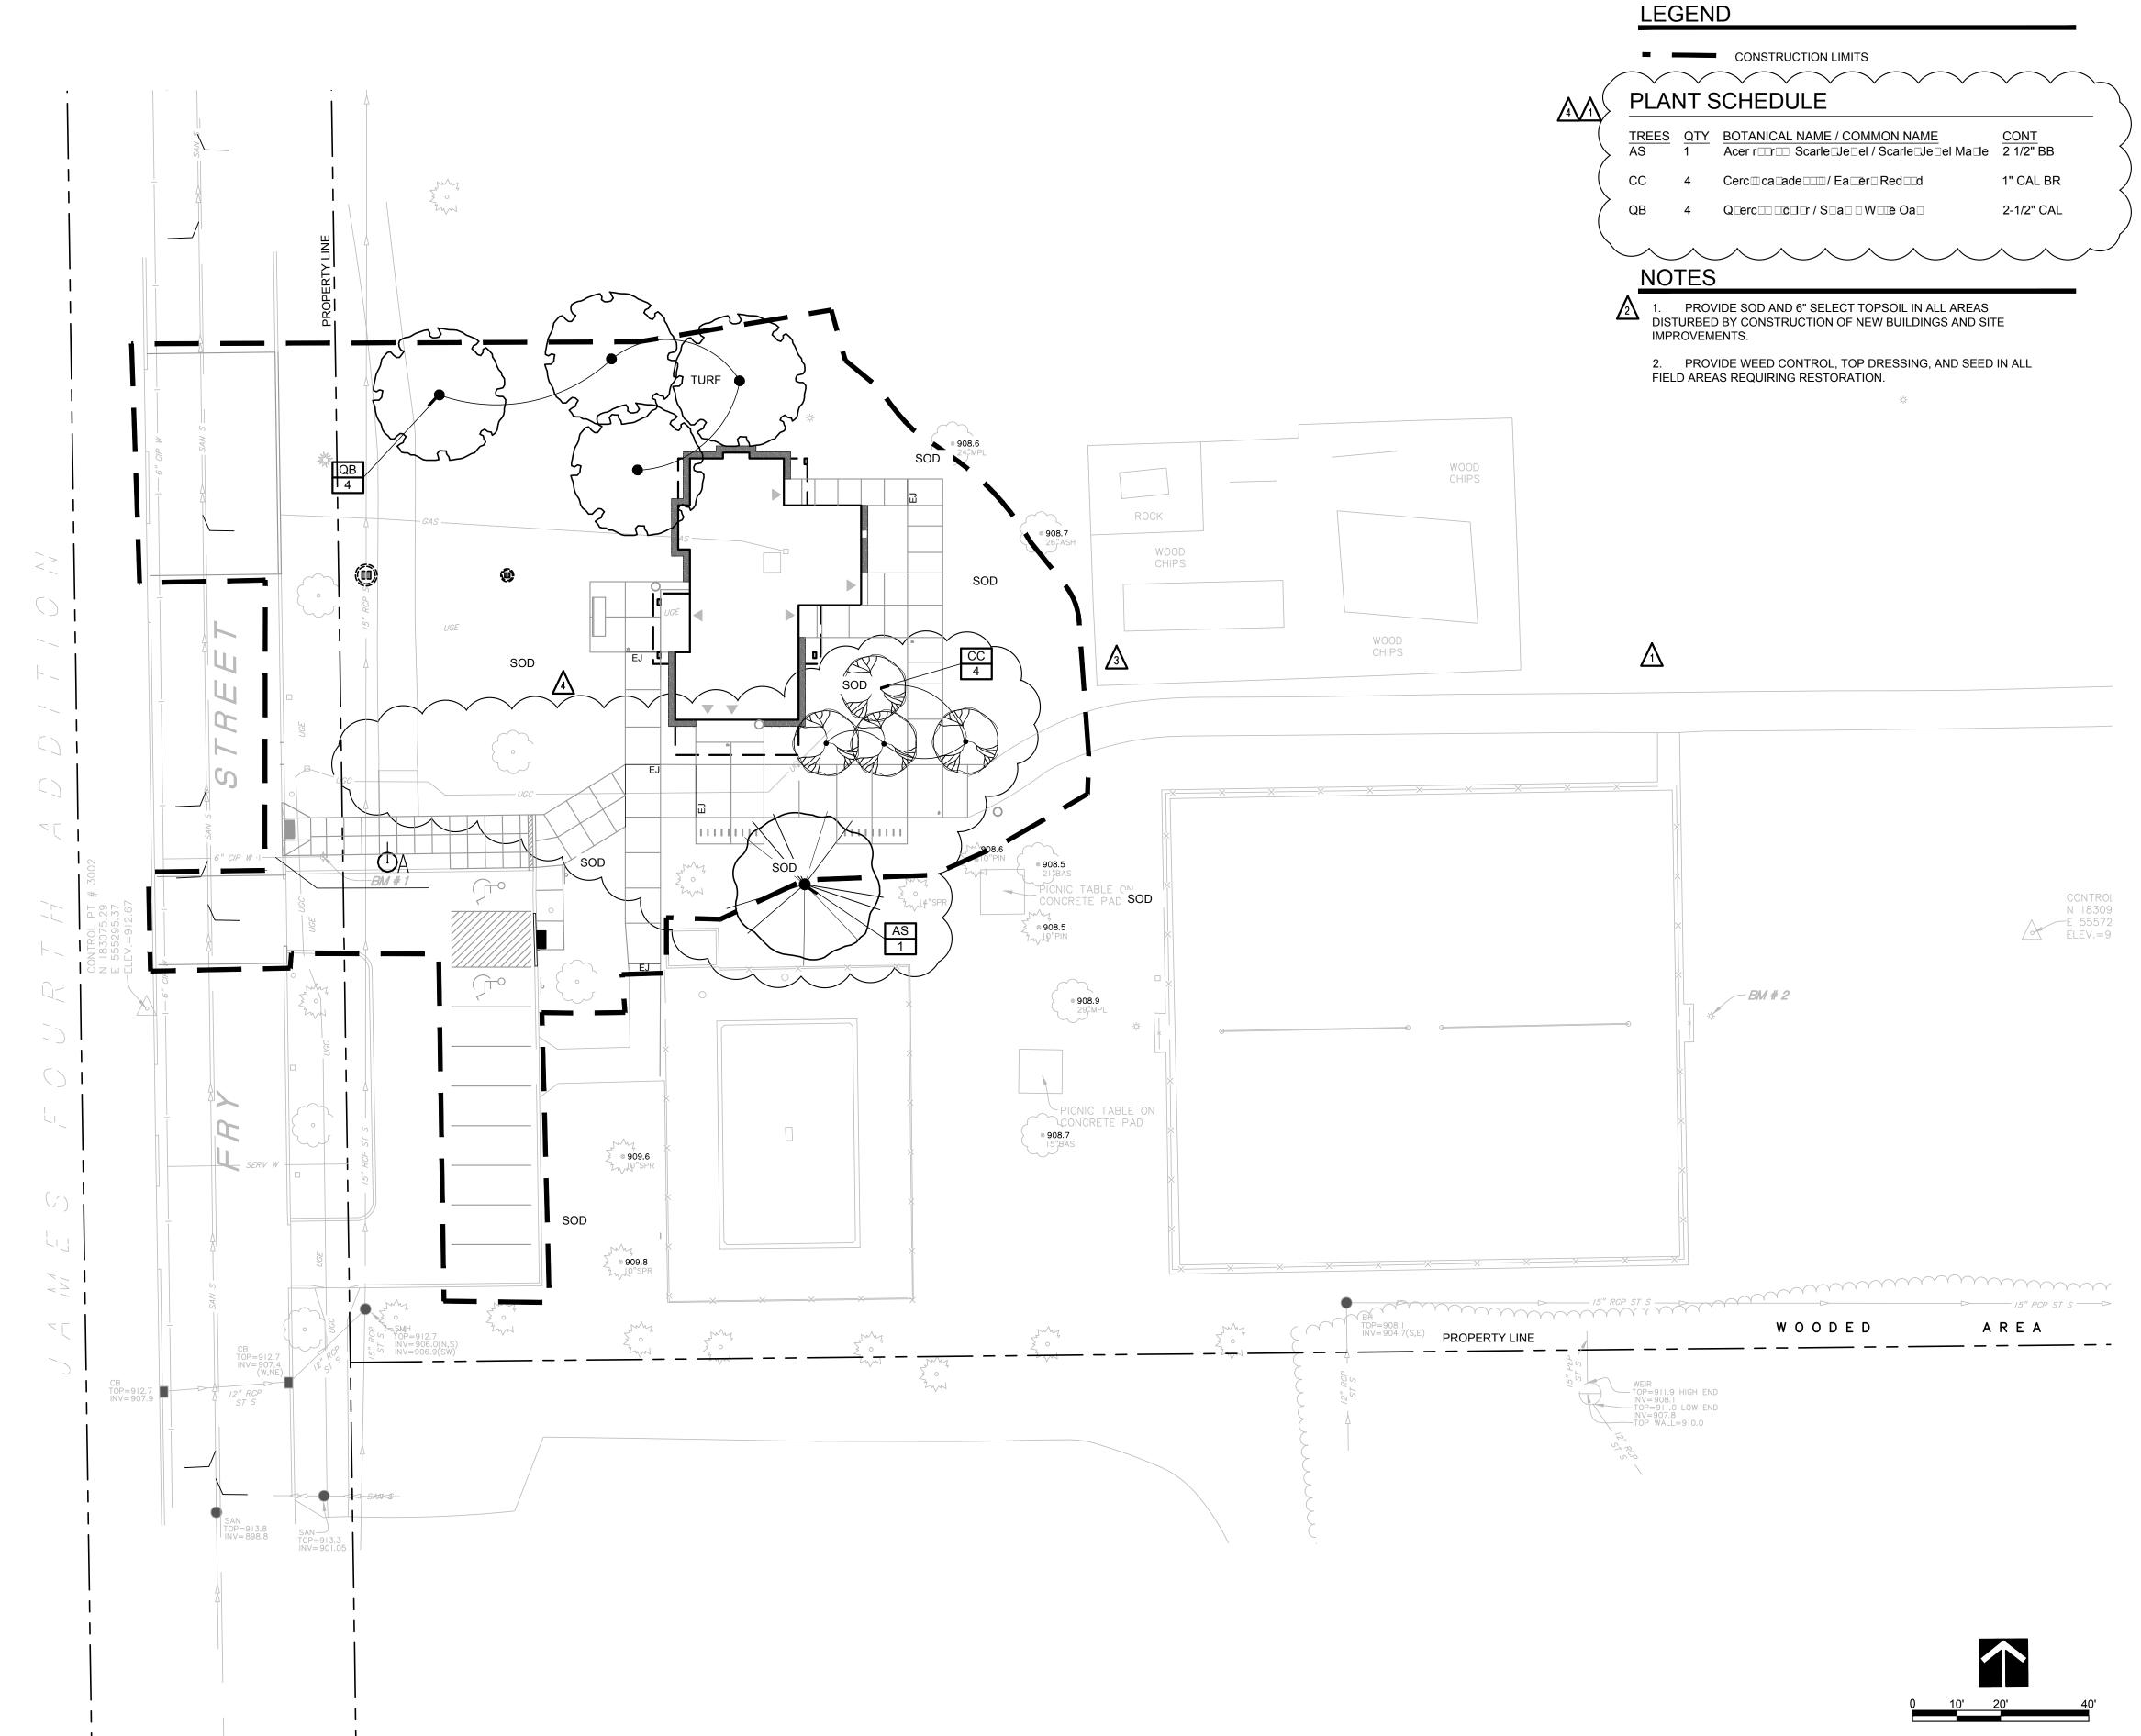



2660 CIVIC CENTER DRIVE ROSEVILLE, MINNESOTA 55113



701 Washington Ave. N, Ste 200 | Minneapolis, MN 55401 | 612.338.2029

I HEREBY CERTIFY that this plan, specifica tion or report was prepared by me or under my direct supervision and that I am a duly Licensed Landscape Architect under the laws of the State of Minnesota

SIGNATURE:

TYPED OR PRINTED NAME: LYDIA MAJOR

DATE: <u>04/30/2015</u> REG. NO.: <u>46911</u>

5	07/17/2014	RCWD PERMIT	
4	06/10/2014	CONSTRUCTION SET	
3	01/21/2014	PROPOSAL	
2	12/20/2013	90% REVIEW SET	
1	10/24/2013	50% REVIEW SET	
NO	DATE	ISSUED FOR	

4 05/27/2015 ASI 10 3 11/18/2014 ASI 6 2 08/29/2014 ASI 2 1 07/24/2014 ASI 1 NO DATE REVISION

COPYRIGHT 2014 BY LHB, INC. ALL RIGHTS RESERVED.

ROSEVILLE PARK
AND RECREATION
RENEWAL PROGRAM

ROSEBROOK PARK 2590 FRY STREET ROSEVILLE, MINNESOTA 55113


DRAWING TITLE:
PLANTING PLAN

FILE: ...\130225\600 Drawings\LA\Rosebrook Park\CD SET\130225 Rosebrook_L4.0

DRAWN BY: BMD

CHECKED BY: LAM

CHECKED BY: LAM
PROJ. NO: 130225
DRAWING NO: ROUTE ROU

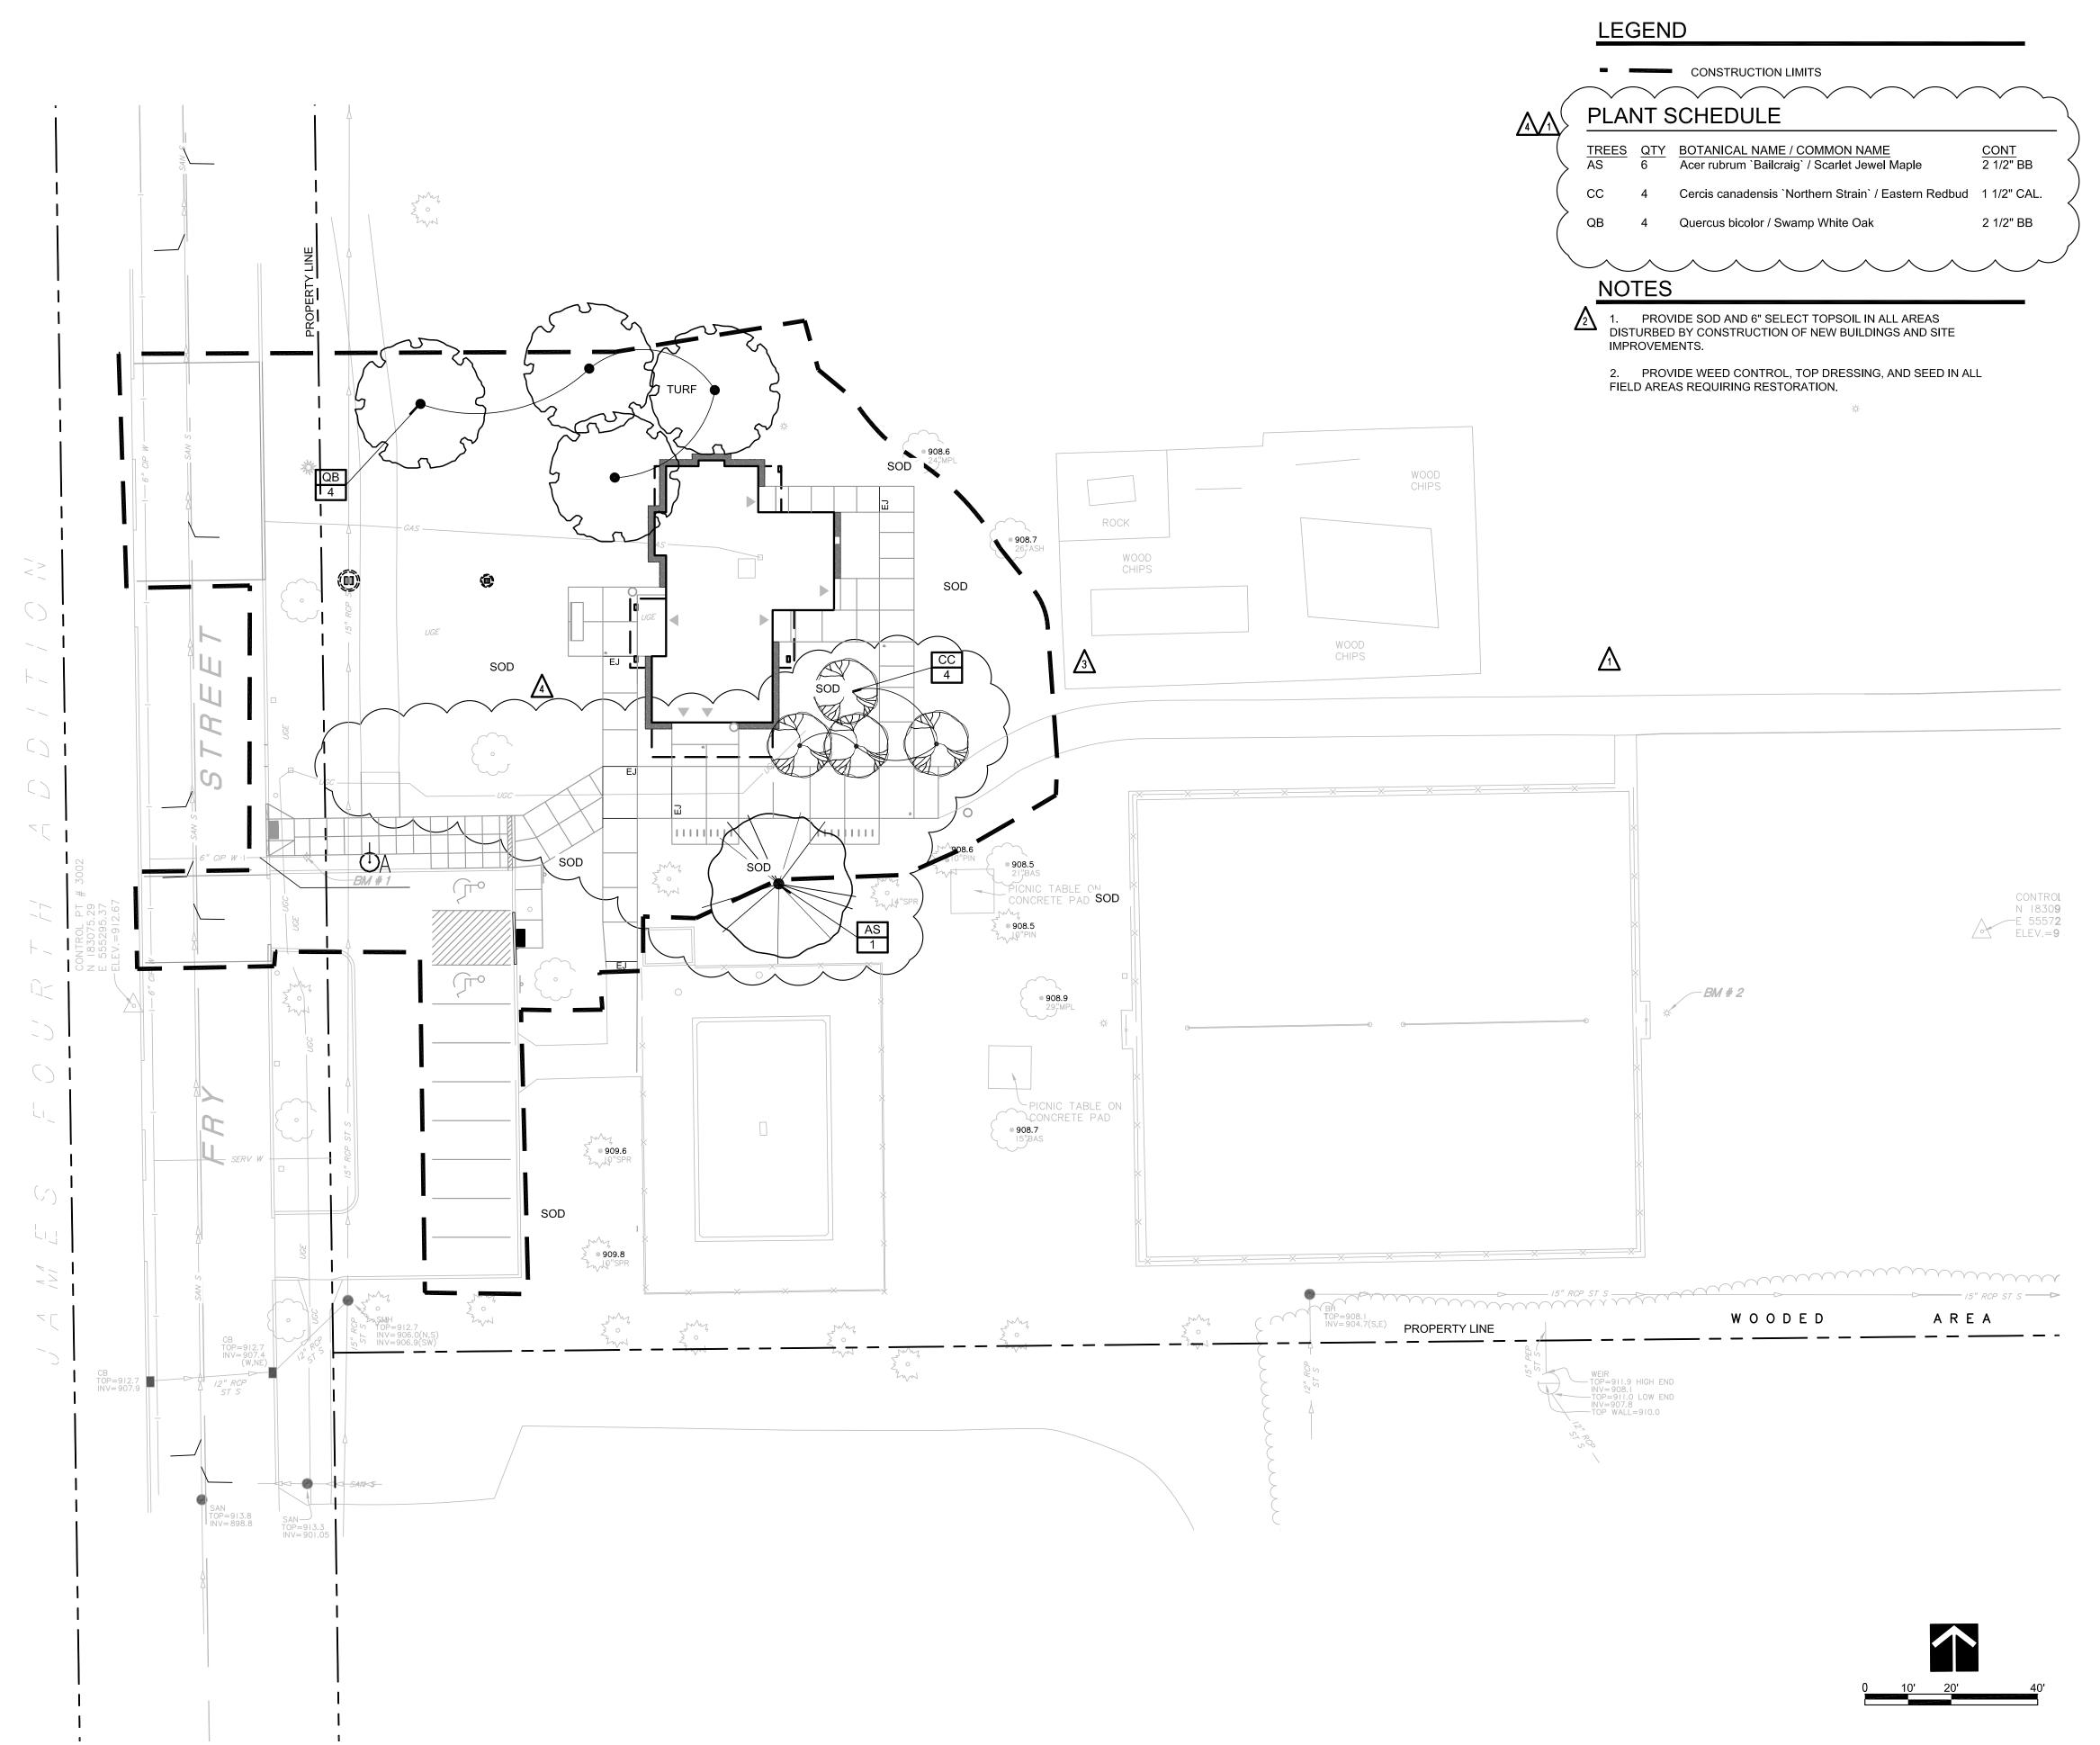



2660 CIVIC CENTER DRIVE ROSEVILLE, MINNESOTA 55113



701 Washington Ave. N, Ste 200 | Minneapolis, MN 55401 | 612.338.2029

I HEREBY CERTIFY that this plan, specification or report was prepared by me or under my direct supervision and that I am a duly Licensed Landscape Architect under the laws of the State of Minnesota,

SIGNATURE:

TYPED OR PRINTED NAME: LYDIA MAJOR

DATE: <u>04/30/2015</u> REG. NO.: <u>46911</u>

5	07/17/2014	RCWD PERMIT	
4	06/10/2014	CONSTRUCTION SET	
3	01/21/2014	PROPOSAL	
2	12/20/2013	90% REVIEW SET	
1	10/24/2013	50% REVIEW SET	
NO	DATE	ISSUED FOR	

4 05/27/2015 ASI 10 3 11/18/2014 ASI 6 2 08/29/2014 ASI 2 07/24/2014 ASI 1 NO DATE REVISIC REVISION

COPYRIGHT 2014 BY LHB, INC. ALL RIGHTS RESERVED


PROJECT NAME: ROSEVILLE PARK AND RECREATION RENEWAL PROGRAM

ROSEBROOK PARK 2590 FRY STREET ROSEVILLE, MINNESOTA 55113

DRAWING TITLE:
PLANTING PLAN

DRAWING NO:

FILE: ..\130225\600 Drawings\LA\Rosebrook Park\CD SET\130225 Rosebrook_L4. DRAWN BY: BMD CHECKED BY: LAM PROJ. NO: 130225

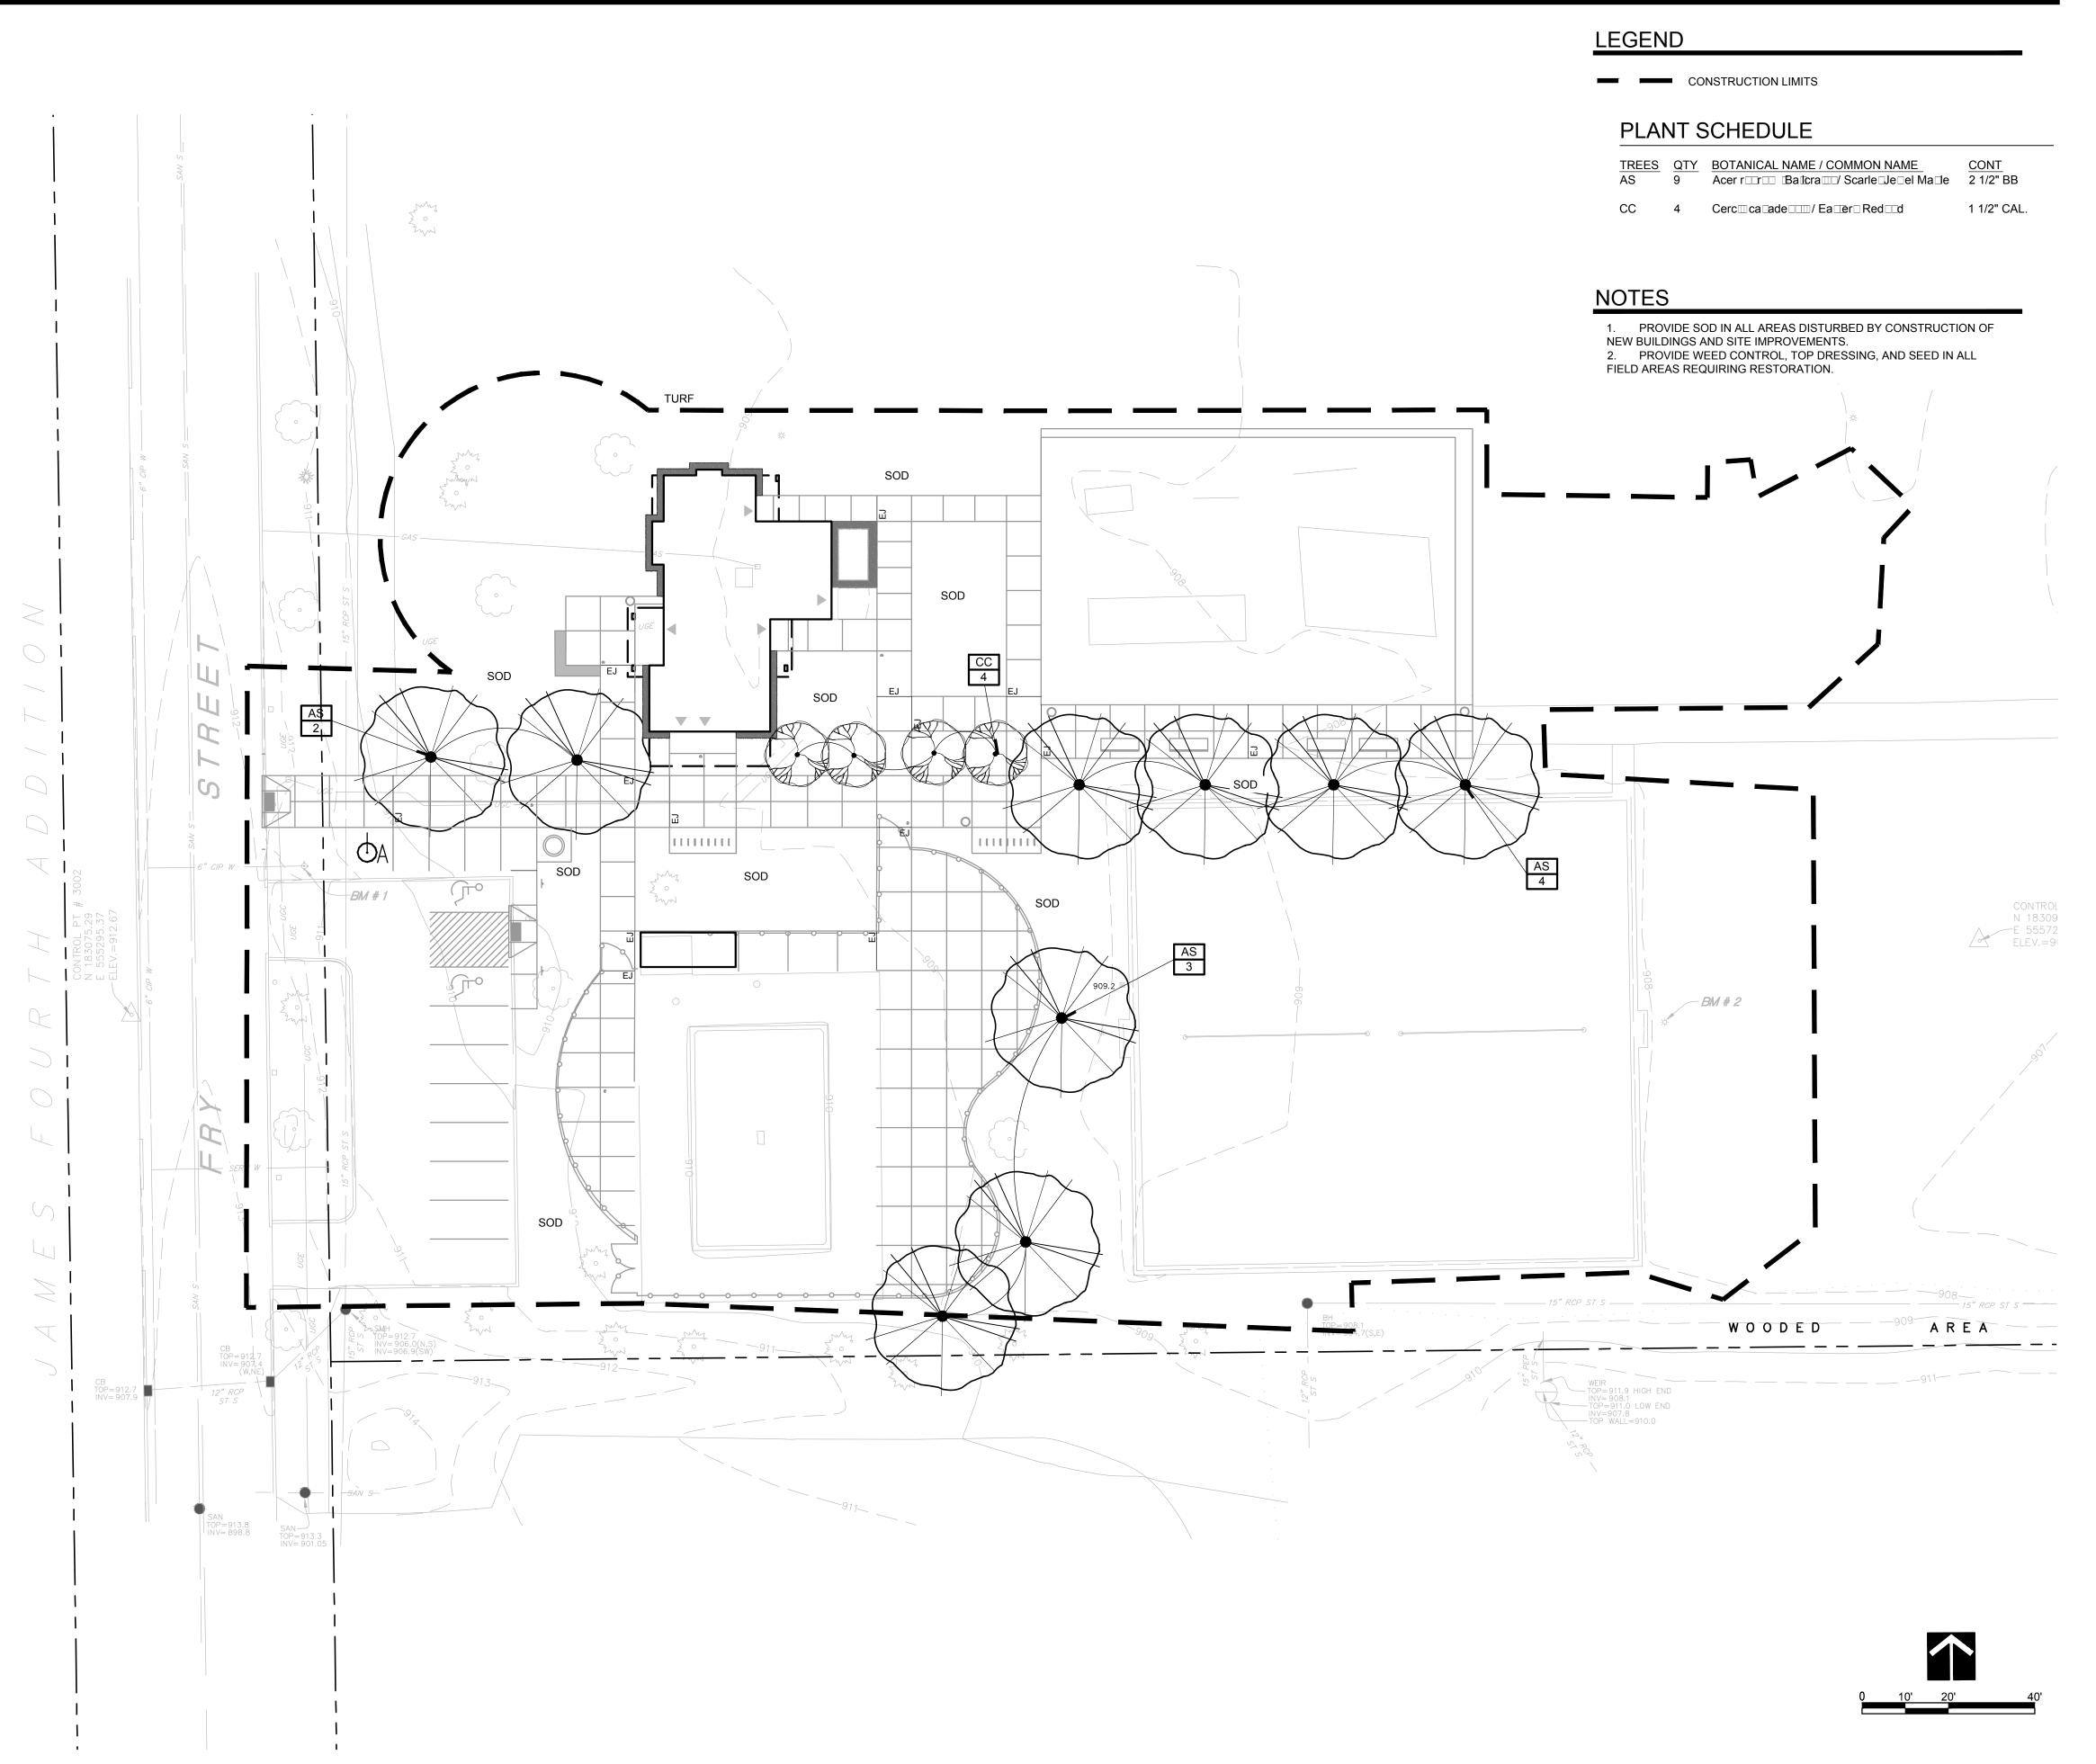



2660 CIVIC CENTER DRIVE ROSEVILLE, MINNESOTA 55113



701 Washington Ave. N, Ste 200 | Minneapolis, MN 55401 | 612.338.2029

I HEREBY CERTIFY that this plan, specifica—tion or report was prepared by me or under my direct supervision and that I am a duly Licensed Landscape Architect under the laws of the State of Minnesota.

SIGNATURE:

TYPED OR PRINTED NAME: MICHAEL SCHROEDER

DATE: <u>01/21/2014</u> REG. NO.: <u>19664</u>

3	01/21/2014	BID	
2	12/20/2013	90% REVIEW SET	
1	10/24/2013	50% REVIEW SET	
NO	DATE	ISSUED FOR	

NO DATE REVISION

COPYRIGHT 2014 BY LHB, INC. ALL RIGHTS RESERVED

ROSEVILLE PARK
AND RECREATION
RENEWAL PROGRAM

ROSEBROOK PARK 2590 FRY STREET ROSEVILLE, MINNESOTA 55113

DRAWING TITLE:
PLANTING PLAN


FILE: ..\130225\600 Drawings\LA\Rosebrook Park\CD SET\130225 Rosebrook_L4.0

DRAWN BY: BMD

CHECKED BY: LAM

CHECKED BY: LAM
PROJ. NO: 130225
DRAWING NO:

RO_I4.0

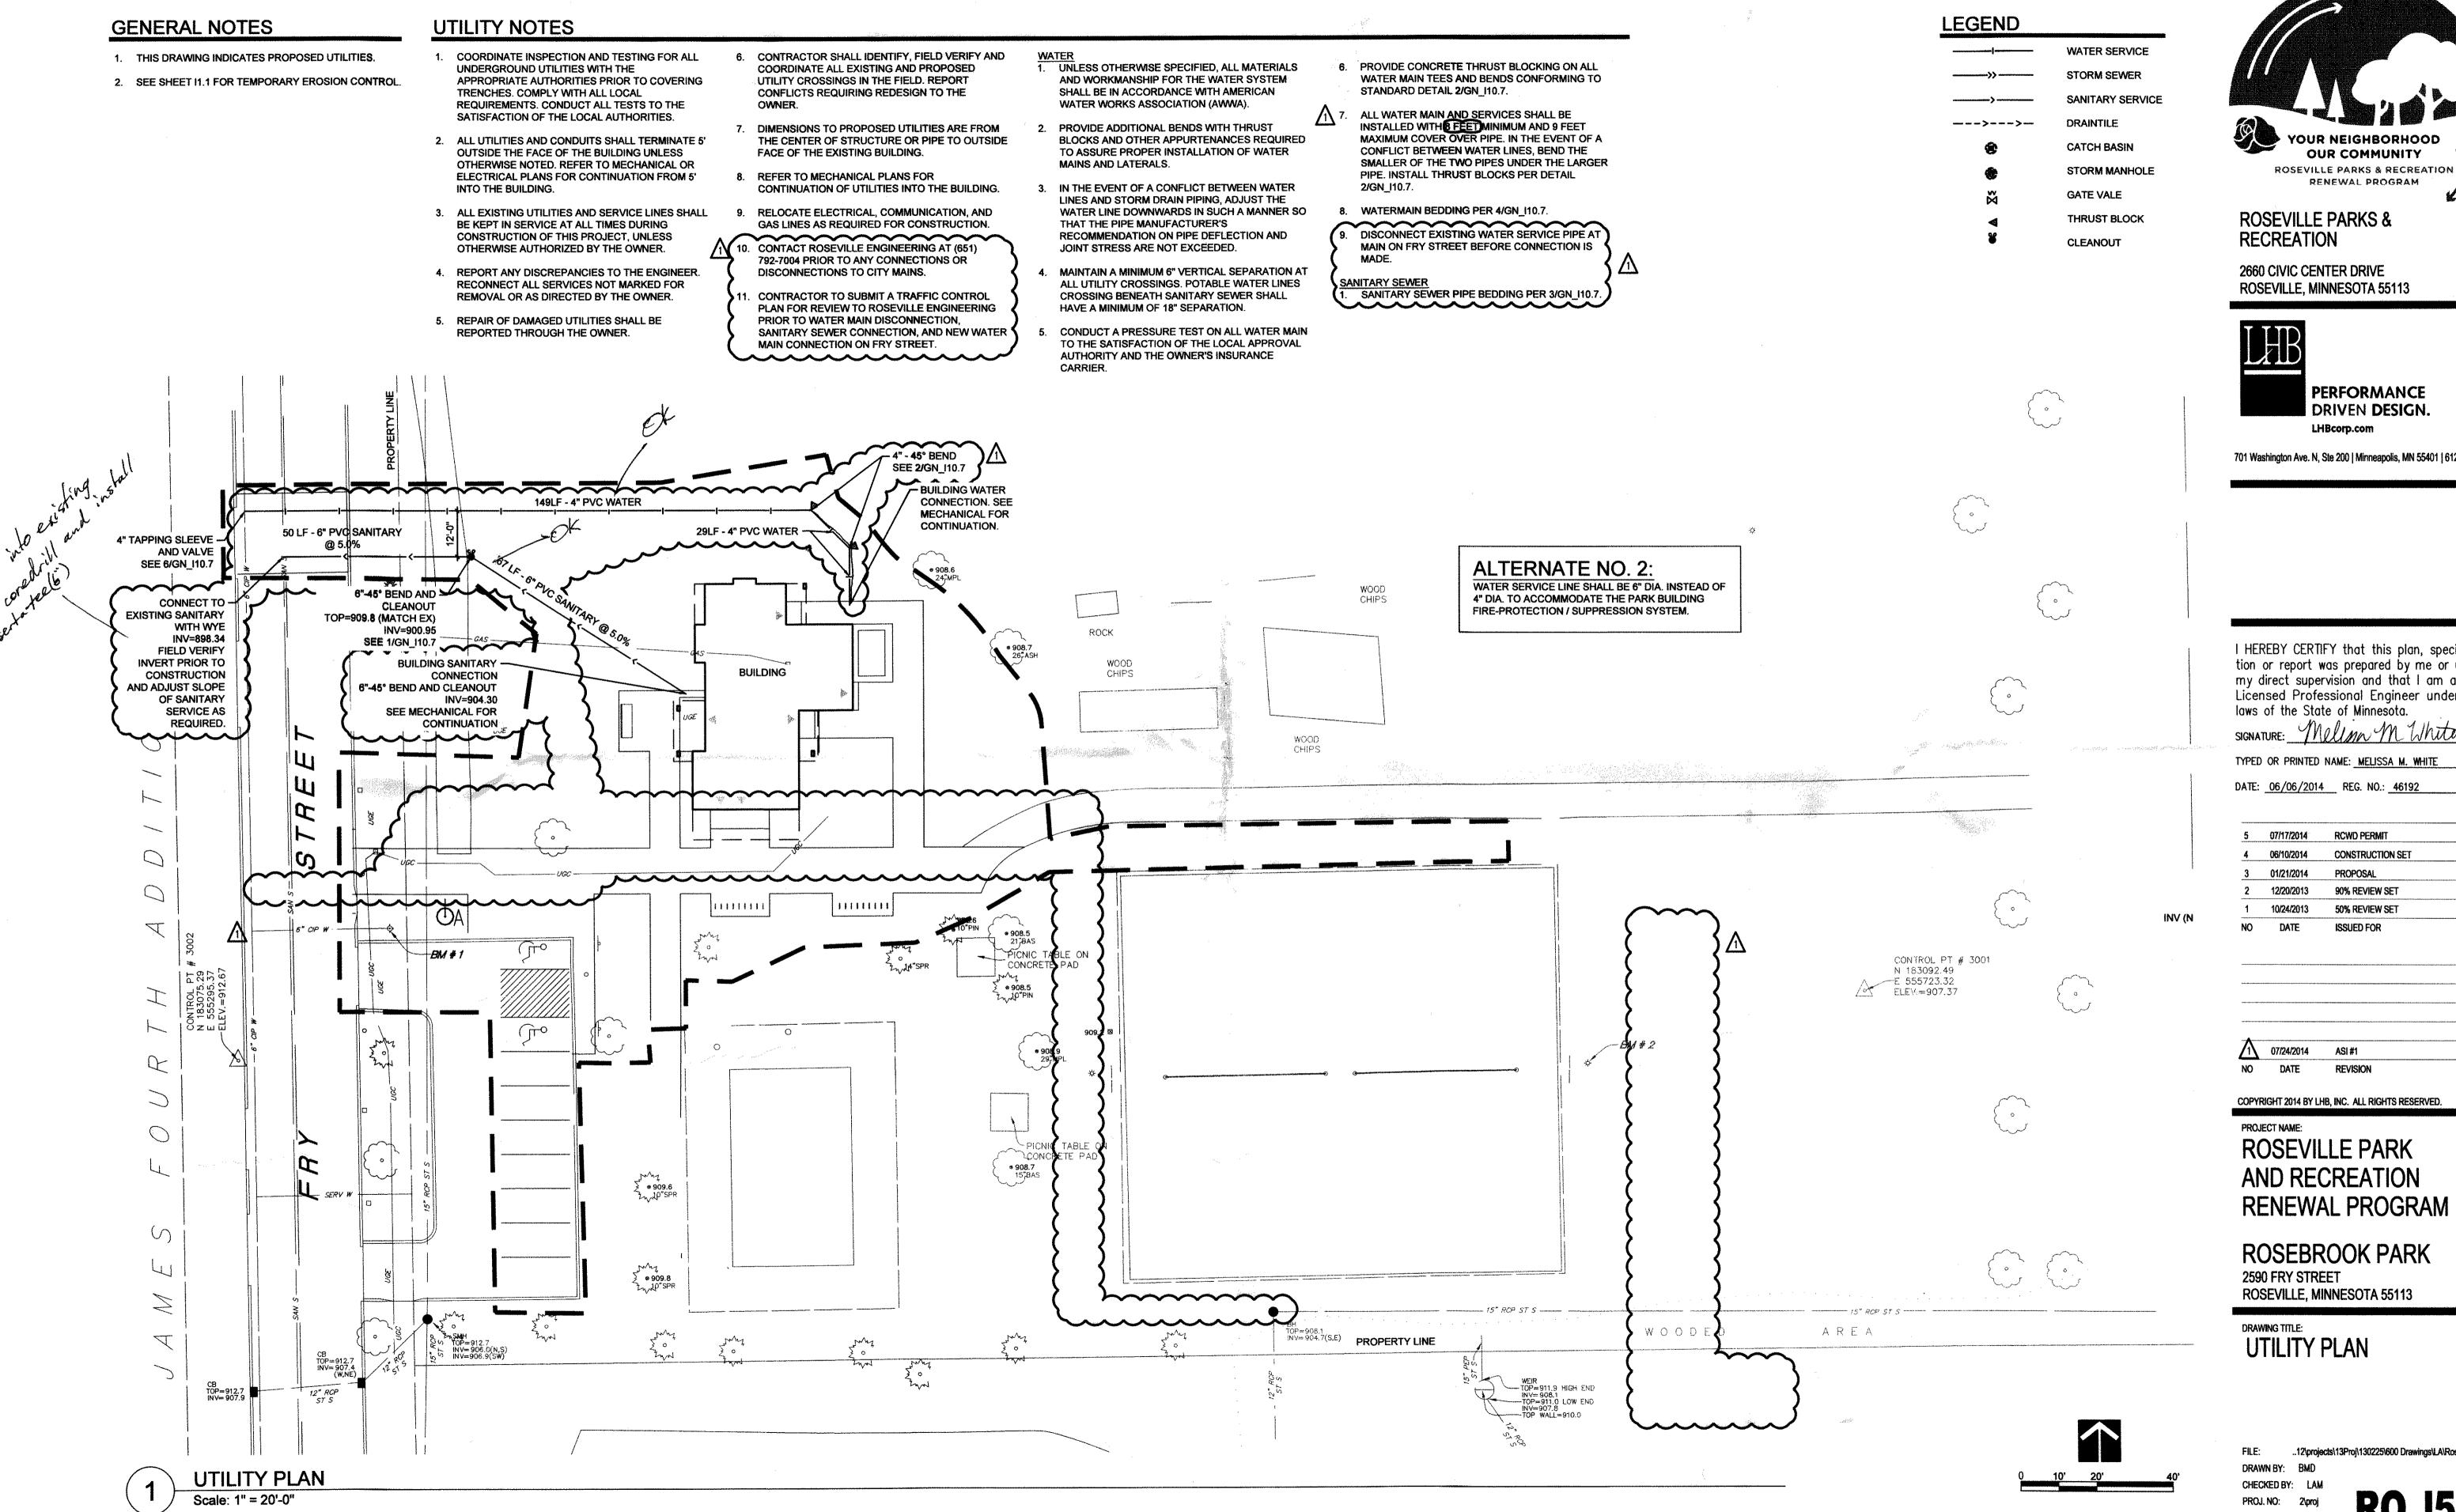



RENEWAL PROGRAM

ROSEVILLE PARKS & RECREATION

2660 CIVIC CENTER DRIVE **ROSEVILLE, MINNESOTA 55113**



PERFORMANCE DRIVEN DESIGN. LHBcorp.com

701 Washington Ave. N, Ste 200 | Minneapolis, MN 55401 | 612.338.2029

I HEREBY CERTIFY that this plan, specification or report was prepared by me or under my direct supervision and that I am a duly Licensed Professional Engineer under the laws of the State of Minnesota.

TYPED OR PRINTED NAME: MELISSA M. WHIT

DATE: 06/06/2014 REG. NO.: 4619

5 07/17/2014 RCWD PERMIT 4 06/10/2014 CONSTRUCTION SET 90% REVIEW SET 50% REVIEW SET

ISSUED FOR

07/24/2014 ASI #1

COPYRIGHT 2014 BY LHB, INC. ALL RIGHTS RESERVED

ROSEVILLE PARK AND RECREATION

ROSEBROOK PARK 2590 FRY STREET ROSEVILLE, MINNESOTA 55113

DRAWING TITLE:
UTILITY PLAN

GENERAL NOTES

- 1. THIS DRAWING INDICATES PROPOSED UTILITIES.

UTILITY PLAN

UTILITY NOTES

- 1. COORDINATE INSPECTION AND TESTING FOR ALL UNDERGROUND UTILITIES WITH THE APPROPRIATE AUTHORITIES PRIOR TO COVERING 2. SEE SHEET I1.1 FOR TEMPORARY EROSION CONTROL. TRENCHES. COMPLY WITH ALL LOCAL REQUIREMENTS. CONDUCT ALL TESTS TO THE SATISFACTION OF THE LOCAL AUTHORITIES.
 - 2. ALL UTILITIES AND CONDUITS SHALL TERMINATE 5' OUTSIDE THE FACE OF THE BUILDING UNLESS OTHERWISE NOTED. REFER TO MECHANICAL OR ELECTRICAL PLANS FOR CONTINUATION FROM 5' INTO THE BUILDING.
 - 3. ALL EXISTING UTILITIES AND SERVICE LINES SHALL BE KEPT IN SERVICE AT ALL TIMES DURING CONSTRUCTION OF THIS PROJECT, UNLESS OTHERWISE AUTHORIZED BY THE OWNER.
 - 4. REPORT ANY DISCREPANCIES TO THE ENGINEER. RECONNECT ALL SERVICES NOT MARKED FOR REMOVAL OR AS DIRECTED BY THE OWNER.
 - 5. REPAIR OF DAMAGED UTILITIES SHALL BE

- CONTRACTOR SHALL IDENTIFY, FIELD VERIFY AND COORDINATE ALL EXISTING AND PROPOSED UTILITY CROSSINGS IN THE FIELD. REPORT CONFLICTS REQUIRING REDESIGN TO THE OWNER.
- DIMENSIONS TO PROPOSED UTILITIES ARE FROM THE CENTER OF STRUCTURE OR PIPE TO OUTSIDE FACE OF THE EXISTING BUILDING.
- REFER TO MECHANICAL PLANS FOR CONTINUATION OF UTILITIES INTO THE BUILDING.

RELOCATE ELECTRICAL, COMMUNICATION, AND

GAS LINES AS REQUIRED FOR CONSTRUCTION.


- 10. CONTACT ROSEVILLE ENGINEERING AT (651) 792-7004 PRIOR TO ANY CONNECTIONS OR DISCONNECTIONS TO CITY MAINS.
- 11. CONTRACTOR TO SUBMIT A TRAFFIC CONTROL PLAN FOR REVIEW TO ROSEVILLE ENGINEERING PRIOR TO WATER MAIN DISCONNECTION, SANITARY SEWER CONNECTION, AND NEW WATER

1. UNLESS OTHERWISE SPECIFIED, ALL MATERIALS AND WORKMANSHIP FOR THE WATER SYSTEM SHALL BE IN ACCORDANCE WITH AMERICAN

WATER WORKS ASSOCIATION (AWWA).

- 2. PROVIDE ADDITIONAL BENDS WITH THRUST BLOCKS AND OTHER APPURTENANCES REQUIRED TO ASSURE PROPER INSTALLATION OF WATER MAINS AND LATERALS.
- 3. IN THE EVENT OF A CONFLICT BETWEEN WATER LINES AND STORM DRAIN PIPING, ADJUST THE WATER LINE DOWNWARDS IN SUCH A MANNER SO THAT THE PIPE MANUFACTURER'S RECOMMENDATION ON PIPE DEFLECTION AND JOINT STRESS ARE NOT EXCEEDED.
- 4. MAINTAIN A MINIMUM 6" VERTICAL SEPARATION AT ALL UTILITY CROSSINGS. POTABLE WATER LINES CROSSING BENEATH SANITARY SEWER SHALL HAVE A MINIMUM OF 18" SEPARATION.
- CONDUCT A PRESSURE TEST ON ALL WATER MAIN AUTHORITY AND THE OWNER'S INSURANCE

- PROVIDE CONCRETE THRUST BLOCKING ON ALL WATER MAIN TEES AND BENDS CONFORMING TO STANDARD DETAIL 2/GN 110.7.
- ALL WATER MAIN AND SERVICES SHALL BE INSTALLED WITH 8 FEET MINIMUM AND 9 FEET MAXIMUM COVER OVER PIPE. IN THE EVENT OF A CONFLICT BETWEEN WATER LINES, BEND THE SMALLER OF THE TWO PIPES UNDER THE LARGER PIPE. INSTALL THRUST BLOCKS PER DETAIL 2/GN_I10.7.
- 8. WATERMAIN BEDDING PER 4/GN_I10.7.
- 9. DISCONNECT EXISTING WATER SERVICE PIPE AT MAIN ON FRY STREET BEFORE CONNECTION IS MADE.
- SANITARY SEWER PIPE BEDDING PER 3/GN_I10.7

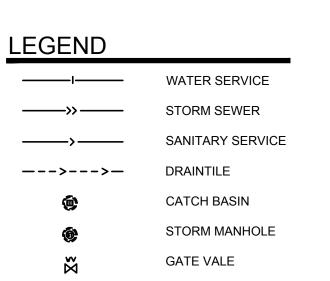

THRUST BLOCK

CLEANOUT

YOUR NEIGHBORHOOD **OUR COMMUNITY ROSEVILLE PARKS & RECREATION** RENEWAL PROGRAM

ROSEVILLE PARKS & RECREATION

2660 CIVIC CENTER DRIVE ROSEVILLE, MINNESOTA 55113



701 Washington Ave. N, Ste 200 | Minneapolis, MN 55401 | 612.338.2029

I HEREBY CERTIFY that this plan, specifica tion or report was prepared by me or under my direct supervision and that I am a duly Licensed Professional Engineer under the laws of the State of Minnesota.

TYPED OR PRINTED NAME: MELISSA M. WHITE

SIGNATURE: Mellyn M White

DATE: <u>06/06/2014</u> REG. NO.: <u>46192</u>

5	07/17/2014	RCWD PERMIT
4	06/10/2014	CONSTRUCTION SET
3	01/21/2014	PROPOSAL
2	12/20/2013	90% REVIEW SET
1	10/24/2013	50% REVIEW SET
NO	DATE	ISSUED FOR

2	05/27/2015	ASI #10	
Λ	07/24/2014	ASI #1	
NO	DATE	DEVICION	

COPYRIGHT 2014 BY LHB, INC. ALL RIGHTS RESERVED


PROJECT NAME: ROSEVILLE PARK AND RECREATION RENEWAL PROGRAM

ROSEBROOK PARK 2590 FRY STREET ROSEVILLE, MINNESOTA 55113

DRAWING TITLE: UTILITY PLAN

PROJ. NO: DRAWING NO:

FILE: ..\130225\600 Drawings\LA\Rosebrook Park\CD SET\130225 Rosebrook L5.0 DRAWN BY: BMD CHECKED BY:

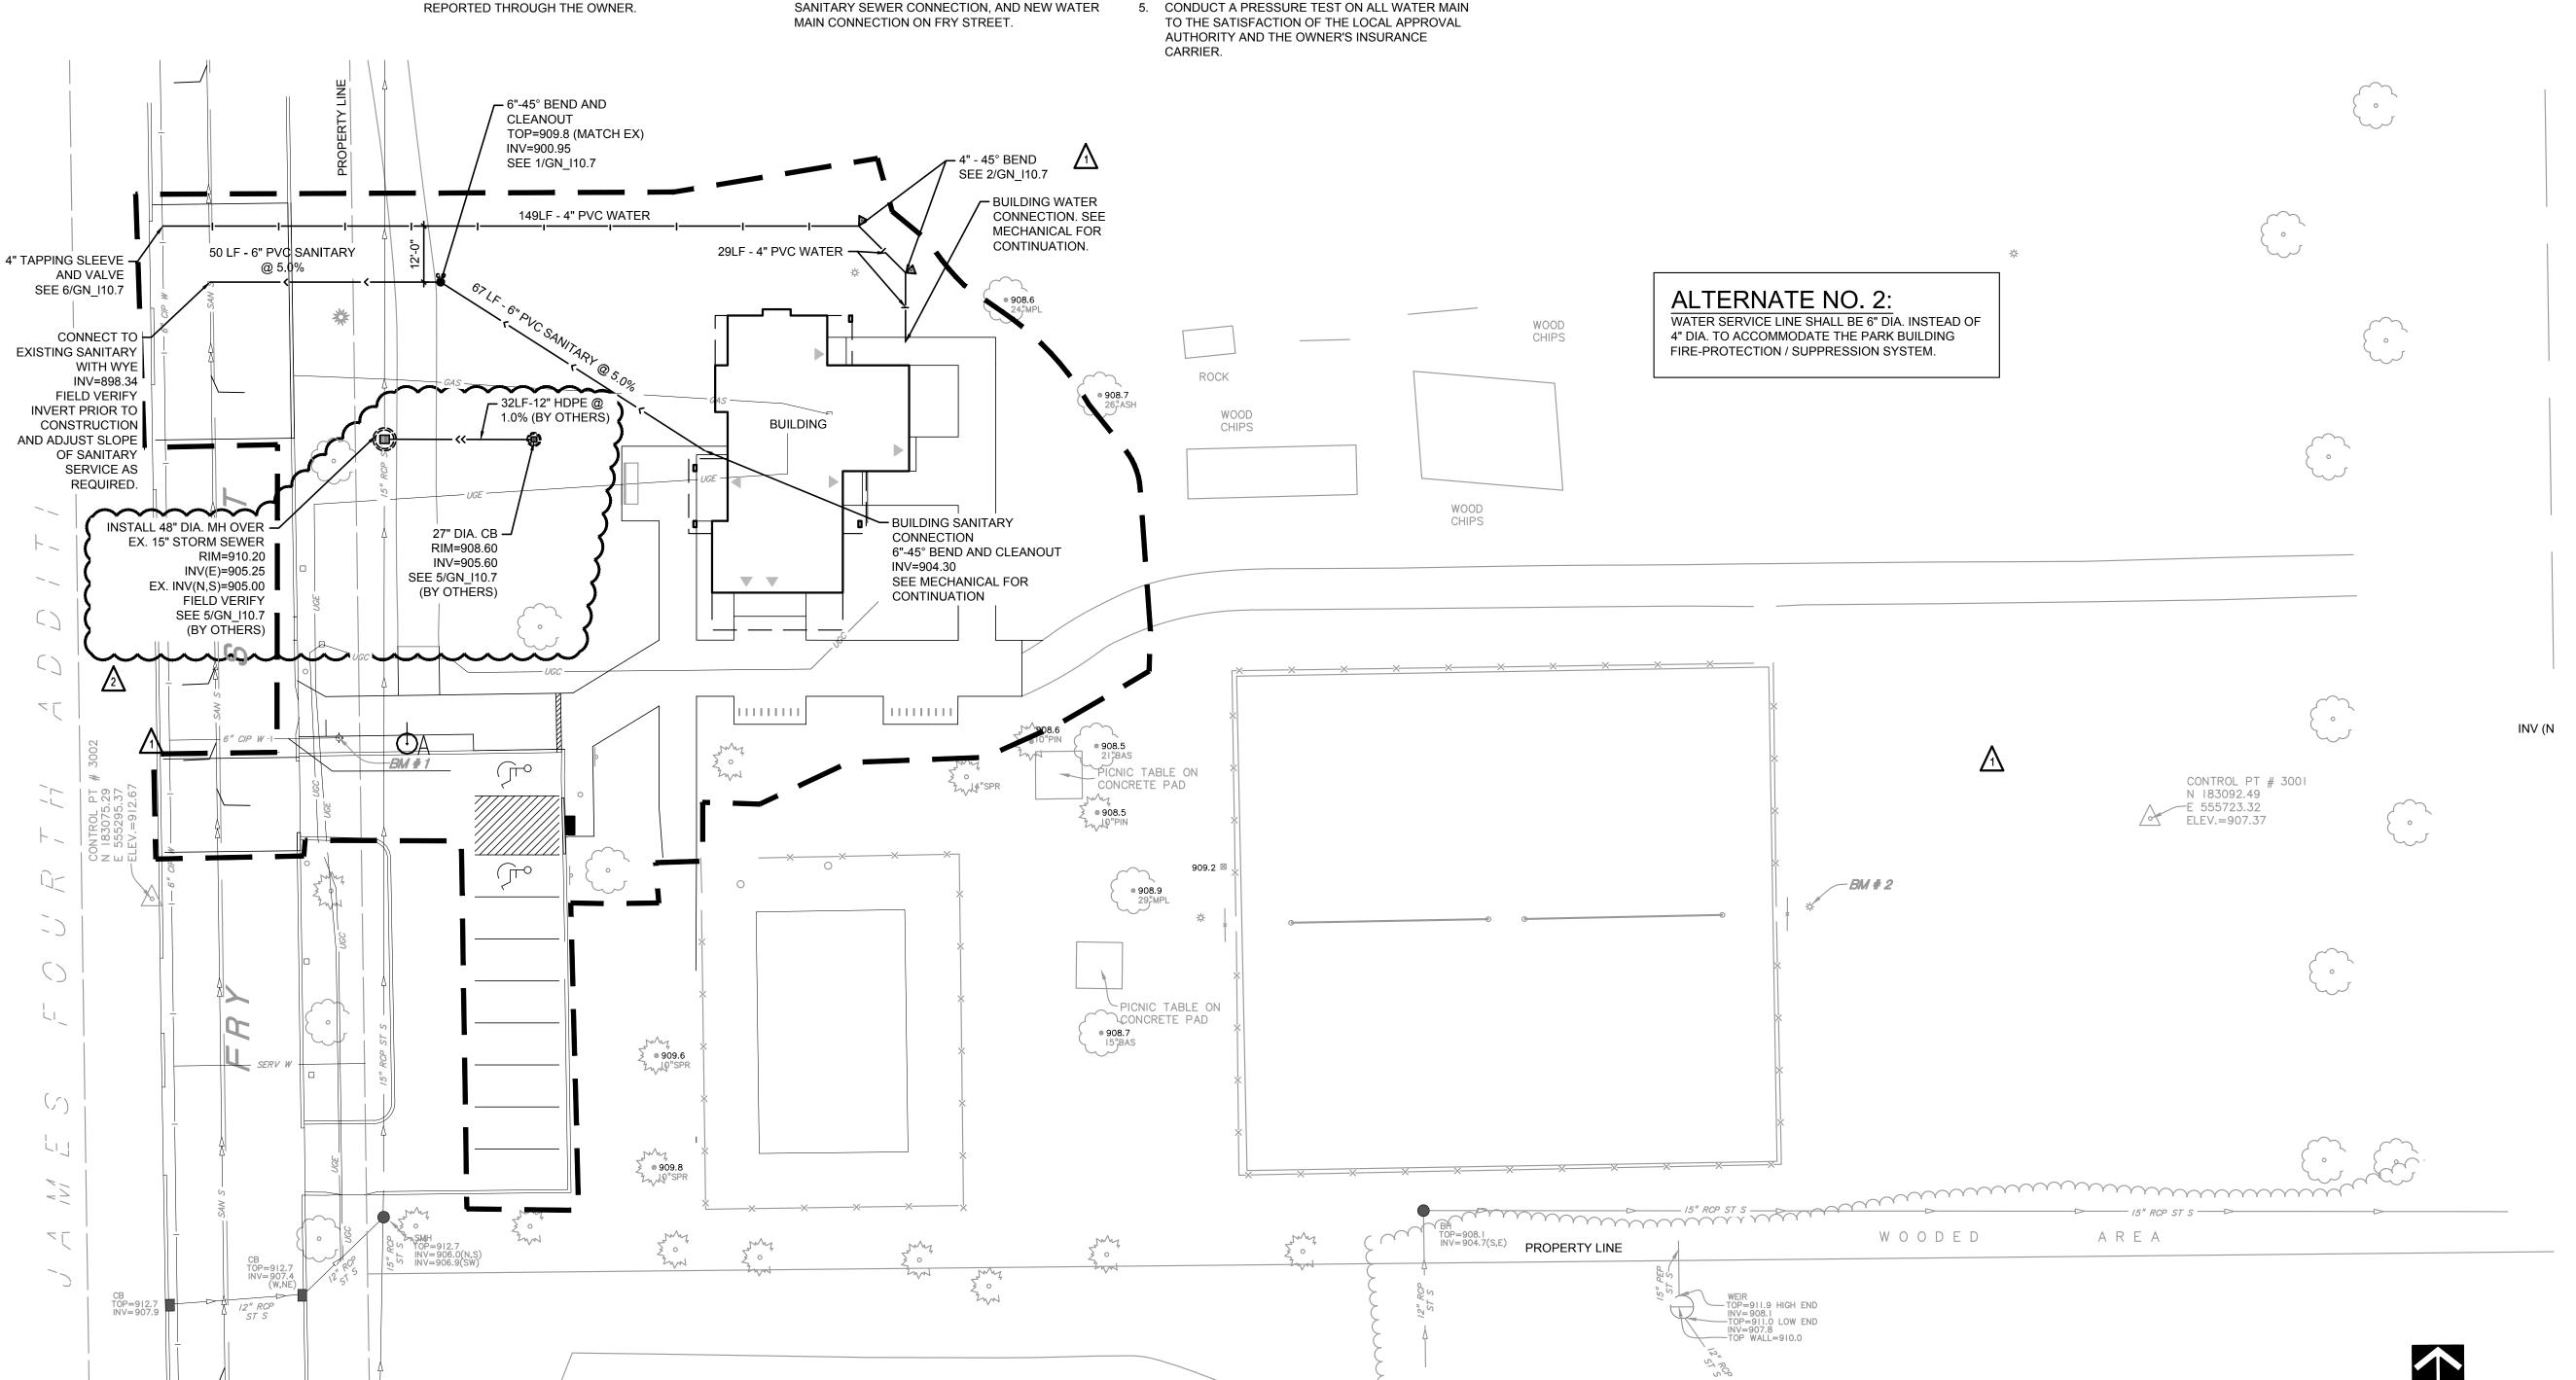

GENERAL NOTES

- 1. Work to be accomplished on these Drawings and the accompanying specifications includes the furnishing of all labor, materials, equipment, and services necessary for the proper completion of all mechanical work.
- 2. Before submitting a proposal on the work contemplated on these drawings and accompanying specifications, each bidder shall examine the site, check as to the means of making connections to services, and shall become familiar with all the existing conditions and limitations. No extras will be allowed because of the contractor's misunderstanding as to the amount of work involved or his lack of knowledge of any site conditions which may affect his work. Any apparent variance of the plan or specification from existing conditions at the site shall be called to the attention of the Engineer during the bid period so clarification can be made by addendum.
- 3. Existence of any wires, conduits, pipes, ducts, or other facilities are shown in a general way only. It will be the duty of the contractor to visit the site and make exact determination of the existence of any such facilities prior to the submission of his bid. It is understood that he will be responsible for making the exact determination of the location and condition of such facilities.
- 4. All required fees, permits, and inspections shall be obtained and/or arranged for by the contractor under the section of the Specifications for which they are required.
- 5. Regular inspections shall be arranged by the contractor as required by any and all regulations. All charges from regulating agencies for inspections of installations or review of plans and Specifications shall be paid by the contractor.
- Certificate of Final Inspection. Under each applicable section of the Specifications, contractor shall, upon completion of the work under that section, furnish a Certificate of Final Inspection to the Engineer from the inspection department having jurisdiction.
- 7. All materials and workmanship shall comply with all current and applicable codes, specifications, ordinances, laws, regulations, industry standards, and utility company regulations.
- 8. In case of difference among building codes, specifications, state laws, local ordinances, industry standards, and utility company regulations and the Contract Documents, the most stringent shall govern. Contractor shall promptly notify the Engineer in writing of any such difference.
- 9. All applicable federal, state, and local laws and ordinances shall be adhered to throughout the construction project.
- 10. Non-Compliance. Should the contractor perform any work that does not comply with the requirements of the applicable building codes, state laws, local ordinances, industry standards, and utility company regulations, he shall bear all costs arising to correct the deficiencies.
- 11. Contractor shall initiate, maintain, and supervise all safety pre—cautions required for his work, including regulations of the Occupational Safety and Health Administration (OSHA).
- 12. Drawings are to scale as noted, but the contractor shall refer to Architectural and Structural Drawings for exact location of partitions, walls, beams, shafts, equipment, etc.
- 13. Each trade shall obtain drawings and specifications of all other trades and coordinate his work with all other trades.
- 14. Drawings show the general arrangement of ductwork, piping, equipment, and appurtenances and shall be followed as closely as actual building construction and work of other trades will permit. Mechanical work shall conform to the requirements shown on all of the drawings. Architectural and Structural Drawings shall take precedence over Mechanical Drawings. Because of the small scale of the Mechanical Drawings, it is not possible to indicate all offsets, fittings, and accessories that may be required.
- 15. Discrepancies discovered before or after work has started shall be brought to the attention of the Engineer immediately, and the Engineer reserves the right to require minor changes in the work of any contractor to eliminate such discrepancies with no change in contract cost.
- 16. Plans and specifications are complementary, and what is called for in either one shall be as binding as if called for in both.
- 17. Where a disagreement exists between the plans and specifications, the item or arrangement of better quality, greater quality, or higher cost shall be included in the bid.
- 18. Normal use of the facility shall not be disturbed, except within the immediate construction area. all walks, driveways, and

- entrances shall be kept clear and free of all contractor's equipment, material, and debris at all times.
- 19. all materials and equipment shall be stored in such a place and in such a manner that a minimum of congestion will result. the placing of such materials and equipment shall be subject to the approval of the owner.
- 20. Contractor shall thoroughly examine the existing building with regard to what temporary measures he must take in order to permit the owner to occupy specific areas of the building during the various construction phases. refer to division 1, section 1010, "summary of work" for construction sequencing schedule. in general, systems must remain in use in those designated areas to permit the owner to function in a pre—construction manner.
- 21. Each contractor shall coordinate work with other trades in the installation of equipment, piping, conduit, and ductwork.
- 22. HVAC/sheet—metal contractor shall initiate the coordination process by providing reproducible plan drawings showing ductwork and equipment.
- 23. Drawings will be forwarded to the piping contractor and electrical contractor for inclusion of their systems work.
- 24. Contractors shall solve all coordination conflicts among themselves when possible. engineer will arbitrate when necessary, and his judgment will stand, with no additional cost to the owner.
- 25. Access panels shall be furnished by the trade requiring them and delivered to the general contractor for installation.
- 26. Access panels shall be as manufactured by milcor, or approved equal, and of type the is compatible with construction and finish of the wall and/or ceiling
- 27. Each trade shall perform all cutting and patching necessary in order to perform the work, unless such work has been delegated to the general contractor/another trade. however, special permission shall be obtained from the engineer before cutting structural members or finished materials. all patching shall be performed in such manner as to leave no visible trace and to return the part affected to the condition of undisturbed work. patching work shall be performed by persons experienced, skilled, and licensed for the particular type of work involved. inferior work will not be accepted. all holes in masonry shall be drilled with rotary drills. impact tools shall not be used.
- 28. Each trade shall bear the expense of all cutting, patching, repairing, or replacing of the work of other trades required because of his fault, error, or tardiness of because of any damage done by him.
- 29. Each trade shall provide all holes and openings required for his work, unless such holes and openings are shown to be provided on the architectural or structural drawings.
- 30. Each trade shall remove existing work that is shown, specified, or obviously necessary for completion of his work. owner shall have the option of retaining any item or material removed under this contract. items or materials not retained by owner shall become the property of the trade and shall be removed from the premises.
- 31. Each trade shall periodically clear away all debris, surplus materials, etc., resulting from his work or operations, leaving the job and the equipment furnished under any or all contracts in a clean condition.
- 32. Each trade shall test the equipment provided and/or installed under the specification and shall demonstrate its proper operation to the owner's operating engineer.
- 33. Each trade shall furnish, without additional expense to the owner, the services of competent instructors, who will give full instruction in the care, adjustment, and operation and maintenance of all parts of the equipment to the owner's permanent employees who are to have charge of the equipment.
- 34. HVAC subcontractor shall be responsible for tested & rated fire stop systems for all thru—penetration of walls, floors & roof assemblies resulting from piping & other work under his contract. refer to specification section for fire stopping for requirements.
- 35. All wood nailers and other lumber which is installed in contact with metal, concrete, or masonry shall be pressure treated against decay (unless otherwise noted).

MN PLUMBING CODE

CONTRACTOR TO FURNISH AND INSTALL PLUMBING MATERIALS AND SYSTEMS PER MINNESOTA PLUMBING CODE.

EXISTING WASTE AND WATER SYSTEM SIZE HAS BEEN VERIFIED TO ACCOMMODATE ADDED FIXTURES (MN 4715.3700, MN 4715.2310)

PROVIDE ADDITIONAL AIR GAP ARRANGEMENT OR APPROVED BACKFLOW PREVENTER ON DISHWASHERS, CLOTHES WASHER, COFFEE MAKERS, REFRIGERATORS, AND/OR ICE MAKERS WHEN NOT PROVIDE WITH THE EQUIPMENT. (MN 4715.2000, MN 4715.2010)

CONNECT DISHWASHER DISCHARGE TO SINK TAILPIECE PER CODE (MN 4715.1250)

PROVIDE ADDITIONAL CLEANOUTS AS REQUIRED TO TEST NEW WASTE AND VENT SYSTEMS.

PROVIDE ADDITIONAL CLEANOUTS WHERE REQUIRED BY CODE. (MN 4715.1000)

PROVIDE PIPE HANGER AND INSTALL SUPPORT SPACING PER CODE. (MN 4715.1430)

4715.2250, MN 4715.2820)

DISINFECT AND TEST THE DOMESTIC WATER PIPING SYSTEM PER CODE. (MN

PROVIDE WATER PIPING MATERIALS AND INSTALLATION SHALL COMPLY PER CODE. (MN 4715.0520, MN 4715.1710)

UNDERGROUND BUILDING DRAIN AND BUILDING SEWER PIPE WITHIN 10 FEET HORIZONTALLY OF UNDERGROUND WATER SERVICE PIPING MUST BE CONSTRUCTED PER CODE. (MN 4715.1710)

DESCRIPTION

MECHANICAL SYMBOLS

- HOT WATER CIRCULATING

SANITARY WASTE UNDER GROUND

SANITARY WASTE ABOVE FLOOR

FIRE DEPT SIAMESE CONNECTION

- COLD WATER

RWL STORM SEWER UNDER GROUND

RAIN WATER LEADER

—— G ——— NATURAL GAS

— SPK — FIRE SPRINKLER

CONDENSATE DRAIN LINE

PIPE DOWN

TAKE-OFF DOWN

PIPE UP

UNION

CLEAN-OUT

FLOOR DRAIN

ROOF DRAIN

CHECK VALVE / BACKFLOW PREVENTOR

PRESSURE REGULATING VALVE

SHUT-OFF VALVE

SOLENOID VALVE

THERMOSTAT

FIRE DAMPER

SUPPLY DUCT UP

VOLUME DAMPER

CEILING GRILLE

FIRE SMOKE DAMPER

RETURN DUCT DOWN

SUPPLY AIR DIFFUSER

SUPPLY WALL GRILLE

DUCT UP THROUGH ROOF

SENSOR

----VENT

FD -----

FS FLOOR SINK

RPZ BACKFLOW PREVENTER SHALL BE INSTALLED BETWEEN 12" & 72" AFF WHERE IT CAN BE TESTED EACH YEAR AND OVERHAULED. CONTRACTOR TO INFORM OWNER OF CODE REQUIRED TESTING. (MN 4715.2120)

PIPING SHALL BE INSTALLED PER CODE. CHANGE IN DIRECTION IN DRAINAGE PIPING MUST BE MADE WITH USE OF WYES, AND BEND. SANITARY TEES ARE NOT ALLOWED WHERE THE DIRECTION OF FLOW CHANGES. (MN 4715.2410)

ALL SANITARY PIPING UNDERGROUND SHALL BE A MINIMUM 2" DIAMETER. (MN 4715.2350)

ALL SOIL, WASTE, DRAIN AND VENT PIPING ABOVE THE GROUND WITHIN A PLENUM RETURN CEILING SHALL BE STANDARD WEIGHT CAST IRON PIPE, WITH NO—HUB NEOPRENE SLEVE BANDED GASKETS,. INSTALLATION AND MATERIAL OF PIPING SHALL BE IN ACCORDANCE WITH CODE. (MN 4715.0570 — MN 4715.0600)

INSTALL 6 GALLON WATER HEATERS ABOVE ACCESSIBLE CEILING PER CODE (MN 4715.2240)

HORIZONTAL WASTE PIPING SHALL BE INSTALLED IN UNIFORM ALIGNMENT AND UNIFORM SLOPE. (MN 4715.2400)

INSTALL VALVES ON EACH ROOM OR INDIVIDUAL FIXTURE PER CODE (MN 4715.1800)

MATERIALS USED FOR PLUMBING SYSTEM MUST COMPLY WITH STANDARDS SET PER CODE. (MN 4715.0420) PVC SANITARY & STORM (MN 4715.0530, MN 4715.0540, MN 4715.0810), HUBLESS CAST IRON DRAINAGE, WASTE AND VENT (MN 4715.0550 – MN 4715.0600), HUBLESS CAST IRON STORM (MN 4715.0550, MN 4715.0600)

DRAWING NUMBER	DRAWING TITLE
RO-m0.1	MECHANICAL NOTES
RO-m1.1	HVAC PLAN
RO-m2.1	PLUMBING PLAN
RO-m3.1	MECHANICAL DETAILS, SCHEDULES AND RISERS



ROSEVILLE PARKS & RECREATION

2660 CIVIC CENTER DRIVE ROSEVILLE. MINNESOTA 55113



PERFORMANCE DRIVEN DESIGN.

250 3rd Ave. N, Ste 450 | Minneapolis, MN 55401 | 612.338.2029

LHBcorp.com



emanuelson-podas consulting engineers 10401 Bren Road East Minnetonka, MN 55343 ph: 952-930-0050 fax: 952-930-0777 www.epinc.net

I hereby certify that this drawing was prepared by me or under my direct supervision and that I am a duly registered architect under the laws of the State of Minnesota.

BY: Scott A. Vander Heiden TITLE: ENGINEER

DATE: 01/21/2014 REG. NO.: 40918

5	6/10/2014	CONSTRUCTION SET
4	01/21/2014	BID
3	12/20/2013	90% REVIEW SET
2	10/07/2013	90% REVIEW SET
1	9/11/2013	FINAL DESIGN
NO	DATE	ISSUED FOR

	6/04/2014	ADDENDUM 4	
$\overline{\Lambda}$	2/11/2014	ADDENDUM 1	
NO	DATE	DEVICION	

COPYRIGHT 2014 BY LHB, INC. ALL RIGHTS RESERVED.


ROSEVILLE PARK
AND RECREATION
RENEWAL PROGRAM

ROSEBROOK PARK 2590 FRY STREET ROSEVILLE, MINNESOTA 55113

DRAWING TITLE:
MECHANICAL NOTES

FILE:
DRAWN BY: BR
CHECKED BY: SVH
PROJ. NO: s\3587
DRAWING NO:

RO-m0.1

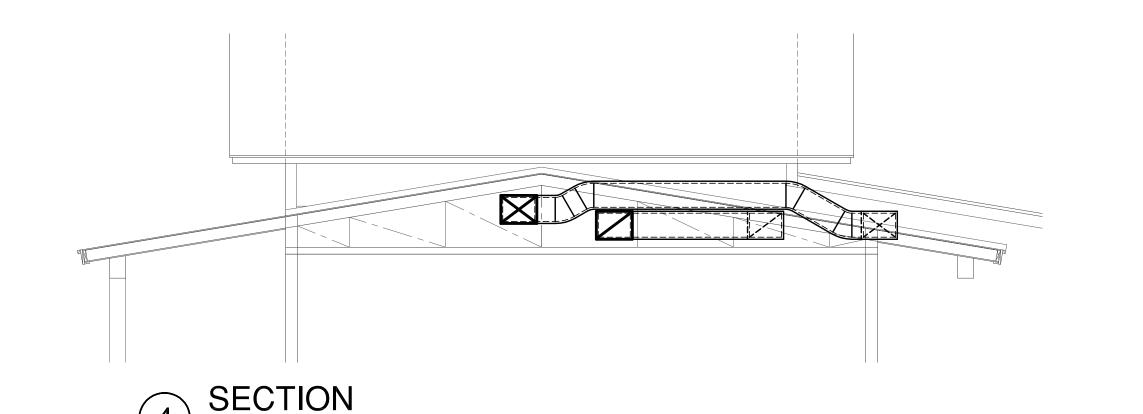

└-12"ø OA

└_12"ø OA

<u>FURNACE</u>

<u>FURNACE</u>

FROM EXHAUST FAN FROM EXHAUST FAN WITH BACKDRAFT DAMPER -WITH BACKDRAFT DAMPER CONNECT EXHAUST DUCT TO CONNECT EXHAUST DUCT TO BACK AND SIDE OF PLENUM.-BACK OR SIDE OF PLENUM.— LOUVER PLENUM BOX, SLOPE LOUVER PLENUM BOX, SLOPE BOTTOM BACK TOWARDS LOUVER AND BOTTOM BACK TOWARDS LOUVER AND SOLDER ALL JOINTS WATER TIGHT. — SOLDER ALL JOINTS WATER TIGHT. —

LOAD CALCULATION SCHEDULE - ROSEBROOK area REQUIRED AVAILABLE REQUIRED available NOTES BTUH BTUH BTUH BTUH GATHERING 106 45200 55688 40300 70291 SERVERY 107 3500 4312 2700 4709 SU#1 TOTAL 48700 60000 43000 75000 VESTIBULE 101 9900 12960 7800 17402 STAFF 102 5400 7069 5600 WOMENS 103 1400 1833 1200 2677 1000 1309 500 1116 MENS 104 STORAGE 109 3404 7363 2600 3300 MECH 108 1600 2095 2600 5801 FAMILY 110 2800 3665 2300 5131 FAMILY 111 2800 3665 1800 4016 SU#3 27500 36000 56000 TOTAL 25100


1. MINNESOTA RULES CHAPTER 1323.0642 - DESIGN CONDITIONS SUMMER 88/72, WINTER -15

SECTION

SCALE: 1/4" = 1'-0"

KEYED NOTES:

- INSTALL FURNACE ON CONC PAD, WITH SIDE RETURN FILTER. EXTEND SUPPLY AND RETURN DUCTS UP INTO JOIST SPACE. CONNECT OUTSIDE AIR DUCT TO RETURN WITH VOLUME DAMPER AND MOTORIZED DAMPER.
- EXTEND FLUE AND COMBUSTION FROM EACH FURNACE UP THROUGH ROOF TO CONCENTRIC ROOF CAP. SIZE AND INSTALL PER MANUFACTURERS INSTRUCTIONS.

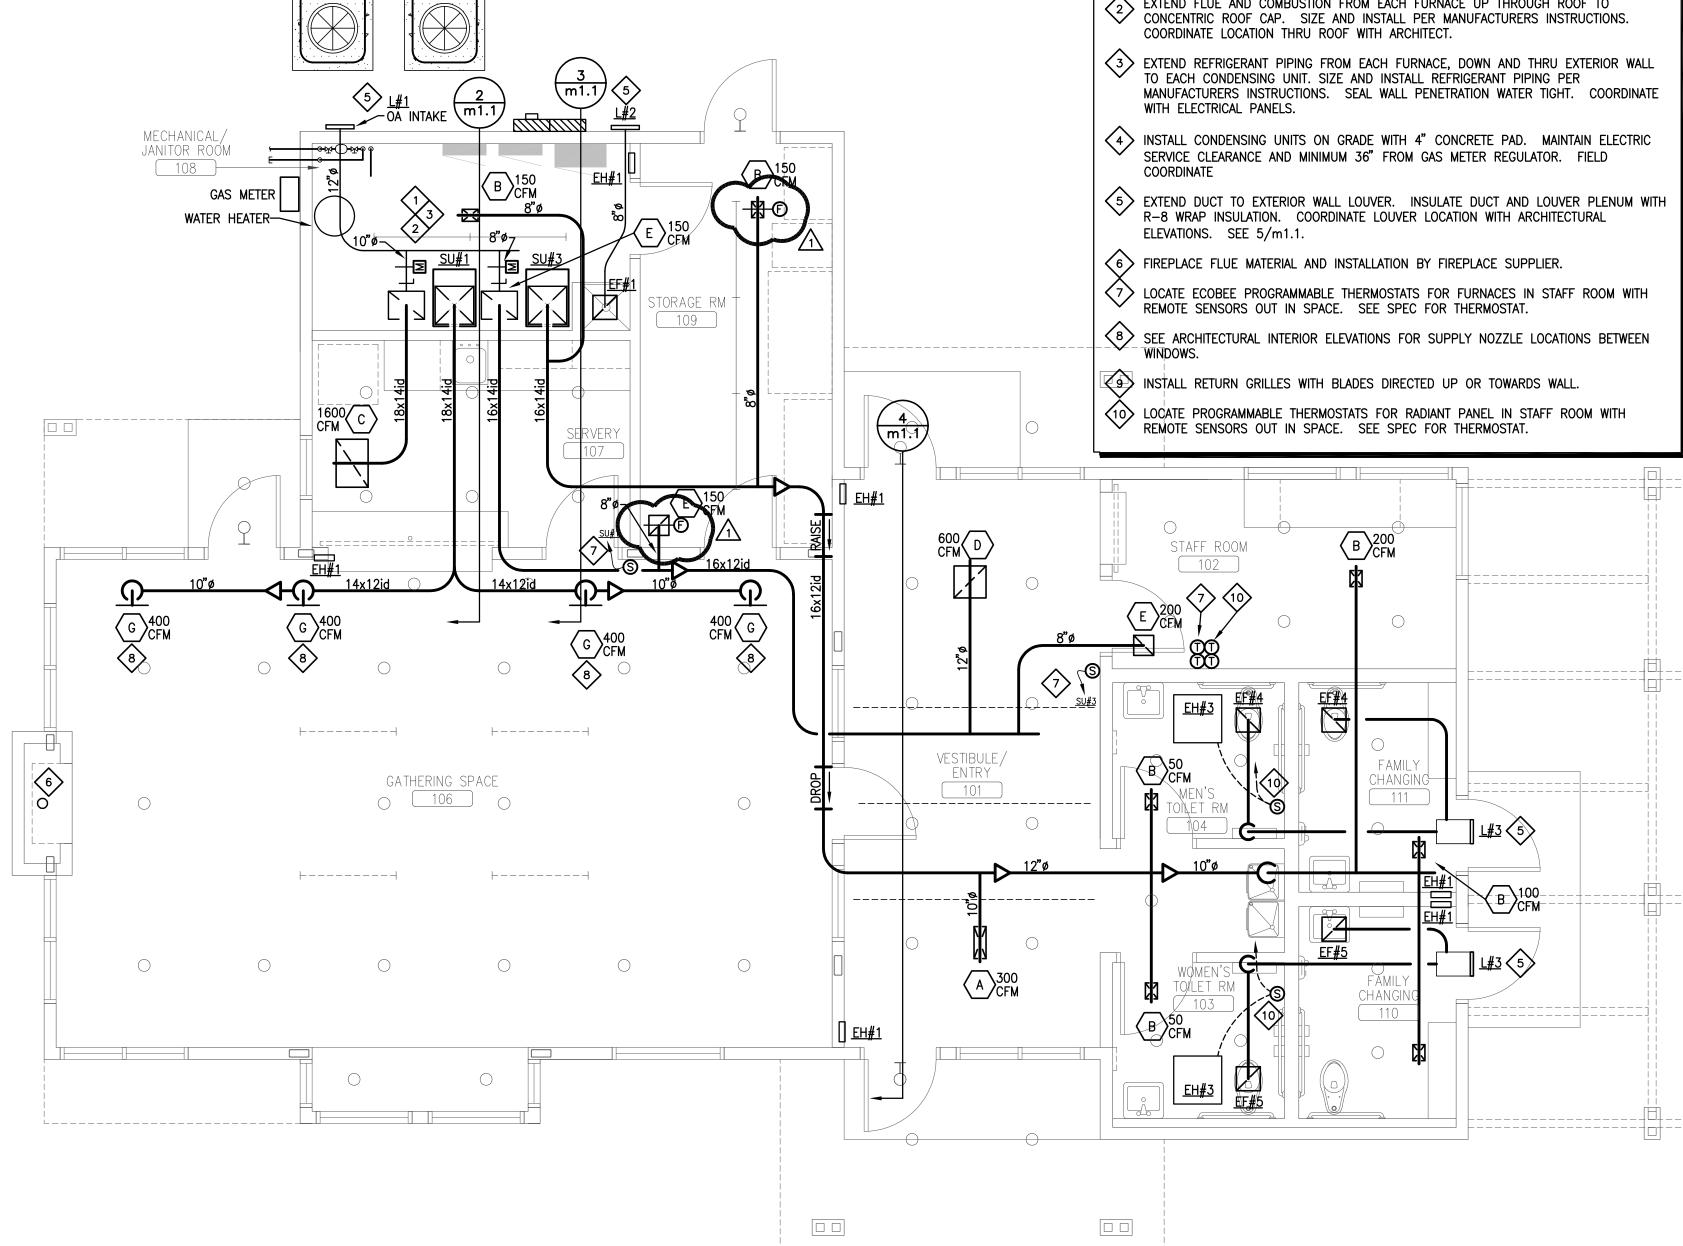



ROSEVILLE PARKS & RECREATION

2660 CIVIC CENTER DRIVE ROSEVILLE, MINNESOTA 55113



PERFORMANCE DRIVEN DESIGN. LHBcorp.com

250 3rd Ave. N, Ste 450 | Minneapolis, MN 55401 | 612.338.2029



emanuelson-podas consulting engineers 10401 Bren Road East Minnetonka, MN 55343 ph: 952-930-0050 fax: 952-930-0777 www.epinc.net

I hereby certify that this drawing was prepared by me or under my direct supervision and that I am a duly registered architect under the laws o the State of Minnesota.

BY: Scott A. Vander Heiden TITLE: ENGINEER

DATE: 01/21/2014 REG. NO.: 40918

6/10/2014 CONSTRUCTION SET 4 05/16/2014 REISSUE 1/21/2014 PROPOSAL 90% REVIEW SET 12/20/2013

CC PACKET

ISSUED FOR

11/19/2013

07/24/2014

DATE REVISION

PROJECT NAME: ROSEVILLE PARK AND RECREATION

RENEWAL PROGRAM

COPYRIGHT 2014 BY LHB, INC. ALL RIGHTS RESERVED

ROSEBROOK PARK 2590 FRY STREET ROSEVILLE, MINNESOTA 55113

DRAWING TITLE: HVAC PLAN

FILE: DRAWN BY: BR CHECKED BY: SVH DRAWING NO:

RO-m1.1




HVAC PLAN

SECTION

SECTION

KEYED NOTES:

- 4" WATER SERVICE INTO BUILDING, SPLIT WITH 4" DOMESTIC WATER METER AND 2"
 CAPPED FOR FUTURE LAWN IRRIGATION METER STACKED ON WALL CAPPED FOR FUTURE LAWN IRRIGATION METER STACKED ON WALL.
- 2 CAP 2" CW 30" BELOW GRADE AND INSIDE BUILDING FOR FUTURE IRRIGATION.
- MOUNT WALL HYDRANT AT 18" ABOVE GRADE. PROVIDE SHUT-OFF VALVE FOR WINTER SHUT-DOWN.
- EXTEND 4" SANITARY SEWER 5' OUTSIDE BUILDING, SEE CIVIL FOR INVERT ELEVATION.
- GAS METER, CONTRACTOR TO COORDINATE WITH UTILITY. (165 MBH @ 7"wc CURRENT) EXTEND 1-1/4"@ 7"WC FROM METER THROUGH WALL AND INTO MECHANICAL ROOM.
- 6 EXTEND 1/2" 7"WC GAS TO EACH FURNACE AND TERMINATE WITH SHUT-OFF VALVE, DIRT LEG AND UNION.
- EXTEND 1/2" G@7"wc IN SOFFIT, SLEEVE THROUGH EXTERIOR WALL, DROP DOWN AND CONNECT TO FIRE PLACE WITH SHUT-OFF VALVE. COORDINATE CONNECTION WITH FIRE
- 8 NOT USED.
- LOCATE TANKLESS WATER HEATER ON WALL BELOW SINK IN A LOCKABLE STAINLESS STEEL CABINET. EXTEND HOT WATER PIPING TO SINK. SIZE CABINET FOR ACCESSIBILITY AND REPLACEMENT OF WATER HEATER.
- TAP 3/8" CW UNDER SINK "I CONNECT TO REFRIGERATOR. TAP 3/8" CW UNDER SINK WITH SHUT-OFF VALVE. EXTEND UNDER COUNTER AND
- MOUNT WALL HYDRANT AT 18" ABOVE GRADE. EXTEND INTO WALL WITH SHUT-OFF VALVE FOR WINTER SHUT-DOWN. PROVIDE LOCKABLE 8x8 PANEL FOR ACCESS TO VALVE.
- ROUTE WATER PIPING IN ATTIC SPACE.
- TAP 4" AFTER METER WITH SHUT-OFF VALVE, RPZ BACKFLOW PREVENTER AND BLOW-OUT VALVE. EXTEND 4" TO 5' OUTSIDE BUILDING AND CAP FOR FUTURE SPLASH
- (16) LOCATE TANKLESS WATER HEATER ON WALL BELOW SINK IN A LOCKABLE STAINLESS STEEL CABINET. EXTEND HOT WATER PIPING TO BOTH BACK-TO-BACK SINKS. SIZE CABINET FOR ACCESSIBILITY AND REPLACEMENT OF WATER HEATER.

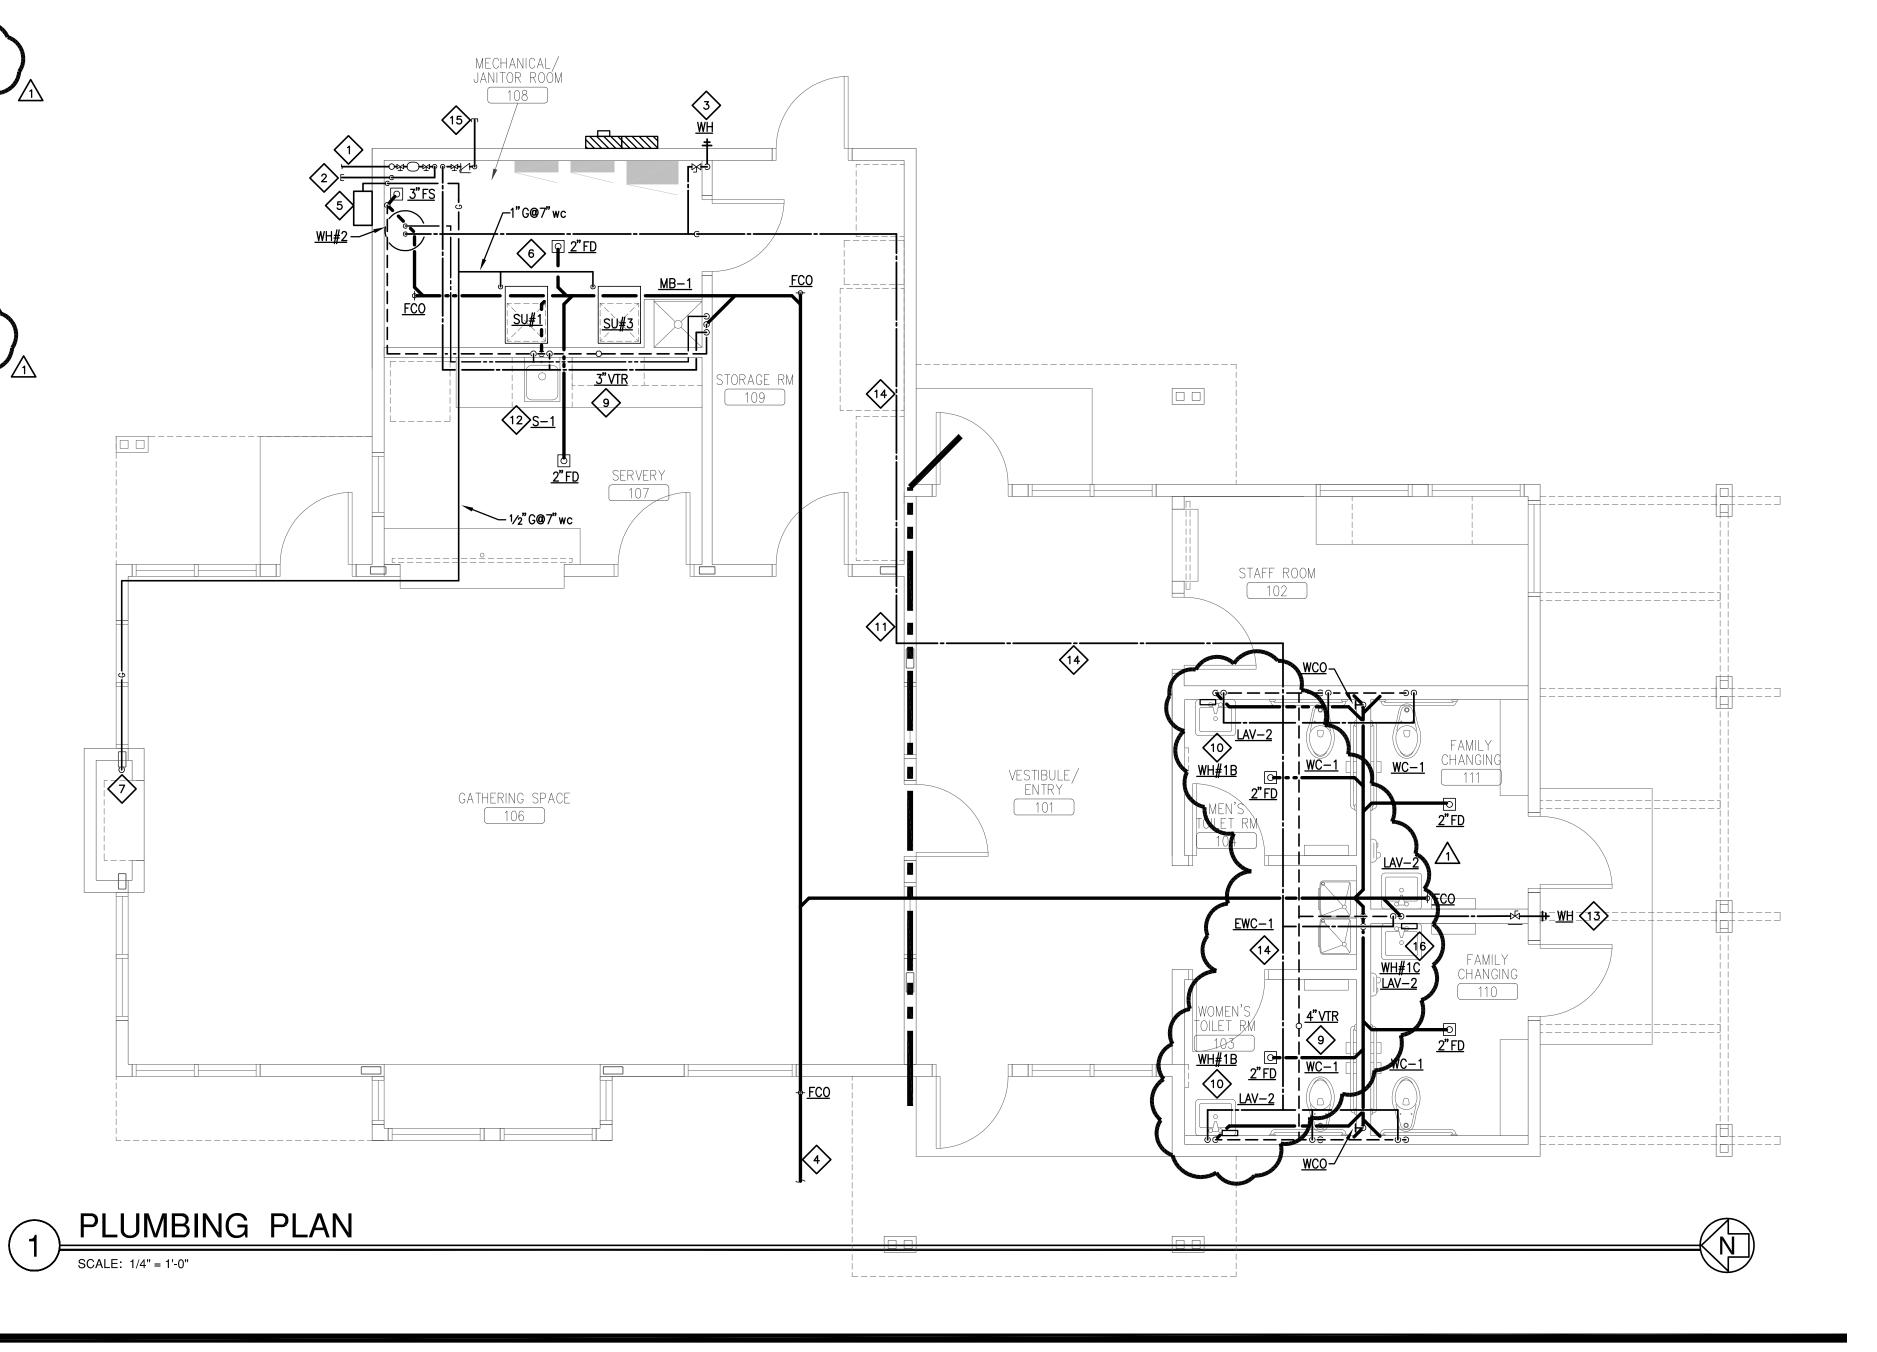



ROSEVILLE PARKS & RECREATION

2660 CIVIC CENTER DRIVE ROSEVILLE, MINNESOTA 55113



LHBcorp.com

250 3rd Ave. N, Ste 450 | Minneapolis, MN 55401 | 612.338.2029



emanuelson-podas consulting engineers 10401 Bren Road East Minnetonka, MN 55343 ph: 952-930-0050 fax: 952-930-0777 www.epinc.net

I hereby certify that this drawing was prepared by me or under my direct supervision and that I am a duly registered architect under the laws of the State of Minnesota.

BY: Scott A. Vander Heiden TITLE: ENGINEER

REG. NO.: 40918 DATE: 01/21/2014

5	6/10/2014	CONSTRUCTION SET
4	05/16/2014	REISSUE
3	1/21/2014	PROPOSAL
2	12/20/2013	90% REVIEW SET
1	11/19/2013	CC PACKET
NO	DATE	ISSUED FOR

<u> </u>	07/24/2014	ASI #1	
NO	DATE	REVISION	

COPYRIGHT 2014 BY LHB, INC. ALL RIGHTS RESERVE

PROJECT NAME: ROSEVILLE PARK AND RECREATION RENEWAL PROGRAM

ROSEBROOK PARK 2590 FRY STREET ROSEVILLE, MINNESOTA 55113

DRAWING TITLE: PLUMBING PLAN

DRAWN BY: BR CHECKED BY: SVH DRAWING NO:

RO-m2.1

FURNA	ACE - GAS FI	RED SCHEDU	JLE																
				FAN DATA	1					HEATING	5 DATA		COOLING	DATA					
																COIL]	
MARK	LOCATION	MANUF	MODEL	SUPPLY	FRESH AIR	ESP	H.P.	V	PH	E.A.T.	INPUT	OUTPUT	E.A.T.	L.A.T.	TONS	MODEL	MAX PD	FILTER	NOTES
				CFM	CFM	(IN)				(°F)	(MBH)	(MBH)					(IN)		
SU#1	108	CARRIER	58MTB080	1600	200	0.6	1/2	120	1	_	80/52	75/49	76/63	58/58	4	CNP	0.3	1"	1,2
S#13	108	CARRIER	58MTB060	1200	100	0.6	1/2	120	1	_	60/39	56/37	76/63	58/58	3	CNP	0.3	1"	1,2

. PROVIDE SIDE FILTER RACK WITH HINGED ACCESS DOOR. AND TERMINATION INTAKE/VENT KIT. 2. CONTRACTOR TO ADJUST FAN SPEED FOR FIRST STAGE OF HEATING TO MAXIMUM AIRFLOW.

AIR COO	JLED COND	DENSING SCH	HEDULE														
				1				CONDENS	ER DATA			ELECTRI	CAL DA	TA			
MARK	SERVES	MANUF	MODEL #	TOTAL CAPACITY (TONS)	STAGES	REFRIGERANT	MIN SEER	FAN NO	COIL NO/ROWS	NO COMP	AMB TEMP (*F)	VOLTS	PH	AMPS	TOTAL MCA	WEIGHT	MECH NOTES
CU#1	SU#1	CARRIER	24ACB6	4	2	R-410A	16	1	1/1	1	95	240	1	21.2 + 1.3	27.8	_	1
CU#3	SU#3	CARRIER	24ACB6	3	2	R-410A	16	1	1/1	1	95	240	1	16.7 + 1.2	22.1	_	1

MECHANICAL NOTES:

1. PROVIDE REFRIGERANT PIPE QUANTITIES AND SIZE PER MANUFACTURERS PIPING SCHEMATIC. PROVIDE CUSTOM SIZING IF LENGTH EXCEEDS 50 FEET.

ſ	ELECTRIO	C HEAT SCH	EDULE													
	MARK	LOCATION	QUANTITY	MANUF	MODEL #	TYPE	DIMENSIONS (IN)	INSTALLATION	FINISH	MOUNTING HEIGHT	CONTROL	ELECTRIC KW	VATTS	ATA V	PHNO.	MECH TES
	EH#1	SEE PLANS	6	BERKO	FRC 4024	WALL/FAN FORCED	_	WALL RECESSED	STANDARD	BTM 12" AFF	INTERGRAL	2	_	240	1	1
	EH#3	SEE PLANS	2	BERKO	CP372	RADIANT CEILING PANEL	24×24	CEILING GYP RECESSED	STANDARD	_	THERMOSTAT	_	375	120	1	2
																1

MECHANICAL NOTES:

1. PROVIDE WITH INTEGRAL THERMOSTAT, RECESSED MOUNTING FRAME.

2. PROVIDE WITH SURFACE MOUNTING FRAME. SEE SPECIFICATION FOR CONTROLS.

FAN	SCHEDUL	E														
							FAN			MOTOR						
MARK	QUANTITY	LOCATION	MANUF	MODEL #	TYPE	APPLICATION	CFM	EXTERNAL SP	RPM	DRIVE TYPE	HP	AMPS	V/PH	ROOF CURB	MAX. SONES	MECH NOTES
EF#1	1	108	BROAN	L150	CEILING	EXHAUST	150	0.40	-	DIRECT	-	2.0	120/1	_	4	1,2
EF#4	2	SEE PLAN	BR□AN	L150	CEILING	EXHAUST	100	0.40	-	DIRECT	-	2.0	120/1	_	5	1,2
EF#5	2	SEE PLAN	BR□AN	L150	CEILING	EXHAUST	100	0.40	-	DIRECT	-	2.0	120/1	_	5	1,2

1. PROVIDE WITH BACKDRAFT DAMPER. 2. FAN CONTROLLED BY LIGHT SWITCH PROVIDED AND INSTALLED BY ELECTRICAL CONTRACTOR.

MARK	MANUFACTURER	LOCATION/ TYPE	AIR	TYPE	MODEL	SIZE (IN)	DAMPER	MAX STATIC P.D. (IN WG)	MAX NC	FINISH	MECH NOTES
Α	TITUS	SURFACE	SUPPLY	GRILLE	272RL	16×6	□ВД	0.1	30	WHITE	
В	TITUS	SURFACE	SUPPLY	GRILLE	272RL	8×6	□BD	0.1	30	WHITE	
С	TITUS	SURFACE	RETURN	GRILLE	50F	24×16	□ВД	0.1	30	WHITE	
D	TITUS	SURFACE	RETURN	GRILLE	23RL	16×16	□ВД	0.1	30	WHITE	
Ε	TITUS	SURFACE	RETURN	GRILLE	23RL	10×10	□BD	0.1	30	WHITE	
F	NOT USED										
G	KRUEGER	SURFACE	SUPPLY	NOZZLE	RPN	10"	APERTURE	0.1	30	WHITE	

LOUVER	SCHEDULE										
					FREE			SIZE	•		MECH
MARK	MANUFACTURER	QUANTITY	MODEL	MAX PD	AREA	CFM	FINISH	W	Н	D NO.	ES
				(IN WG)							
L#1	POTTORFF	1	EFD-445	0.10	_	500	NOTE 1	18	18	4	1,2
L#2	POTTORFF	1	EFD-445	0.10	_	150	NOTE 1	12	12	4	1,2
L#3	POTTORFF	2	EFD-445	0.10	-	200	NOTE 1	12	18	4	1,2

MECHANICAL NOTES:

1. PROVIDE KYNAR FINISH. COLOR SELECTED BY ARCHITECT. 2. PROVIDE LOUVER WITH BIRD SCREEN.

WATER	HEATER -	ELECTRIC	SCHEDULE											
					TANK	HEATER DATA							TANK	MECH
MARK	LOCATION	QUANTITY	MANUFACTURER	MODEL #	CAPACITY (GAL)	RECOVERY (GPH)	EWT (°F)	LWT (°F)	ELEMENTS (NO/W)	FLA	AMPS	V/P	DIM (DIAxH)	NOTES
WH#1B	_	2	STIEBEL ELTRON	DHC 3-1	_	_	40	_	1/3000	1	25	120/1	-	2
WH#1C	110	1	STIEBEL ELTRON	DHC 5-2	-	_	40	-	1/4800	-	20	120/1	-	3
WH#2	108	1	A.O. SMITH	DEL-20	26	24	40	120	1/5000	25	_	240/1	22x22	1
													·	

MECHANICAL NOTES:

1. PROVIDE WITH A.O. SMITH PMC-2 EXPANSION TANK.


2. TANKLESS WATER HEATER WITH 41 DEG TEMP RISE AT .5 GPM. MINIMUM .40 GPM FLOW 3. TANKLESS WATER HEATER WITH 65 DEG TEMP RISE AT .5 GPM. MINIMUM .42 GPM FLOW

	5 FIXTURE SCHEDULE	LOCAL CON	INECTIONS				
MARK	FIXTURE	WASTE	VENT	C.W.	H.W.	HEIGHT	MECH NOTES
LAV-2	LAVATORY/WALL/SENSOR FAUCET/ADA	1-1/4"	1-1/4"	1/2*	1/2"	CTR	1
WC-1	WATER CLOSET/FLOOR/SENSOR FLUSH VALVE/ADA	4"	2"	1-1/2"	-	17"	
MB-1	JANITOR'S SINK/FLOOR	2*	1-1/2"	1/2"	1/2"	FLR	3
S-1	SINGLE COMP. SINK/STAINLESS STEEL/FAUCET	1-1/2"	1-1/2"	1/2"	1/2"	CTR	2
EWC-1	DUAL HEIGHT ELECTRIC WATER COOLER/WALL/ADA	1-1/4"	1-1/4"	1/2"	_	MFR	

MECHANICAL NOTES: TRAP AND SUPPLY WRAP

2. COUNTER BY OTHERS - COORDINATE CLEARANCE SIZE AND ROUGH-IN ELEVATION


3. 4ft. HOSE AND MOP RACK

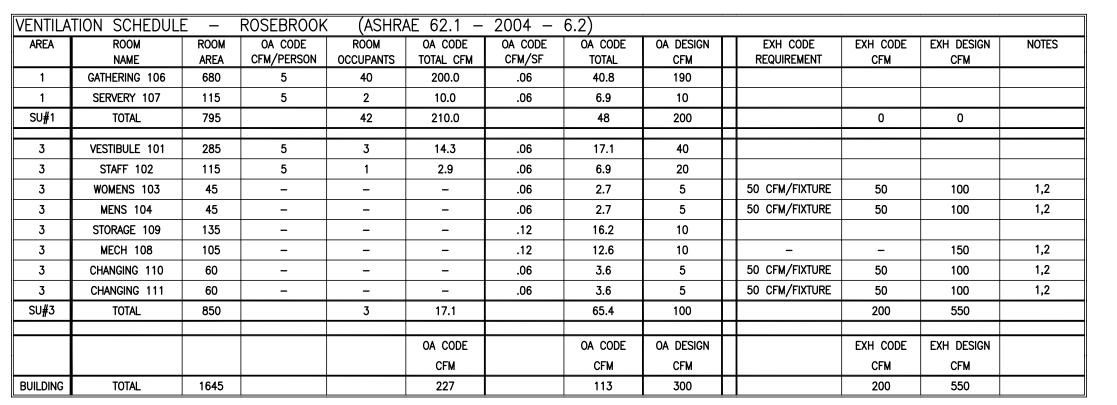

MECHANICAL NOTES:


AIR DIFFUSER-

MINNESOTA RULES CHAPTER 1346.0501, SECTION 501.3 - DOES NOT APPLY, EXHAUST EXCEED SUPPLY. MINNESOTA RULES CHAPTER 1346.0501, SECTION 501.3.2 - MAKE-UP OUTSIDE AIR FOR EXHAUST WILL BE PROVIDED THROUGH THROUGH THE FURNACE WITH OUTSIDE AIR INTAKE AND DOOR UNDERCUT FOR EXTERIOR CHANGING ROOMS.

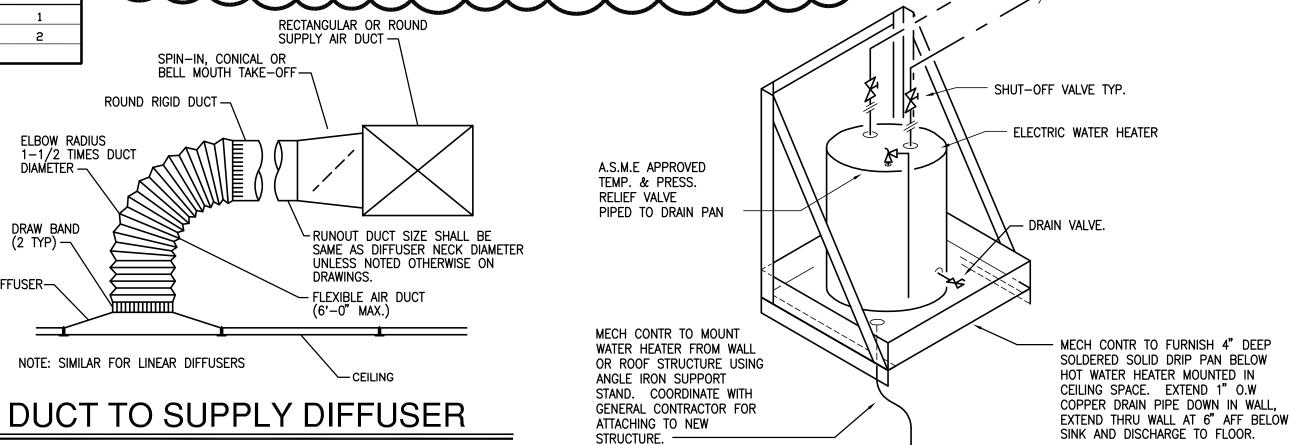

4" METER →


WATER HEATER DETAIL

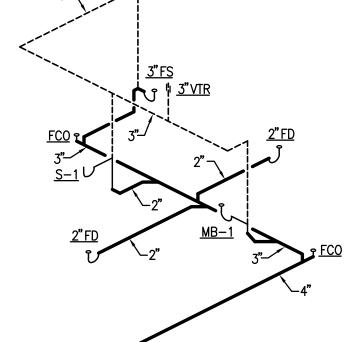

SEE PLUMBING FIXTURE SCHEDULE FOR ADDITION PIPE AND FIXTURE CONNECTION SIZES.

PLUMBING RISER DIAGRAMS ARE FOR REFERENCE OF GENERAL PIPE ROUTING AND PIPE SIZES AND ARE NOT FOR ACTUAL PIPING INSTALLATION. ALL PIPING SHALL BE INSTALLED PER CODE.

PROVIDE WATER HAMMER ARRESTORS ON ALL FLUSH VALVE AND SENSOR OPERATED FIXTURES. SIZE AND INSTALL PER MANUFACTURERS INSTRUCTIONS.

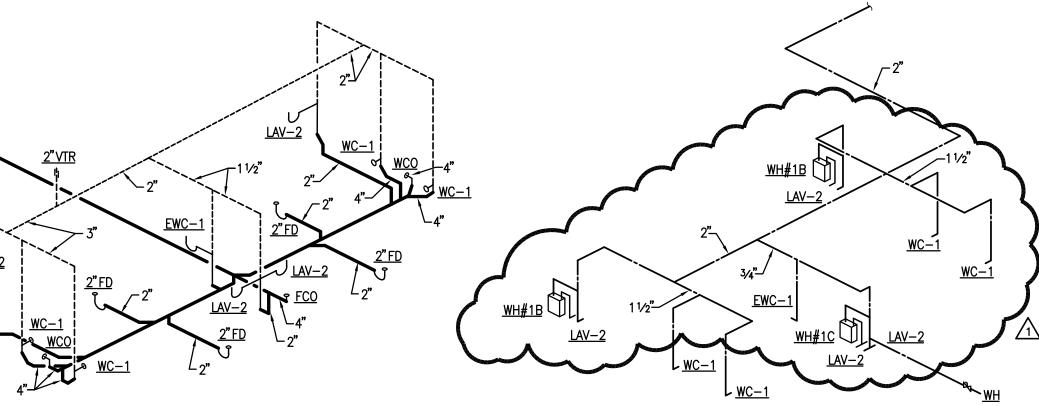

PLUMBING RISER DIAGRAMS

SCALE: NONE



ROSEVILLE PARKS & RECREATION

2660 CIVIC CENTER DRIVE **ROSEVILLE, MINNESOTA 55113**



PERFORMANCE DRIVEN DESIGN.

250 3rd Ave. N, Ste 450 | Minneapolis, MN 55401 | 612.338.2029



DATE: 01/21/2014

RPZ BACKFLOW PREVENTER

-BLOW OUT VALVE

CAP FOR FUTURE IRRIGATION
11/2" WATER METER AND

BACKFLOW PREVENTER

emanuelson-podas consulting engineers 10401 Bren Road East Minnetonka, MN 55343 ph: 952-930-0050 fax: 952-930-0777 www.epinc.net

REG. NO.: 40918

I hereby certify that this drawing was prepared by me or under my direct supervision and that I am a duly registered architect under the laws o the State of Minnesota.

BY: Scott A. Vander Heiden TITLE: ENGINEER

5 6/10/2014 CONSTRUCTION SET 4 05/16/2014 REISSUE 1/21/2014 PROPOSAL 2 12/20/2013 90% REVIEW SET 11/19/2013 CC PACKET DATE ISSUED FOR

07/24/2014 ASI #1 DATE REVISION

COPYRIGHT 2014 BY LHB, INC. ALL RIGHTS RESERVED


PROJECT NAME: ROSEVILLE PARK AND RECREATION RENEWAL PROGRAM

ROSEBROOK PARK 2590 FRY STREET ROSEVILLE, MINNESOTA 55113

DRAWING TITLE: MECHANICAL DETAILS, SCHEDULES AND RISERS

FILE: DRAWN BY: BR CHECKED BY: SVH PROJ. NO: s\3587 DRAWING NO:

RO-m3.1

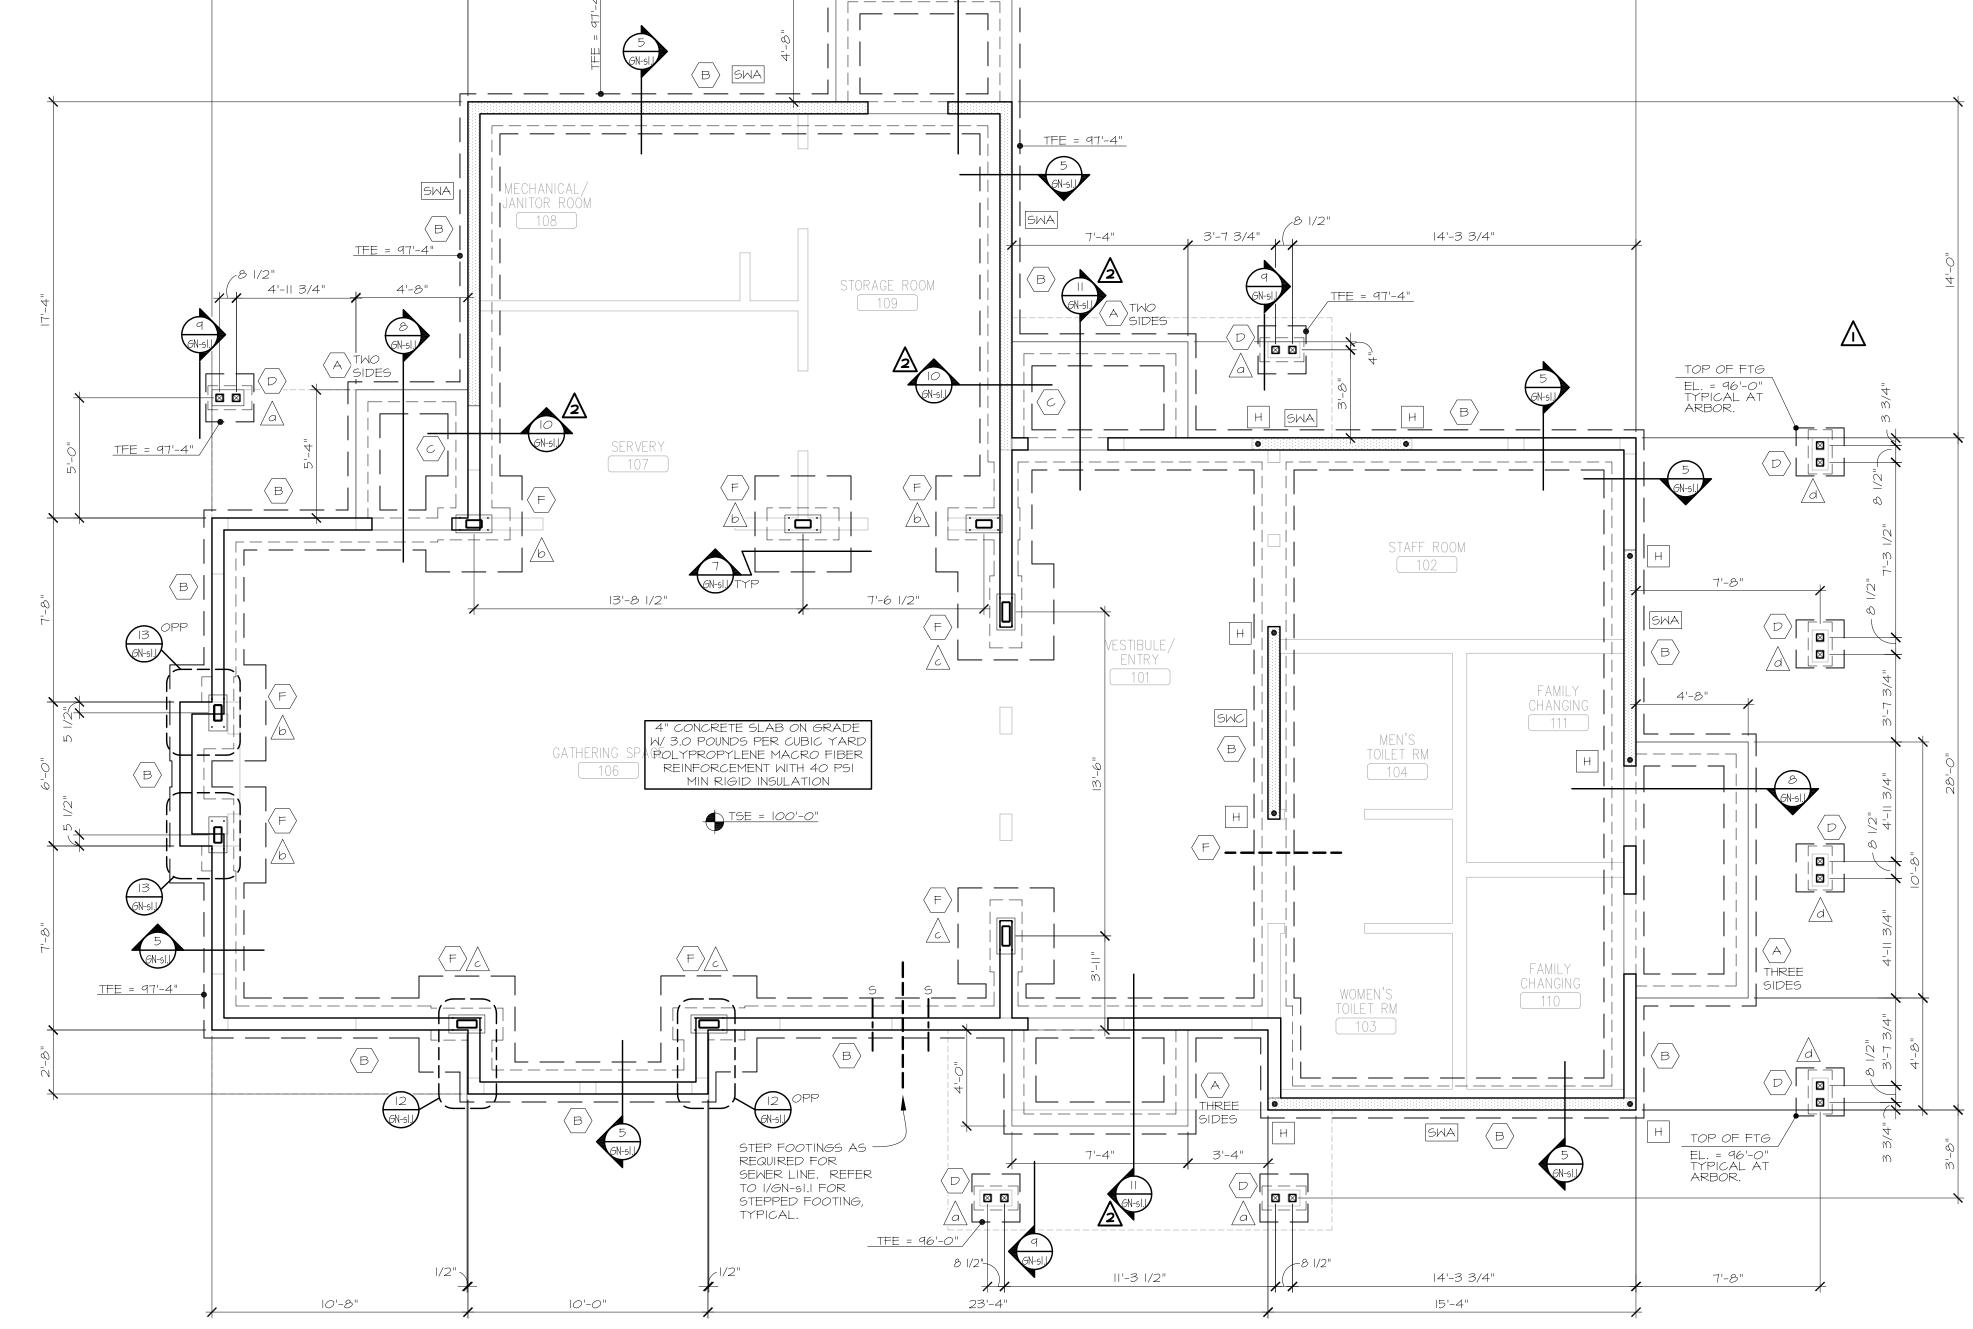

	FOOTING SCHEDULE (-)				
MARK	SIZE	REINFORCEMENT			
А	16" × 12" THICK CONTINUOUS	2 - #5 CONTINUOUS			
В	20" x I2" THICK CONTINUOUS	2 - #5 CONTINUOUS			
C	26" × I2" THICK CONTINUOUS	2 - #5 CONTINUOUS			
D	2'-0" × 2'-0" × 12" THICK	2 - #5 x 1'-6" EACH WAY BOTTOM			
E	3'-0" × 3'-0" × 12" THICK	3 - #5 x 2'-0" EACH WAY BOTTOM			
F	4'-0" × 4'-0" × 12" THICK	4 - #5 x 2'-6" EACH WAY BOTTOM			

	COLUMN S	5CHEDUL	E /-\	
MARK	SIZE	BASE PLATE	NOTES	_
а	DBL 4 × 4 WOOD POST	-	SEE DETAIL 9&14/GN-s1.1	
Ь	H558 x 4 x 3/8	/8" × 8" × 2'-0"	SEE DETAIL 7/GN-s1.l	
С	HSSIO × 4 × 3/8	/8" × 8" × 2'-2"	SEE DETAIL 7/GN-sl.l	
D	DOUBLE 6 × 6 WOOD POST		SEE DETAIL 9 & 14/GN-sl.I (SIM)	

	SHEAR WALL SCHEDULE																	
		BLOCK	BLOCK INTERIOR FACE/FIRST FACE					EXTERIOR FACE/SECOND FACE					END					
	1ARK	HORIZ JOINTS	SHEATHING	THICKNESS	NAIL SIZE	BASE	SPAC E PLY		THICKNESS NAIL SIZE		SPACING BASE PLY FACE PLY		PLY	POST MINIMUM				
					3122	EDGE	FIELD	EDGE	FIELD			3.22	EDGE	FIELD	EDGE	FIELD	NUMBER	SIZE
	SWA	NO	GYPB0ARD	5/8"	6d COOLER	7	7			PLYW00D	15/32"	8d X 2 1/2"	6	12			2	2 x
	SMB	NO	GYPB0ARD	5/8"	6d COOLER	7	7			PLYW00D	15/32"	8d X 2 1/2"	6	12			3	2 x
	SMC	YES	GYPB0ARD	5/8"	6d COOLER	4	4		·	GYPB0ARD	5/8"	6d COOLER	4	4			2	2 x

SHEAR WALL NOTES:


- I. ANCHORAGE AND CONNECTION DETAILS ARE PROVIDED TO ENSURE PROPER LOAD TRANSFER TO THE FOUNDATION. WALLS NOT NOTED SHALL BE ANCHORED AS OTHERWISE SPECIFIED IN THESE CONSTRUCTION DRAWINGS/SPECIFICATIONS.
- 2. SEE ARCH FOR WALL SHEATHING/FINISHES.
- 3. WALLS SHOWN THUS: " INDICATE SHEAR WALLS.
- 4. " H " DENOTES SHEAR WALL HOLDOWN LOCATION. PROVIDE SIMPSON HDU4-SDS2.5 HOLDOWN AND SB5/8x24 EACH END OF SHEAR WALL.
- 5. SILL PLATE ATTACHMENT AT SHEAR WALLS PER STRUCTURAL NOTES.

FOOTING AND FOUNDATION PLAN

22'-8"

7'-4"

A THREE SIDES

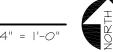

26'-0"

UNLESS NOTED OTHERWISE:

10'-8"

- I. SEE DETAILS 2/GN-sI.I AND 3/GN-sI.I FOR TYPICAL SLAB ON GRADE JOINTS.
- 2. SEE ARCHITECTURAL DRAWINGS FOR SLOPED SLABS AND FLOOR DRAINS.
- 3. MAINTAIN MINIMUM OF 42" COVER (FINAL GRADE ELEVATION TO BOTTOM OF FOOTING) AT ALL EXTERIOR WALL FOOTINGS. STEP FOOTINGS AS NECESSARY TO MAINTAIN COVER AND TO CLEAR UNDERGROUND UTILITIES/SLOPED SLABS. SEE DETAIL I/GN-sI.I FOR TYPICAL STEPPED FOOTING.
- 4. SEE 4/GN-sI.I FOR TYPICAL UNDERGROUND PIPING EXCAVATION.
- 5. CMU WALL REINFORCING SHALL BE AS FOLLOWS:

 12" CMU: #5 VERT AND DOWELS @ 48" OC, CENTERED IN WALL.

 8" CMU: #5 VERT AND DOWELS @ 48" OC, CENTERED IN WALL.

 6" CMU: #5 VERT AND DOWELS @ 48" OC, CENTERED IN WALL.

SOIL PREPARATION:
FOLLOW SOIL CORRECTION PROCEDURES
DESCRIBED IN THE GEOTECHNICAL REPORT
TO OBTAIN DESIGN BEARING PRESSURES
STATED IN THE STRUCTURAL NOTES.



ROSEVILLE PARKS & RECREATION

2660 CIVIC CENTER DRIVE ROSEVILLE, MINNESOTA 55113



250 3rd Ave. N, Ste 450 | Minneapolis, MN 55401 | 612.338.2029



HAGEN, CHRISTENSEN & MCILWAIN

4201 CEDAR AVENUE SO. • MINNEAPOLIS, MN 55407 TEL. (612)904-1332 • FAX (612)904-7366

I hereby certify that this drawing was prepared by me or under my direct supervision and that I am a duly Licensed Professional Engineer under the laws of the State of Minnesota.

SIGNATURE: Michael E. Manor TITLE: ENGINEER

DATE: 01/21/14 REG. NO.: 45797

Mattson Macdonald Young structural engineers

		Minneapolis, MN 55401 612-827-7825 voice 612-827-0805 fax
3	06/10/2014	CONSTRUCTION SET
2	01/21/2014	BID
1	12/20/2013	90% REVIEW SET
NO	DATE	ISSUED FOR

2	02/11/2014	ADDENDUM NO. 2
\triangle	02/11/2014	ADDENDUM NO. 1
NO	DATE	REVISION

COPYRIGHT 2014 BY LHB, INC. ALL RIGHTS RESERVED.

ROSEVILLE PARK AND RECREATION RENEWAL PROGRAM

ROSEBROOK PARK

DRAWING TITLE:
FOOTING AND FOUNDATION PLAN

BEAM	/HEADER SCHEDULE (-)
MARK	SIZE
А	2 - 2 × 6
В	2 - 2 × 8
C	3 - 2 × 8
D	2 - 2 × 10
E	3 - 2 × 10
F	2 - 2 × I2
6	3 - 2 × I2
Н	2 - 3/4 × 7 /4 LVL
J	3 - 3/4 × 7 /4 LVL
K	2 - 3/4 × 9 /4 LVL
L	3 - 3/4 × 9 /4 LVL
М	4 - 3/4 × 9 /4 LVL
N	2 - 3/4 × 7/8 LVL
Р	3 - 3/4 × 7/8 LVL
Q	4 - 3/4 × 7/8 LVL
R	2 - I 3/4 x I4 LVL
S	3 - I 3/4 × I4 LVL
Т	4 - 3/4 × 4 LVL
U	2 - 3/4 × 6 LVL
V	3 - I 3/4 × I6 LVL
M	4 - I 3/4 × I6 LVL
×	2 - I 3/4 × I8 LVL
Y	3 - I 3/4 × I8 LVL
Z	4 - I 3/4 × I8 LVL
AA	3 - 2 × 6

NOTES:

- I. "X" INDICATES "FLUSH" BEAM/HEADER (TOP OF BEAM = TOP OF JOIST OR BOTTOM OF BEAM = BOTTOM OF JOIST).
- ELEVATION ON SHEET RO-S2.1 FOR HEADER.
- 3. HEADERS IN INTERIOR NON-LOAD BEARING WALLS ARE NOT INDICATED. FOLLOW SCHEDULE BELOW FOR ALL NON-LOAD BEARING WALL

SPAN	HEADER	MIN NUMBER TRIMMER STUDS
0'-0" T0 6'-0"	2 - 2 × 4	- 2 x
> 6'-0" T0 8'-0"	2 - 2 × 6	- 2 x
> 8'-0" T0 10'-0"	2 - 2 × 8	- 2 x
> 10'-0" T0 12'-0"	2 - 2 × 10	2 - 2 x


PROVIDE THE FOLLOWING MINIMUM NUMBER OF


KING STUDS AS FOLLOWS. INTERIOR OPENINGS: SPAN 0'-0" TO 6'-0" I - KING STUD

SPAN > 6'-0" TO 12'-0"

EXTERIOR OPENINGS: SPAN 0'-0" TO 6'-0" I - KING STUD SPAN > 6'-0" TO 8'-0" 2 - KING STUDS SPAN > 8'-0" TO 10'-0" 2 - KING STUDS

2 - KING STUDS

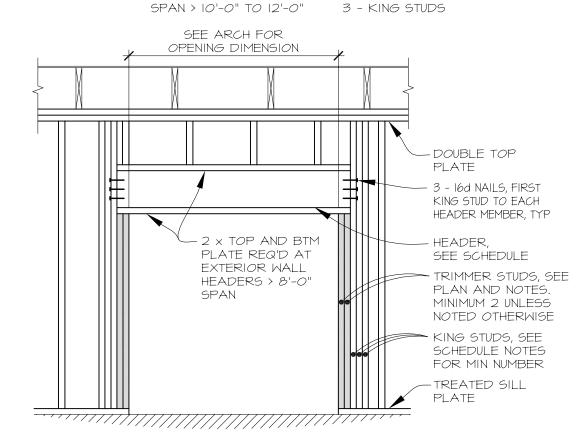


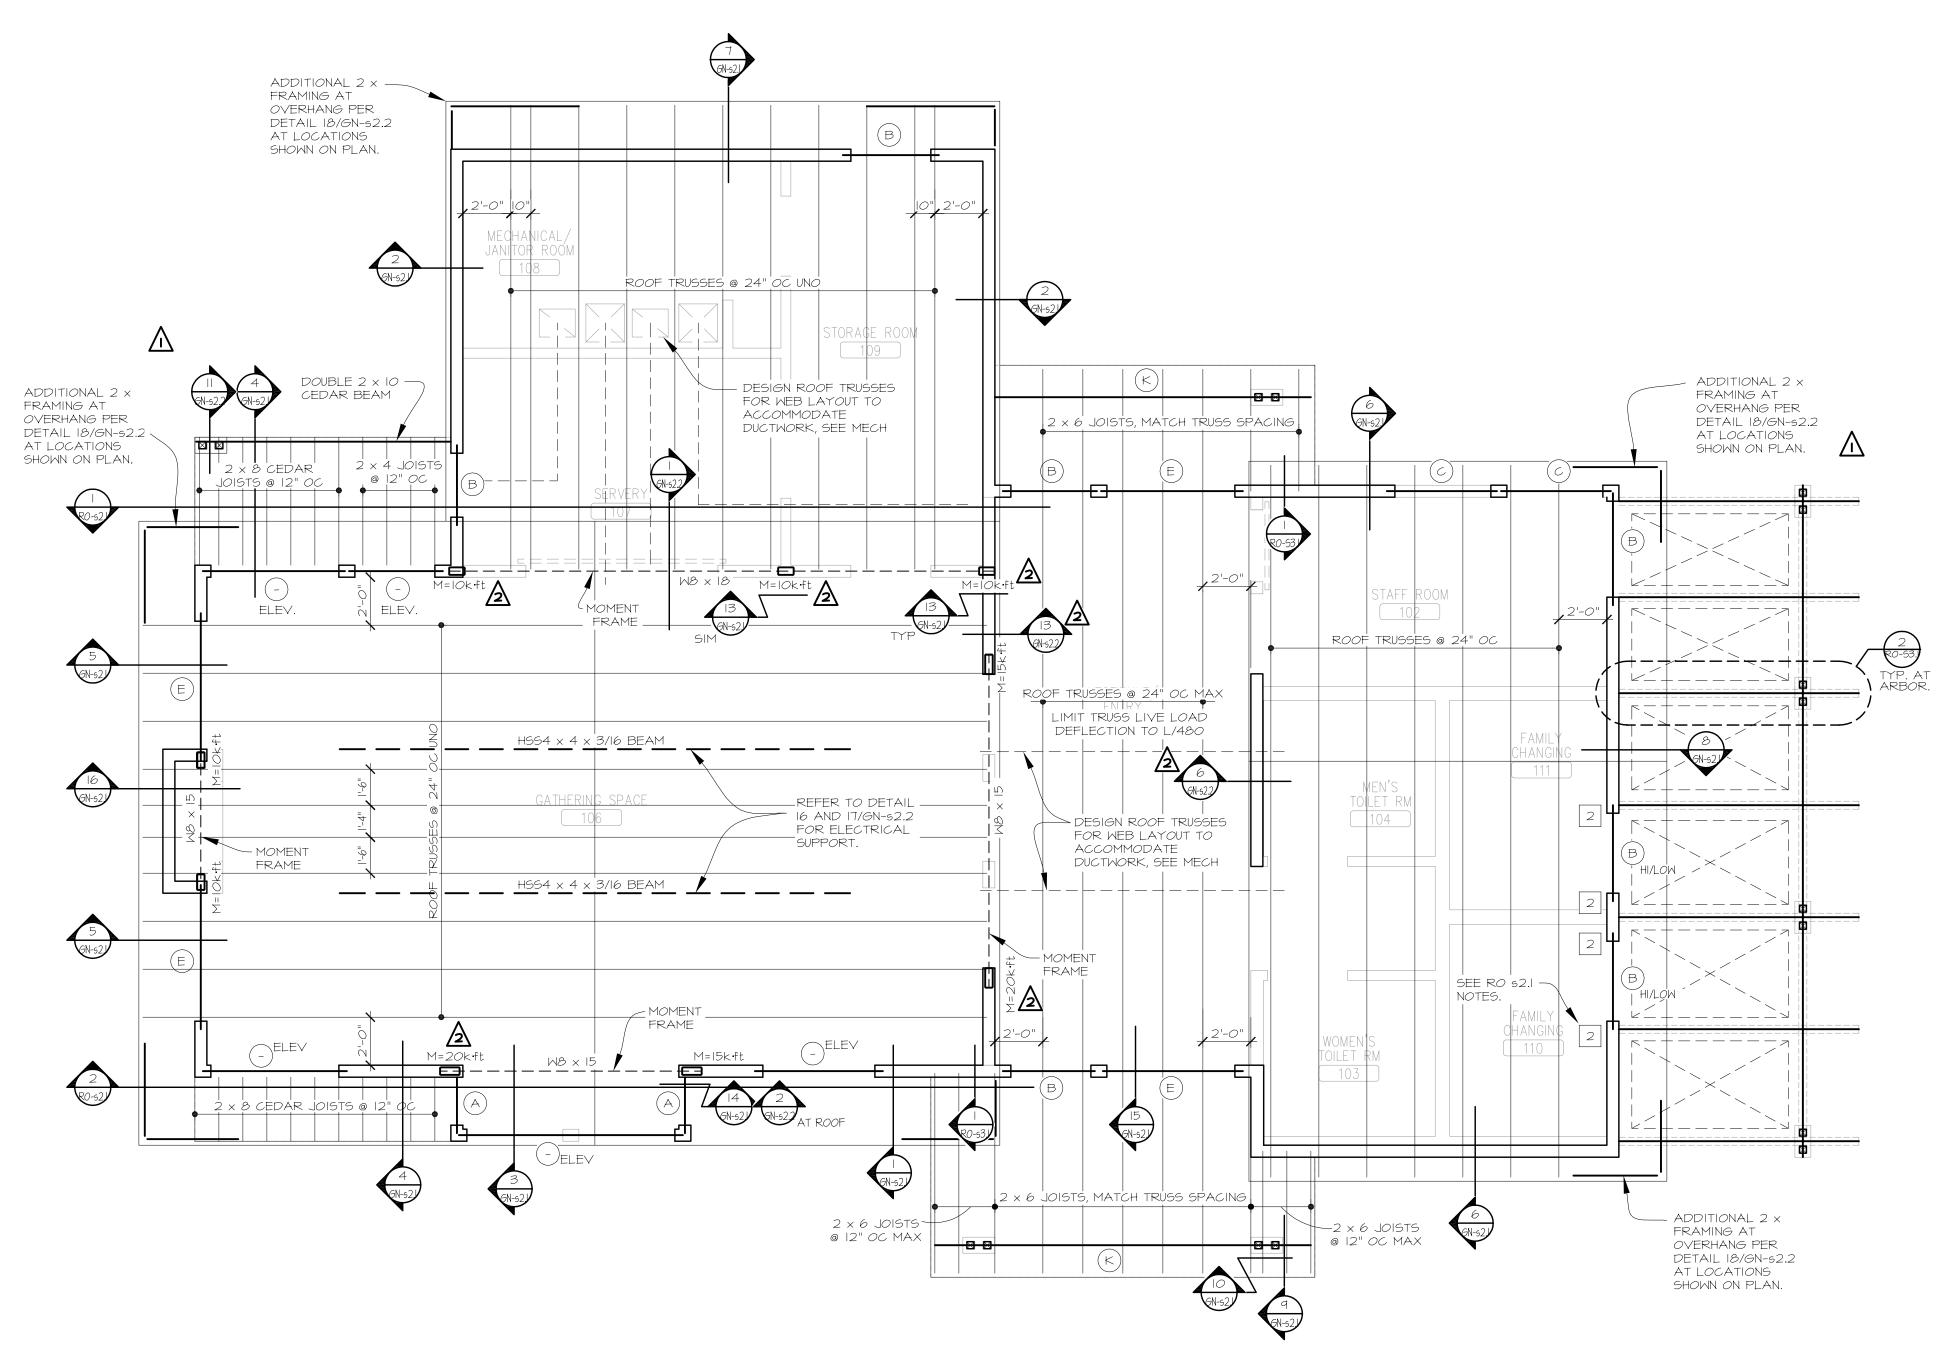



UNLESS NOTED OTHERWISE:

- I. PREFABRICATED WOOD ROOF TRUSSES @ 24" OC. ANCHOR EACH TRUSS TO DOUBLE TOP PLATE W/ I SIMPSON H2.5 HURRICANE ANCHOR (OR EQUAL) AT EACH BEARING LOCATION. SEE ARCHITECTURAL DRAWINGS FOR ROOF SLOPES.
- 2. TRUSS SUPPLIER SHALL PROVIDE ALL HANGERS NECESSARY FOR TRUSS-TO-TRUSS CONNECTIONS.
- 3. MARKS THUS " ----- " INDICATE STEEL MOMENT FRAME. BEAM TO COLUMN CONNECTIONS BY FABRICATOR. SERVICE LOADS ARE SHOWN ON PLAN THUS: M=XXk+ft $\bigvee = X \times k$
- 4. MARKS THUS: " $\frac{3}{3}$ " INDICATE NUMBER OF STUDS REQUIRED FOR BEARING. IF NUMBER NOT SHOWN, PROVIDE MINIMUM OF 2 STUDS (3" LENGTH OF BEARING). FULL WIDTH OF BEAM/HEADER/GIRDER TRUSS MUST BE SUPPORTED.
- 5. MARKS THUS: "/a\" INDICATE COLUMN REQUIRED FOR BEARING. SEE COLUMN SCHEDULE FOR ADDITIONAL INFORMATION.
- 6. ROOF SHEATHING SHALL BE 5/8" PLYWOOD/OSB (MINIMUM). ATTACH SHEATHING TO ROOF FRAMING MEMBERS W/ IOd NAILS @ 6" OC AT PANEL EDGES AND @ 12" OC AT INTERMEDIATE SUPPORTS.
- 7. EXTERIOR WALLS AND CORRIDOR WALLS SHALL BE 2 \times 6 STUDS @ 16" OC UP TO 12'-0". STUDS TALLER THAN 12'-0" SHALL BE 1 3/4" \times 5 1/2" LSL @ 16" OC. ADDITIONAL INTERIOR BEARING WALLS SHALL BE 2 \times 6 STUDS @ 16" OC. SEE ARCHITECTURAL DRAWINGS FOR ADDITIONAL INFORMATION REGARDING WALL TYPES.

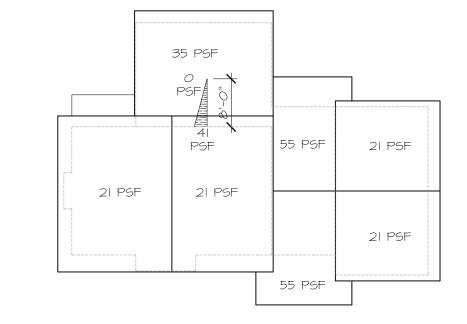



1/16" = 1'-0"



ROSEVILLE PARKS & RECREATION

2660 CIVIC CENTER DRIVE ROSEVILLE, MINNESOTA 55113



250 3rd Ave. N, Ste 450 | Minneapolis, MN 55401 | 612.338.2029




HAGEN, CHRISTENSEN & MCILWAIN ARCHITECTS

4201 CEDAR AVENUE SO. • MINNEAPOLIS, MN 55407 TEL. (612)904-1332 • FAX (612)904-7366

I hereby certify that this drawing was prepared by me or under my direct supervision and that I am a duly Licensed Professional Engineer under the laws of the State of Minnesota.

BY: Michael E. Manor TITLE: ENGINEER DATE: 01/21/14 REG. NO.: 45797

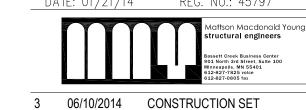

2	01/21/2014	BID
1	12/20/2013	90% REVIEW SET
NO	DATE	ISSUED FOR

2	02/11/2014	ADDENDUM NO. 2	
	02/11/2014	ADDENDUM NO. 1	
NO	DATE	REVISION	


COPYRIGHT 2014 BY LHB, INC. ALL RIGHTS RESERVED.

PROJECT NAME: ROSEVILLE PARK AND RECREATION RENEWAL PROGRAM

ROSEBROOK PARK

DRAWING TITLE: ROOF FRAMING PLAN

FILE: P:\CURRENT JOBS\2013\13487 DRAWN BY: ZAM CHECKED BY: MEM DRAWING NO:

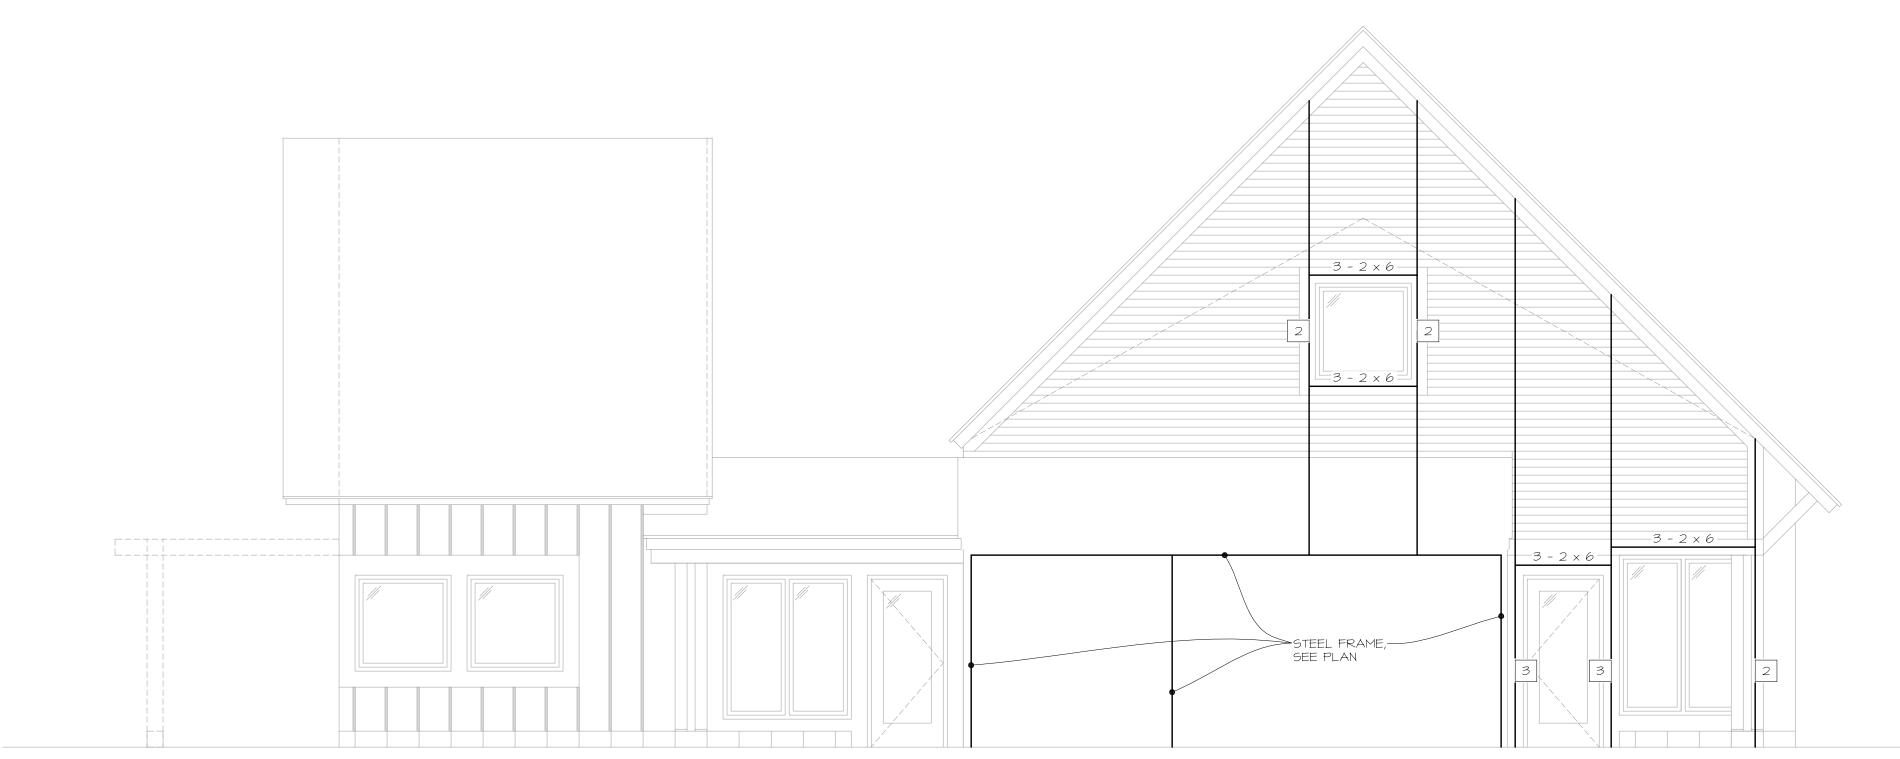



UNLESS NOTED OTHERWISE:

4. NOT USED.

@ 16" OC.

AND SILL PLATES.

I. - = NUMBER OF KING STUDS. JAMBS ARE COMPRISED OF | 3/4" x 5 |/2" LSL PLIES.

3. PROVIDE SIMPSON HUC 28-2 HANGER AT END OF EACH HEADER.

5. ATTACH SILL PLATE TO STEEL BEAM WITH HILTI X-U PINS

7. ATTACH JAMBS WITH 2 - SIMPSON A23 ANGLES AT TOP

IO. MARKS THUS: " \divideontimes " INDICATE BLOCKING W/ STRAPPING, SEE 3/GN-s2.I FOR MORE INFO.


6. MARKS THUS: " — — — " INDICATE FRAMING IN

BUMPED OUT PORTION OF WALL.

8. SEE DETAIL I/GN-s2.I FOR WALL BRACING.

9. SEE ARCH FOR OPENING DIMENSIONS.

2. SEE PLAN FOR SIZE OF WALL STUDS NOT SHOWN.

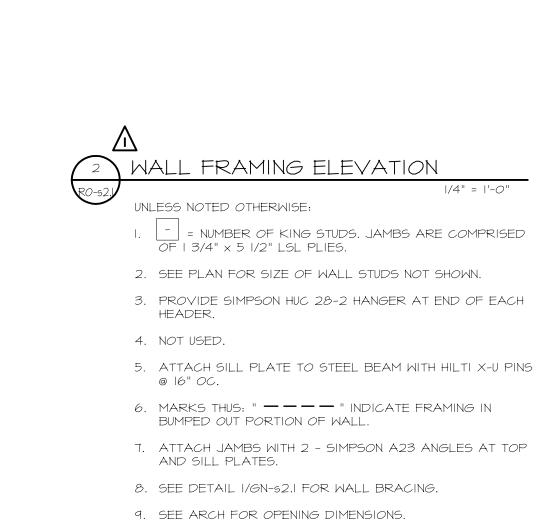

IO. MARKS THUS: " \divideontimes " INDICATE BLOCKING W/ STRAPPING, SEE 3/GN-92.I FOR MORE INFO.



ROSEVILLE PARKS & RECREATION

2660 CIVIC CENTER DRIVE ROSEVILLE, MINNESOTA 55113



250 3rd Ave. N, Ste 450 | Minneapolis, MN 55401 | 612.338.2029



Hagen, Christensen & McIlwain ARCHITECT S

4201 CEDAR AVENUE SO. • MINNEAPOLIS, MN 55407 TEL. (612)904-1332 • FAX (612)904-7366

I hereby certify that this drawing was prepared by me or under my direct supervision and that I am a duly Licensed Professional Engineer under the laws of the State of Minnesota.

BY: Michael E. Manor TITLE: ENGINEER

3 06/10/2014 CONSTRUCTION SET

2 01/21/2014 BID



1	12/20/2013	90% REVIEW SET
NO	DATE	ISSUED FOR

2	02/11/2014	ADDENDUM NO. 2
	02/11/2014	ADDENDUM NO. 1
NO	DATE	REVISION


COPYRIGHT 2014 BY LHB, INC. ALL RIGHTS RESERVED.


PROJECT NAME: ROSEVILLE PARK AND RECREATION RENEWAL PROGRAM


ROSEBROOK 3060 PATTON ROAD ROSEVILLE, MINNESOTA 55113


DRAWING TITLE: WALL FRAMING ELEVATIONS

FILE: P:\CURRENT JOBS\2013\13487 DRAWN BY: ZAM CHECKED BY: MEM PROJ. NO: 13487 DRAWING NO:

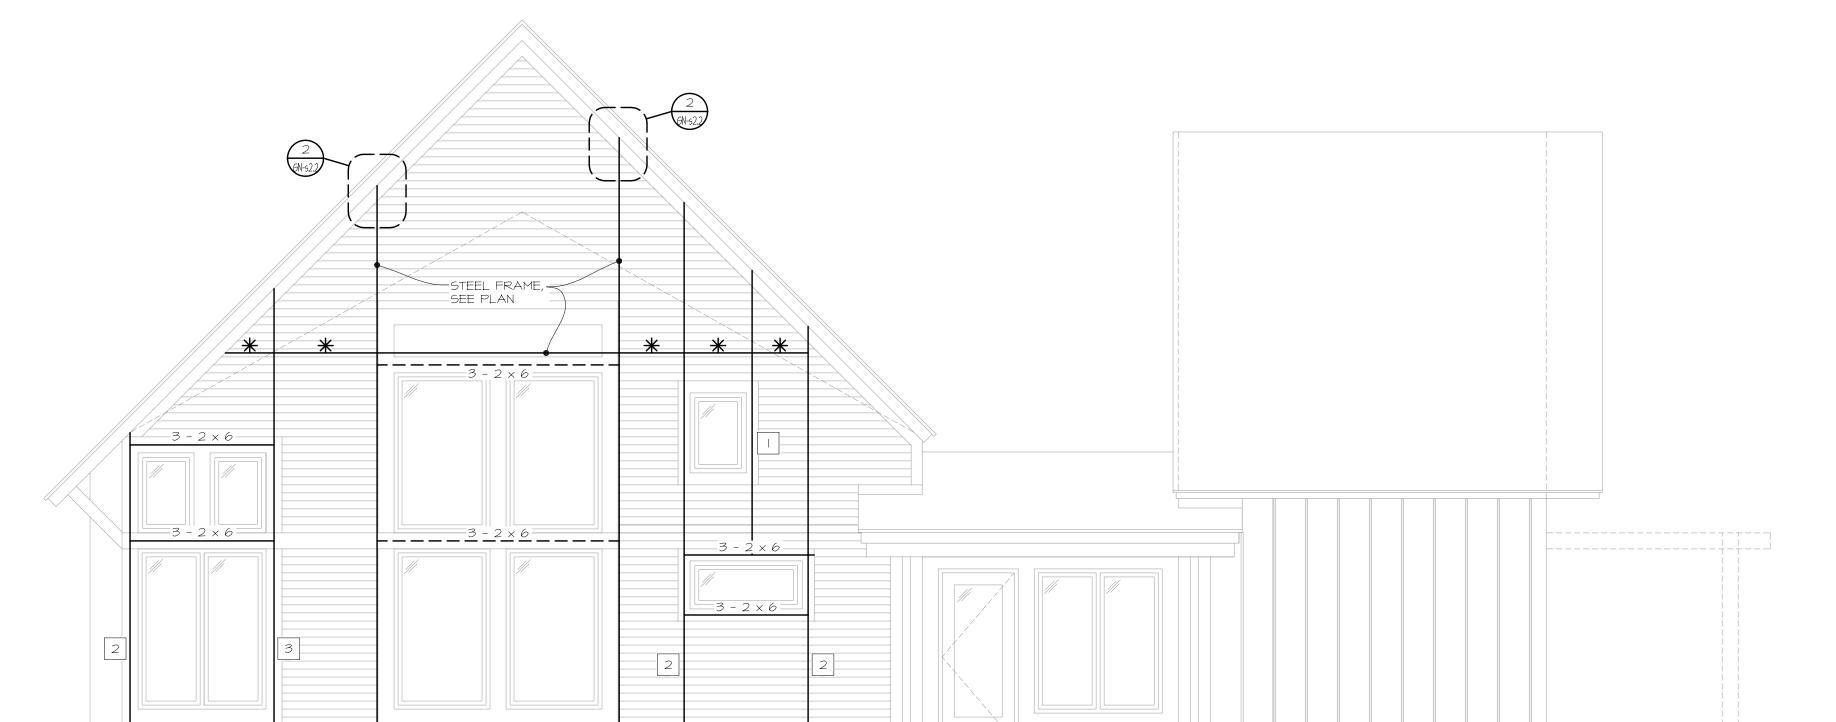

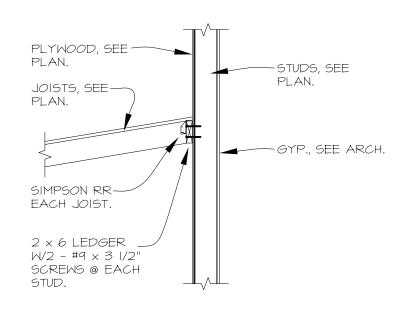

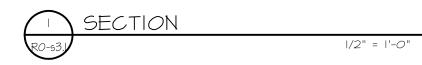

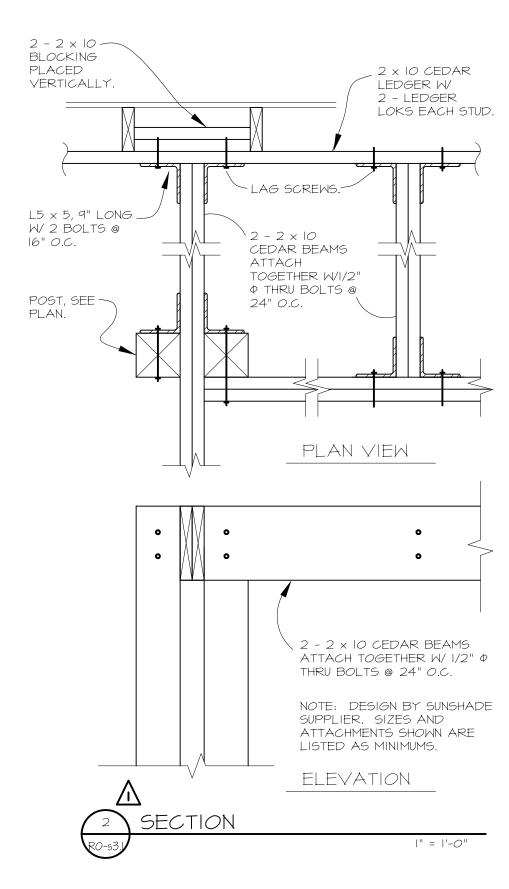



2660 CIVIC CENTER DRIVE ROSEVILLE, MINNESOTA 55113



250 3rd Ave. N, Ste 450 | Minneapolis, MN 55401 | 612.338.2029




AR CHITECT S

4201 CEDAR AVENUE SO. • MINNEAPOLIS, MN 55407 TEL. (612) 904 - 1332 • FAX (612) 904 - 7366

I hereby certify that this drawing was prepared by me or under my direct supervision and that I am a duly Licensed Professional Engineer under the laws of the State of Minnesota.

SIGNATURE: Mahar E Manus

BY: Michael E. Manor TITLE: ENGINEER

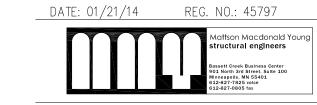

3	06/10/2014	CONSTRUCTION SET	
2	01/21/2014	BID	
1	12/20/2013	90% REVIEW SET	
NO	DATE	ISSUED FOR	

2	02/11/2014	ADDENDUM NO. 2
	02/11/2014	ADDENDUM NO. 1
NO	DATE	REVISION

COPYRIGHT 2014 BY LHB, INC. ALL RIGHTS RESERVED.

ROSEVILLE PARK AND RECREATION RENEWAL PROGRAM

DRAWING TITLE: SECTIONS

FILE: P:\CURRENT JOBS\2013\13487


DRAWN BY: ZAM

CHECKED BY: MEM

PROJ. NO: 13487

DRAWING NO:

RO-S3-

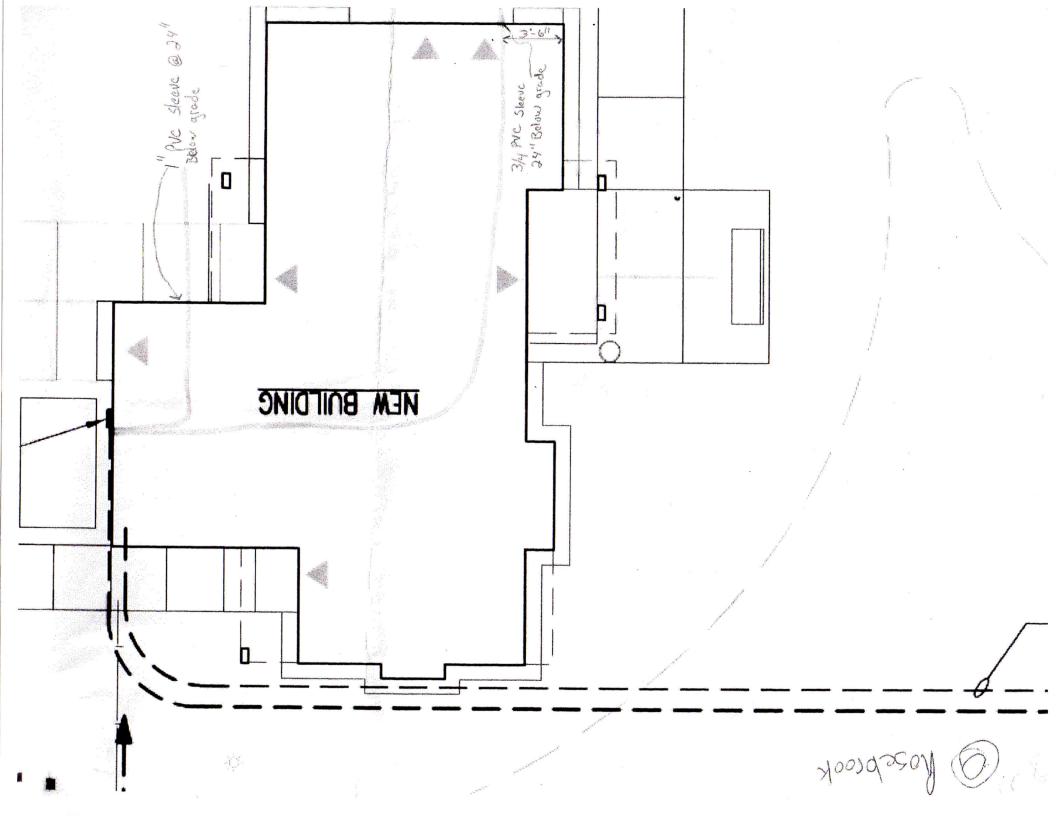

From: Greg Hinrichs ghinrichs@premiercorp.net
Subject: PlanGrid Design Comment - Roseville Parks, R0-e1.0
Date: September 9, 2014 at 8:06 PM

To: icthyholic@gmail.com

Project Name: Roseville Parks Sheet Number: R0-e1.0

Made With PlanGrid (http://www.plangrid.com/)

